
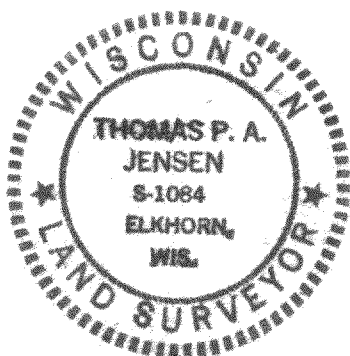


PLAT OF SURVEY of Lots 20, 21, 22, and 23 of Block 23, Second Map of Interlaken, Located in the SE $\frac{1}{4}$ of Section 11, T3N R16E, Walworth County, Wisconsin.

Surveyed for: C. Murray of B.E.S.P. Corp. Elkhorn, Wis.
Dated: July 11, 1977

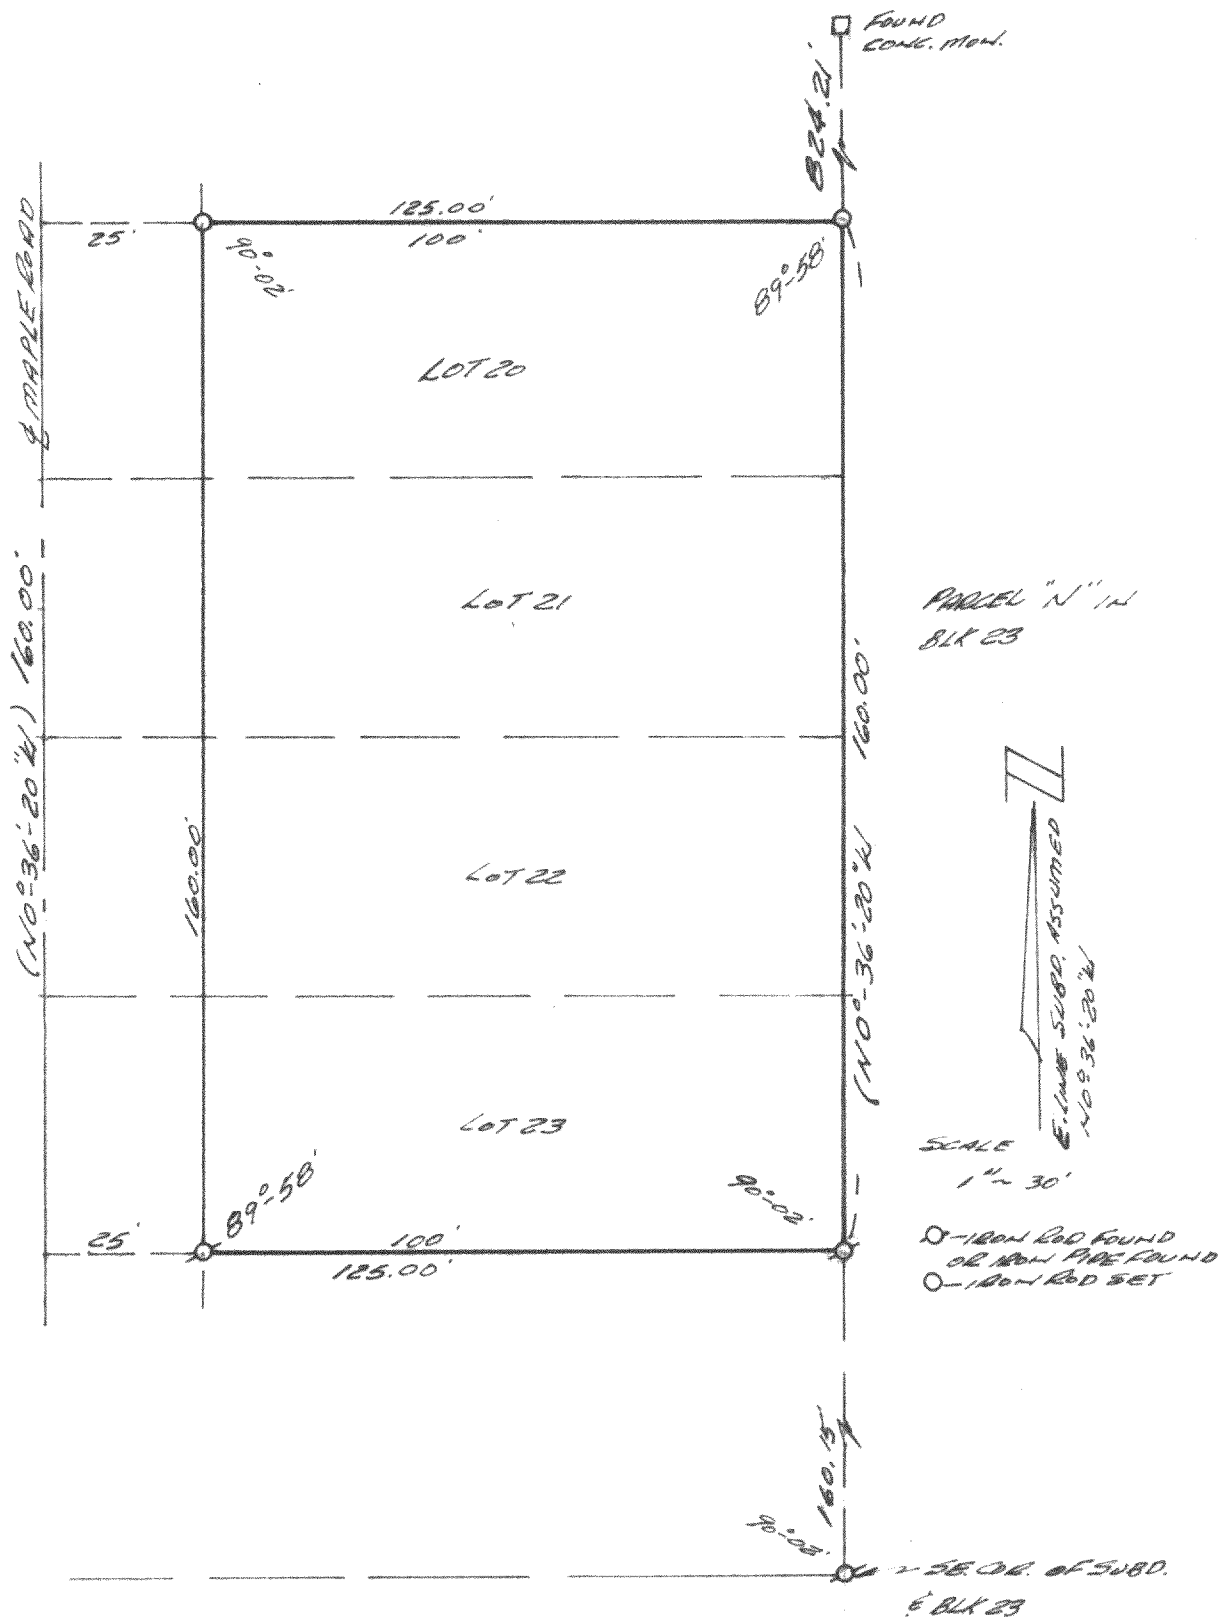

I Certify that I have surveyed the above described land & that the plat shown hereon is an accurate survey & a true representation thereof & correctly shows the exterior boundary lines & all divisions of said property.

Thomas P. A. Jensen
Thomas P. A. Jensen
Elkhorn, Wisconsin

61-260C

316-229