


PREPARED FOR
LYNETTE PHILLIPS
@ PROPERTIES
LAKE GENEVA WI

PLAT OF SURVEY

- OF -

LOTS 5, 6, 25 AND 26 OF BLOCK 69 OF THE FIFTH MAP OF INTERLAKEN
LOCATED IN THE NW 1/4 OF SECTION 14, TOWN 3 NORTH, RANGE 16
EAST, TOWN OF SUGAR CREEK, WALWORTH COUNTY, WISCONSIN.

PATHFINDER SURVEYING INC.
(formerly)
J.K. SURVEYING INC.
P.O BOX 322
LAKE GENEVA, WI. 53147
WWW.PATHFINDERSURVEYING.NET
262-248-8303

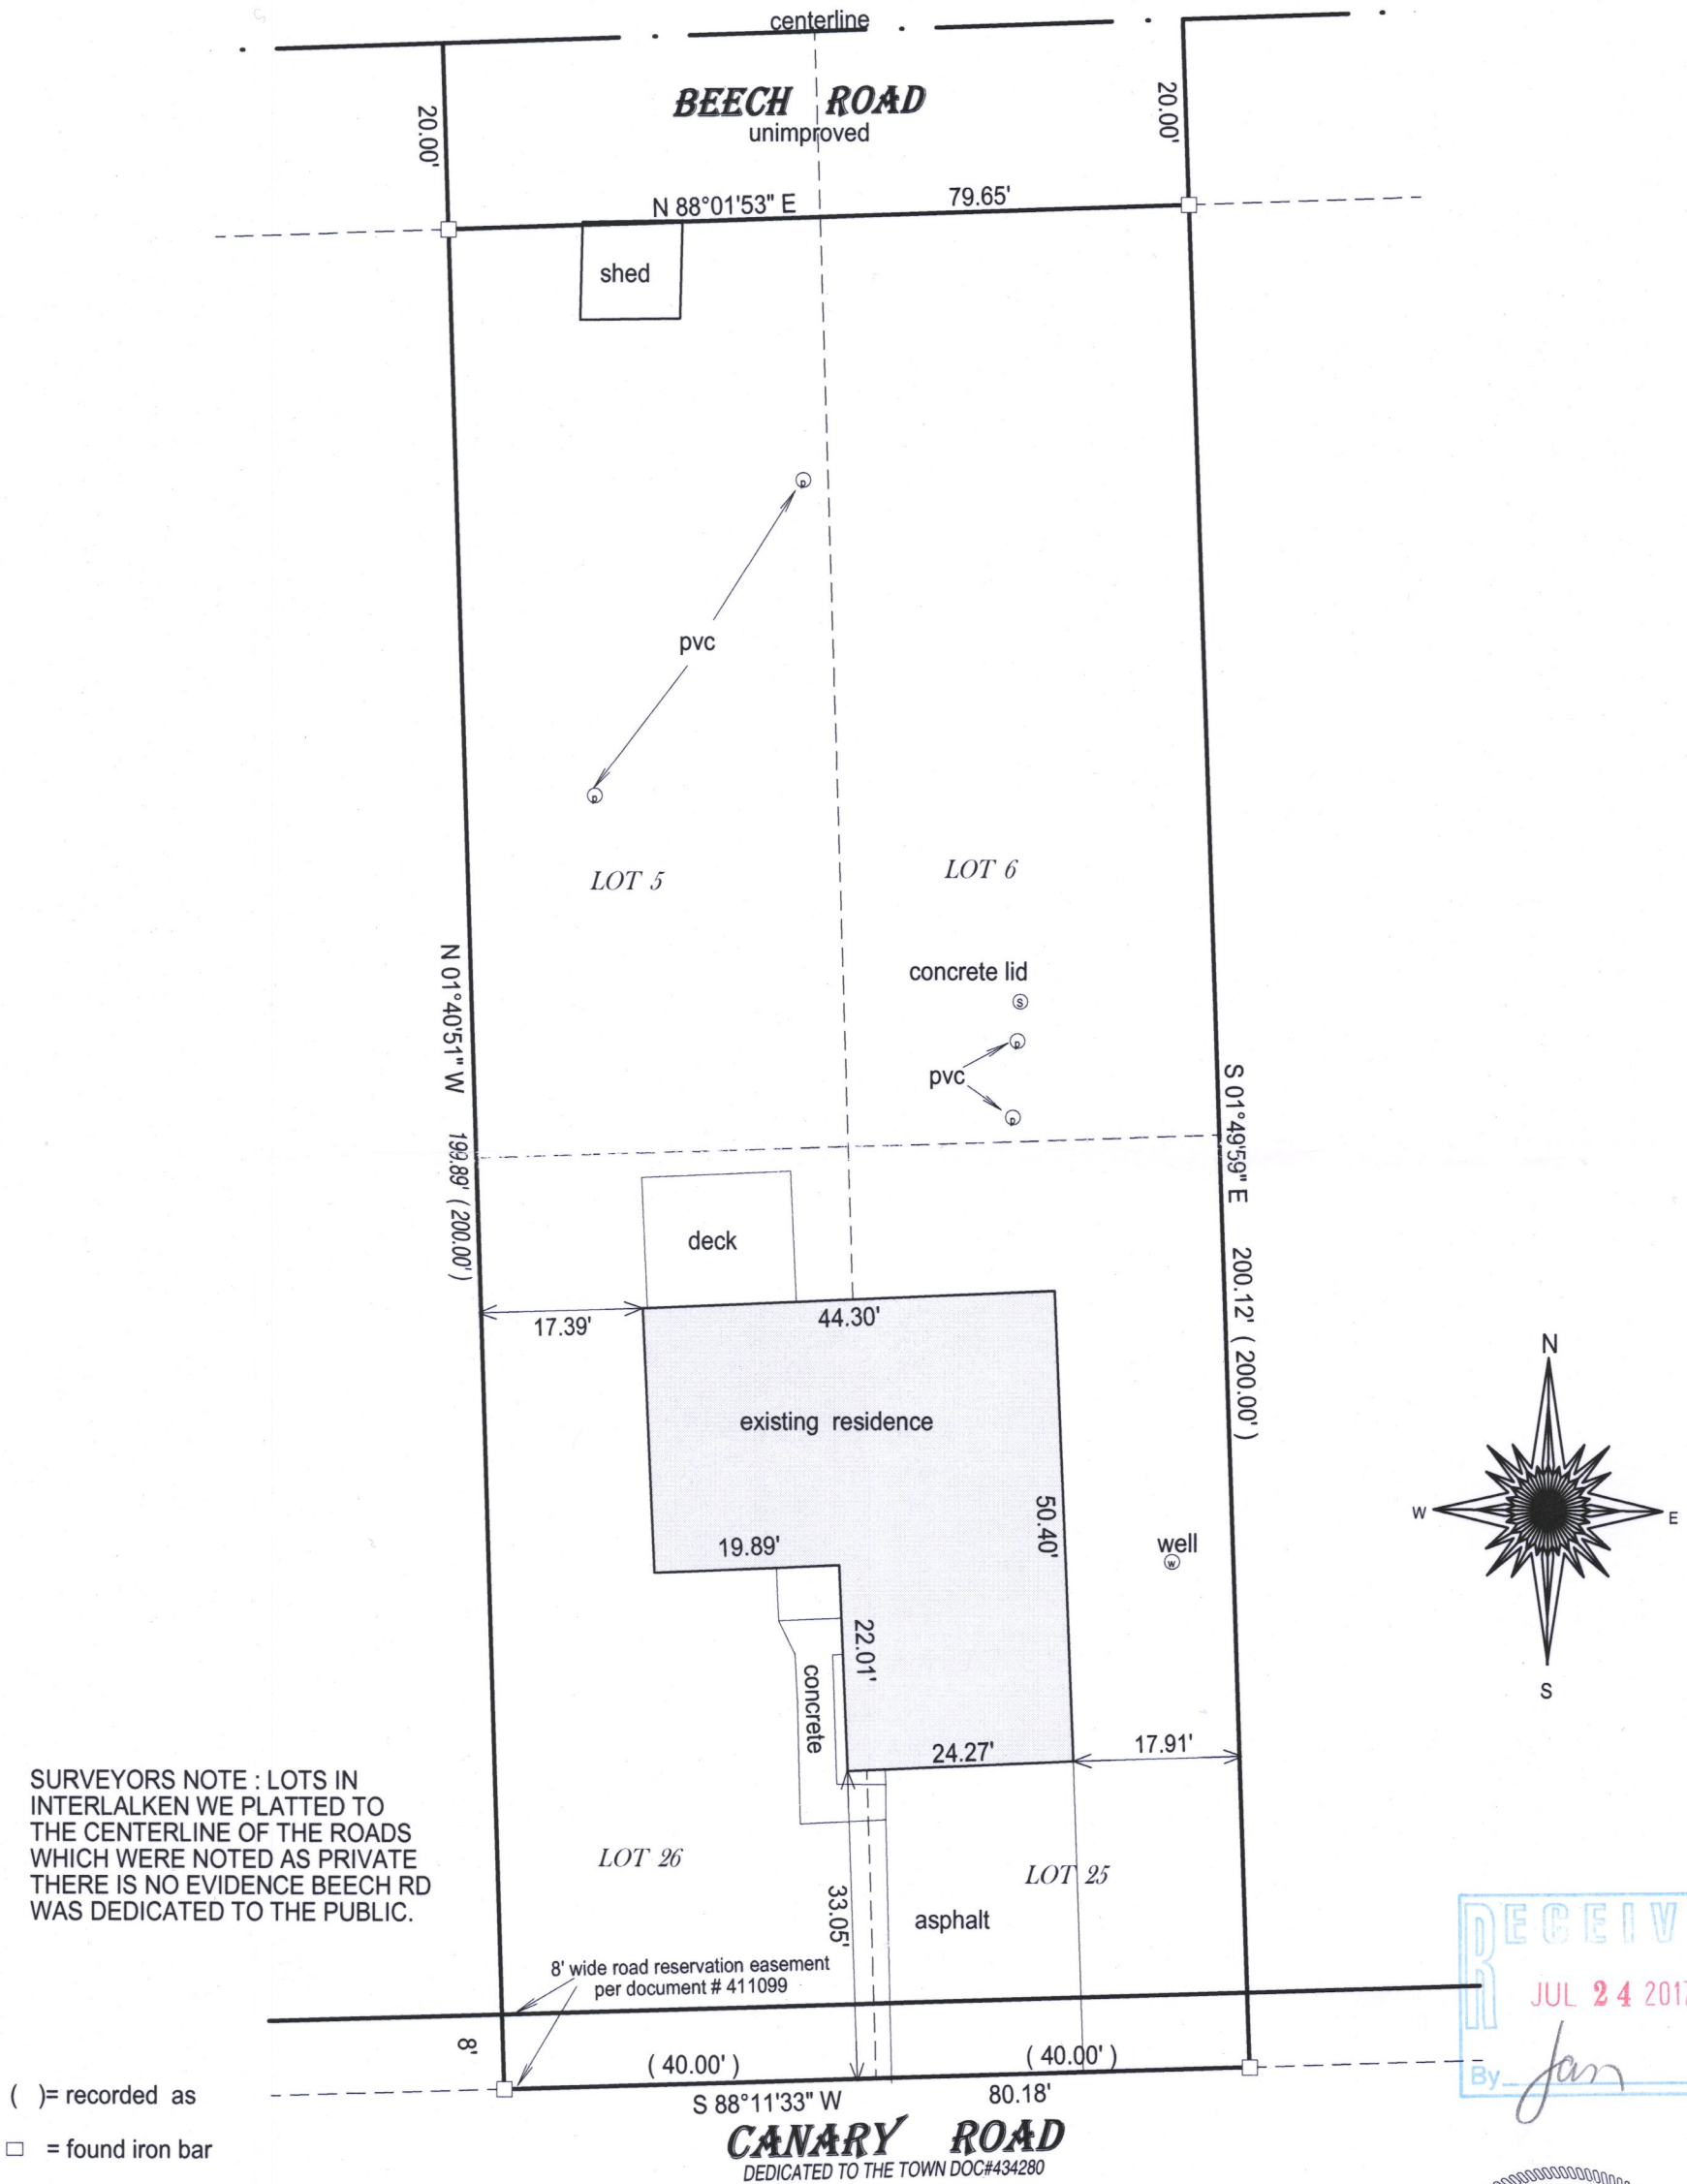

SURVEYORS NOTE : LOTS IN
INTERLAKEN WE PLATTED TO
THE CENTERLINE OF THE ROADS
WHICH WERE NOTED AS PRIVATE
THERE IS NO EVIDENCE BEECH RD
WAS DEDICATED TO THE PUBLIC.

- () = recorded as
□ = found iron bar
○ = found iron pipe
● = set iron pipe
■ = set iron bar

SCALE 1" = 20'

JOB # 17-136


TAX ID # GI 00620A



BASIS OF BEARING OF THIS PLAT : THE US STATE PLANE COORDINATE
SYSTEM SOUTH ZONE, NAD 83. WISCORS.

I hereby certify that I have surveyed the above- described property and the
above map is a true representation thereof and shows the size and
location of the property, its exterior boundaries, the location and
dimensions of all structures thereon, fences, apparrant easements and
roadways and visible encroachments if any.

This survey is made for the present owners of the property, and those who
purchase, mortgage, or guarantee the title thereto, within one year from
the date hereof.
DATED THIS 3rd day of June, 2017.

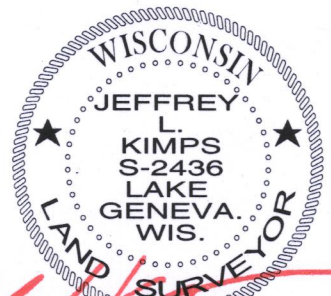

JEFFREY L KIMPS S - 2436
Wisconsin Professional Land Surveyor
(original if signed in red)

GI-620A

316-2294