


PLAT OF SURVEY

LOT 41, BAYWOOD ESTATES - 1st ADDITION

LOCATED IN THE NW ¼ OF SECTION 1, TOWNSHIP 3 NORTH,
RANGE 16 EAST AND THE NE ¼ OF SECTION 2, TOWNSHIP 3 NORTH,
RANGE 16 EAST, TOWN OF SUGAR CREEK, WALWORTH COUNTY, WISCONSIN

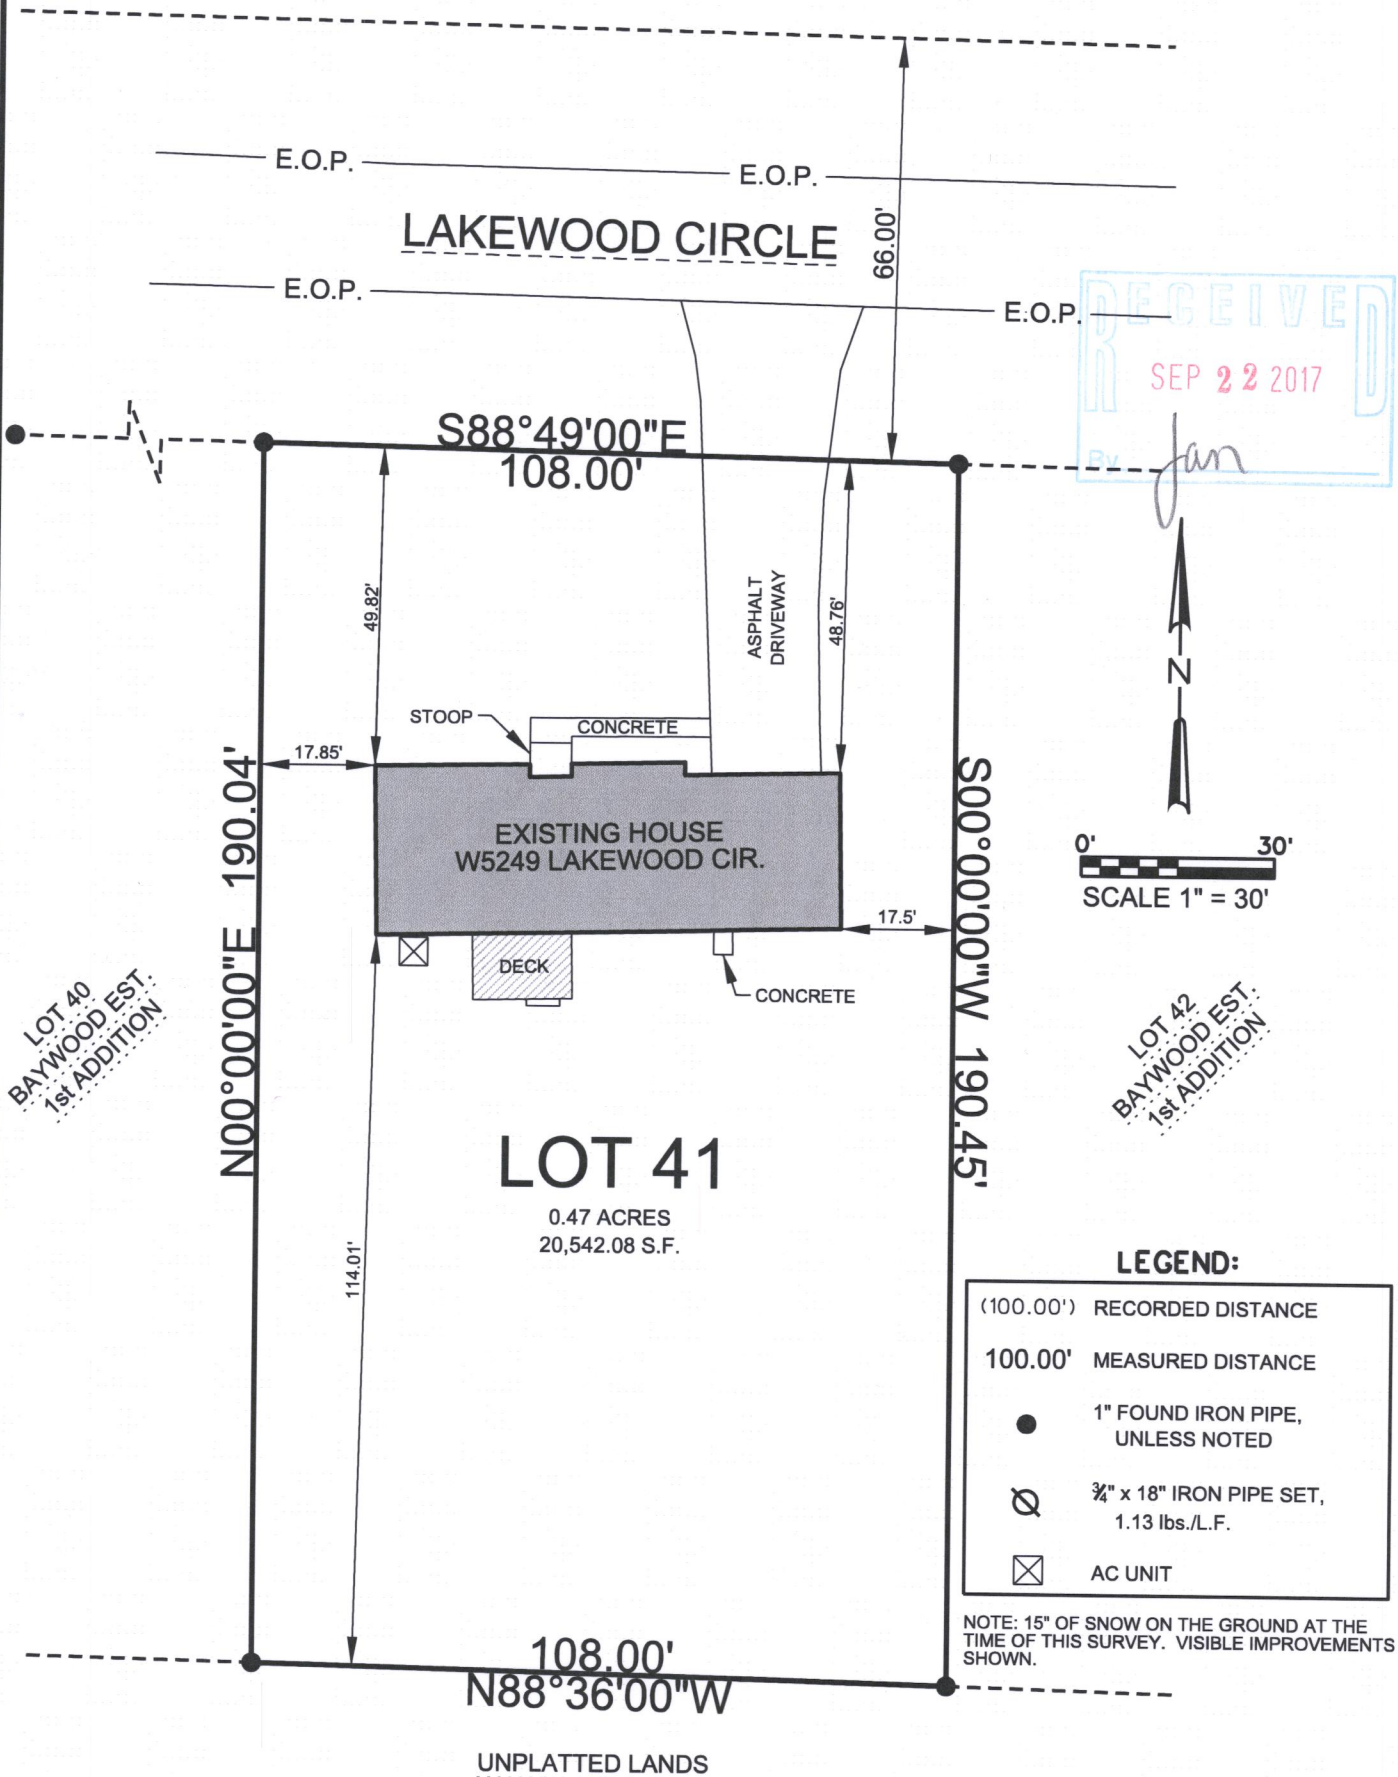

SURVEY DATE: 12/20/2016
SURVEY MADE FOR:
KEEFE REAL ESTATE, INC.
203 E. COMMERCE CT.
ELKHORN, WI 53121

V²G
SURVEYING, LLC
550 BAYVIEW ROAD SUITE B
MUKWONAGO, WI 53149
(262) 378-5097

THIS SURVEY IS MADE FOR THE USE OF THE
PRESENT OWNERS OF THE PROPERTY, AND
ALSO THOSE WHO PURCHASE, MORTGAGE OR
GUARANTEE TITLE TO WITHIN ONE (1) YEAR
FROM DATE HERETO.

I, MICHAEL A. GREESON R.L.S. #2770, HEREBY CERTIFY THAT
THIS SURVEY WAS MADE IN ACCORDANCE WITH
THE MINIMUM STANDARDS FOR PROPERTY SURVEYS
(CHAPTER A-E 7) FOR THE STATE OF WISCONSIN AND
HAS BEEN PREPARED UNDER MY DIRECTION AND
CONTROL AND IS CORRECT TO THE BEST OF MY
KNOWLEDGE AND BELIEF.

