



PLAT OF SURVEY of lots 5, 6, 7, and 8, Block 2, North Lake Beach Tract
No. 3 East Part, Town of Sugar Creek, Walworth County, Wisconsin.

August 4, 1977

I certify that I have surveyed the above described land and that the plat shown hereon is an accurate survey and a true representation thereof and correctly shows the exterior boundary lines and all divisions of said property.

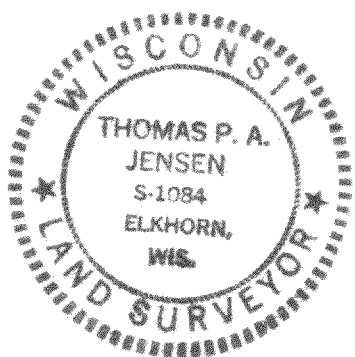

Thomas P. A. Jensen
Thomas P. A. Jensen
Elkhorn, Wisconsin

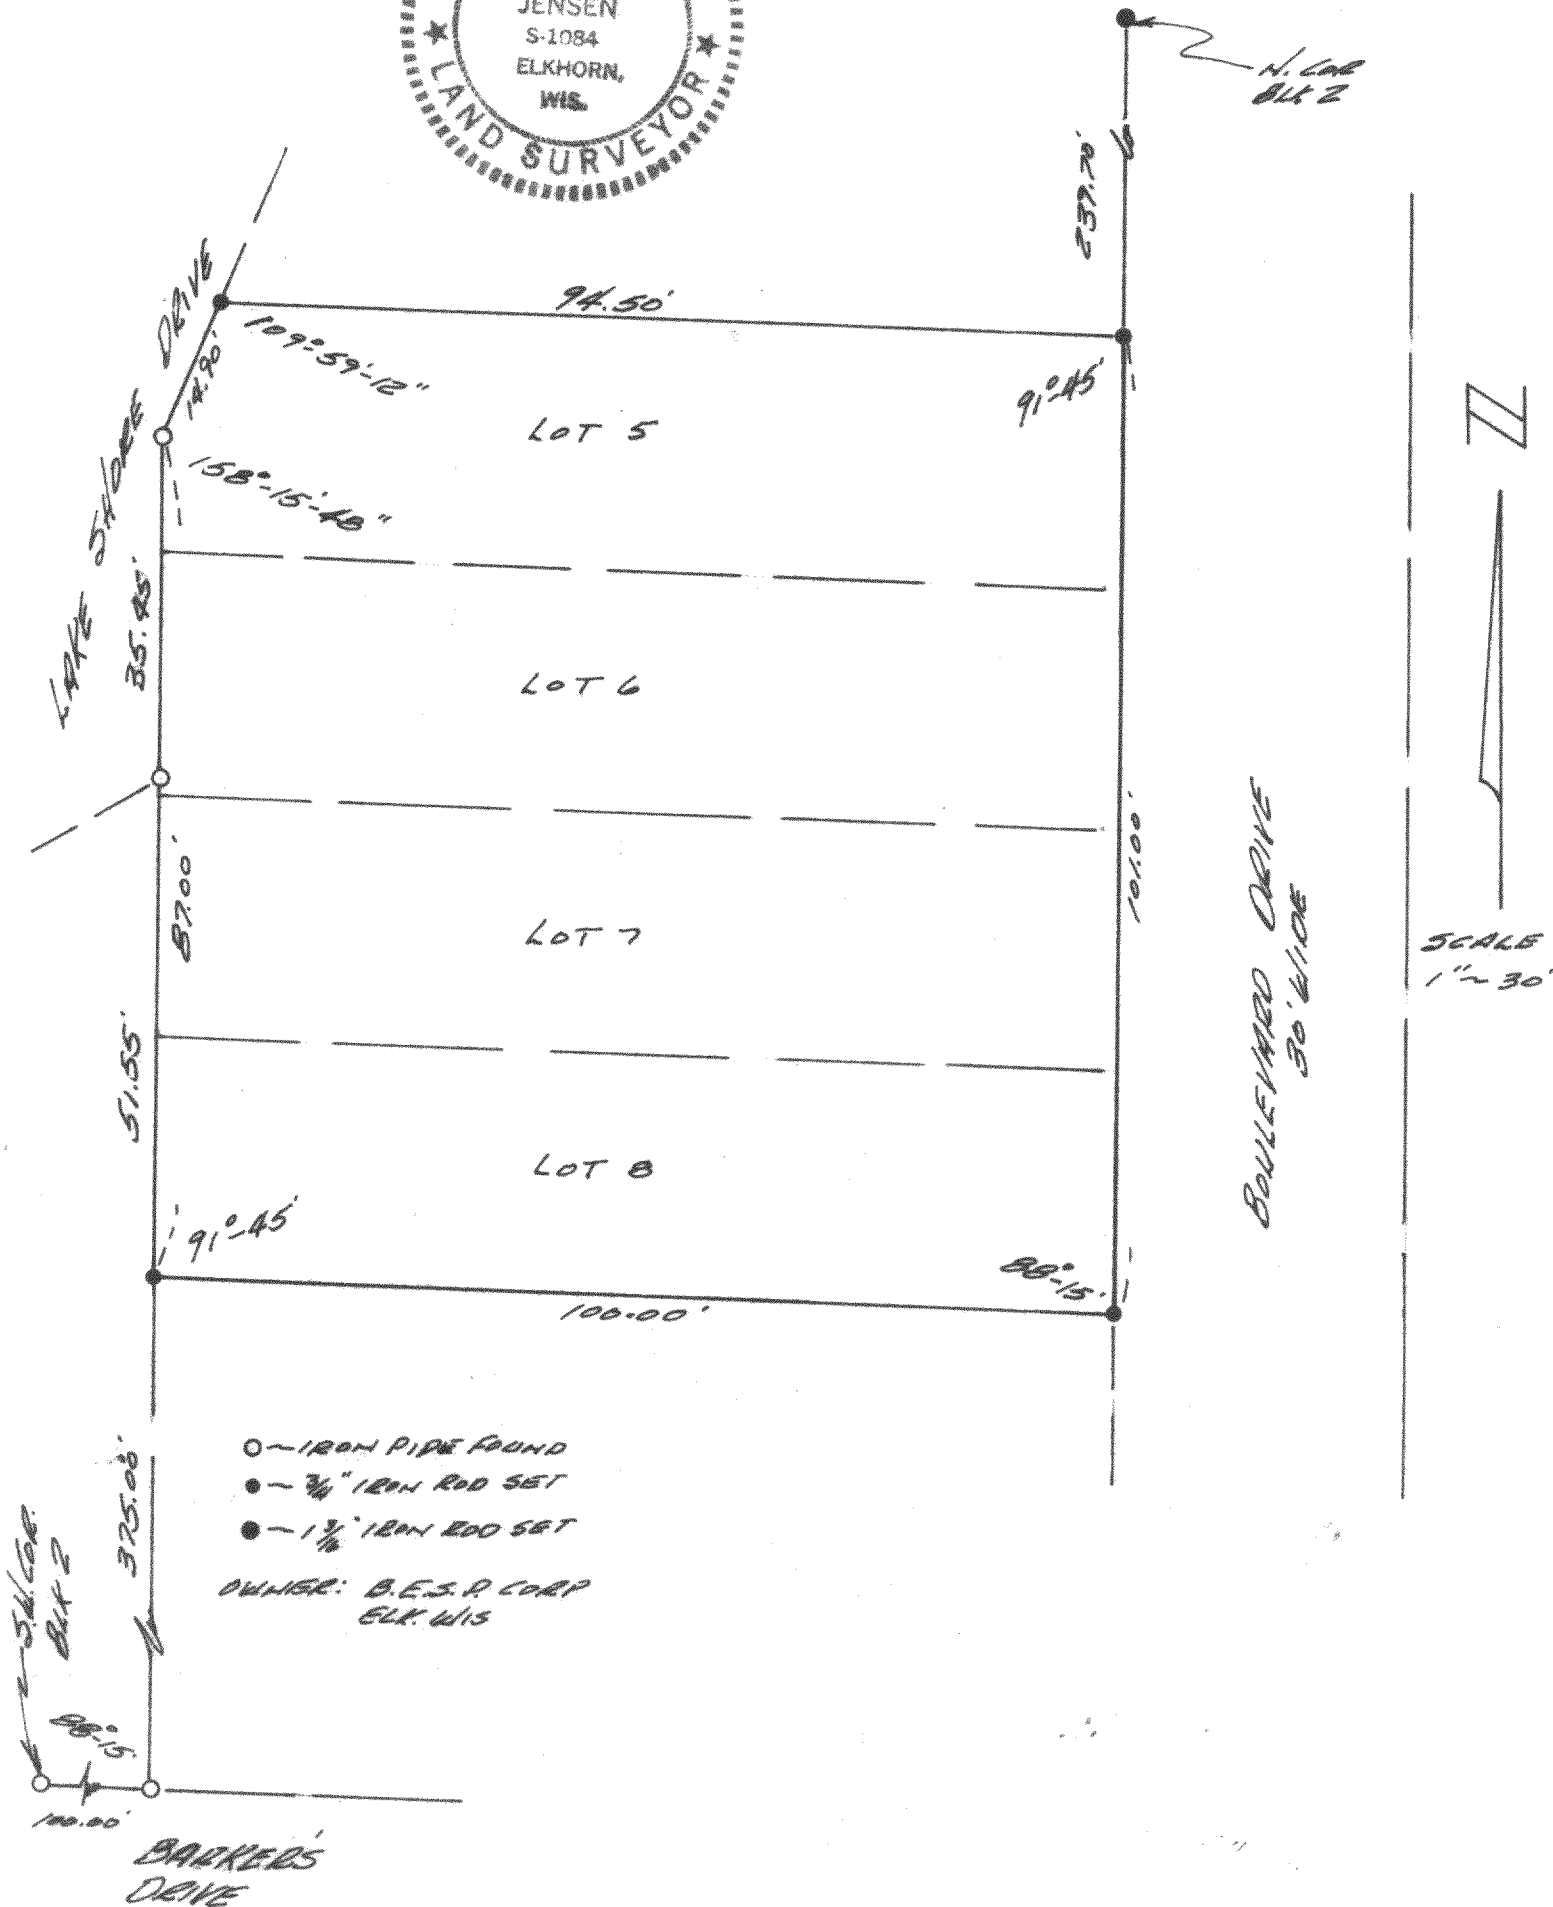

6NLS3-317

316-2315