

LAND-MARK SURVEYING

Mark L. Miritz

Wisconsin Professional Land Surveyor S-2582

N9330 Knuteson Drive  
Whitewater, WI 53190  
Phone: (262) 495-3284  
MARKMIRITZ@  
LAND-MARKSURVEYING.COM



ORDERED BY:  
JERRY KROUPA  
KEEFE REAL ESTATE  
204 E. COMMERCE CT.  
ELKHORN, WI 53121

PLAT OF SURVEY

LOT 20 OF BAYWOOD ESTATES  
SUBDIVISION LOCATED IN THE  
NORTHEAST 1/4 OF SECTION 2,  
TOWN 2 NORTH, RANGE 16 EAST,  
WALWORTH COUNTY, WISCONSIN.

DON JEAN BAY

100 YEAR FLOOD ELEVATION = 886.00'  
FALLS IN RIP - RAP ALONG SHORELINE

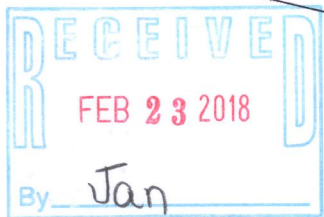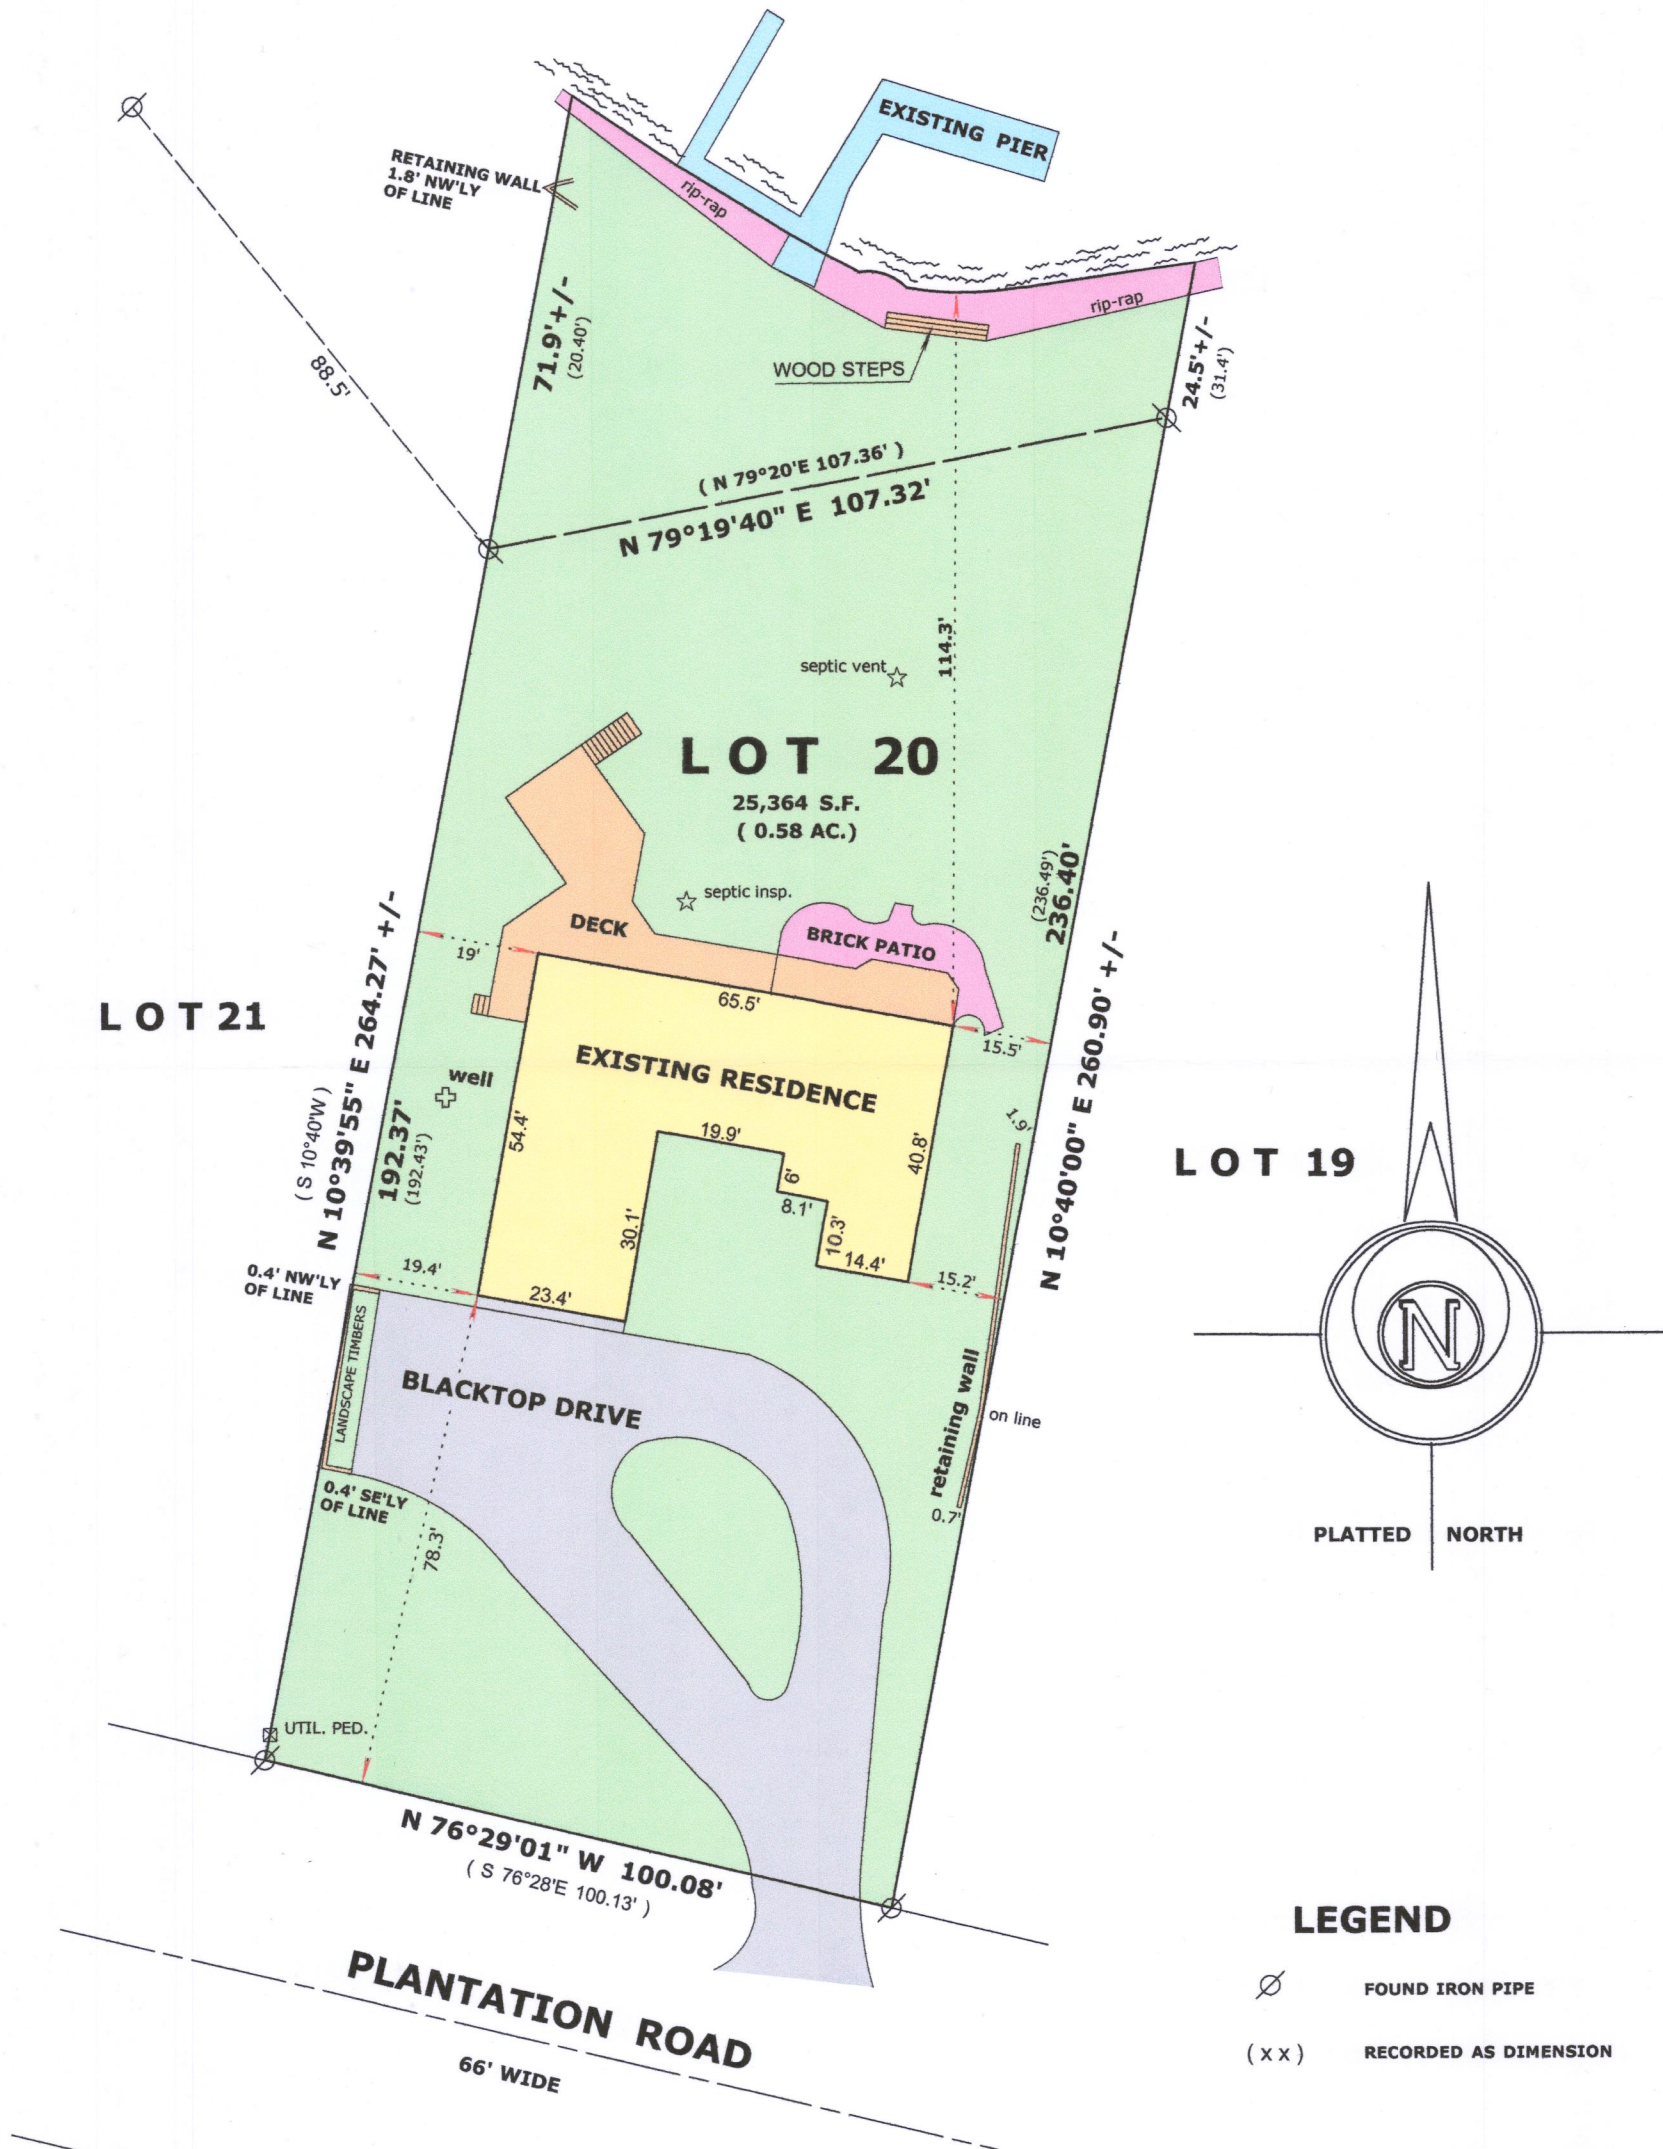

MARK L. MIRITZ  
WISCONSIN PROFESSIONAL  
LAND SURVEYOR S-2582

DATE: JAN. 30, 2018 JOB NO. 04.906

GBE-20 316-2327