

-OF-

SURVEY LOCATION: W5317 DELAVAN DRIVE

DEHAVAN DRIVE
(FUTURE 66' WIDE STREET)

42' WIDE

S89°54'29"E 150.00'

12' WIDE UTILITY EASEMENT

29.8'

30.0'

46.1'

65.1'

20.1'

22.1'

34.1'

24.4'

EXISTING DWELLING

46.3'

54.1'

10' X 10' SHED TO BE MOVED

DECK NOT LOCATED

11.0'

well

21.7'

36.0'

16.0'

24.3'

PROPOSED BUILDING

NO4°15'46"W 267.76'

82.23'

N89°54'22"W 150.00'

82.23'

267.77'

S04°15'46"E

DRAINAGE EASEMENT


" = 40'

SCALE


40

- FOUND IRON PIPE
- FOUND IRON ROD

SCALE: $1'' = 40'$

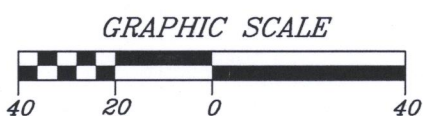

RECEIVED
JAN 28 2020
By *Jan*

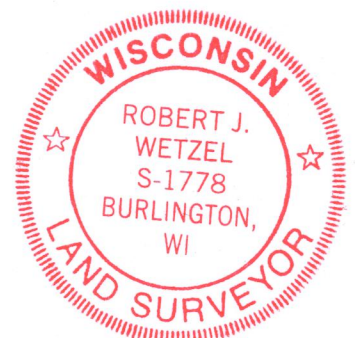

Robert J. Wetzel
ROBERT J. WETZEL S-1778

9953
JOB NUMBER

GPR-9

316-2406