

PLAT OF SURVEY
FOUNDATION ASBUILT

LOT 2 OF CERTIFIED SURVEY MAP NUMBER 4064, BEING PART OF THE SOUTHWEST ¼ OF THE
NORTHEAST ¼ OF SECTION 12, TOWN 3 NORTH, RANGE 16 EAST, LYING AND BEING IN THE
TOWN OF SUGAR CREEK, COUNTY OF WALWORTH AND STATE OF WISCONSIN.




0' 30'
SCALE 1" = 30'

NOTES:

THIS PARCEL IS SUBJECT TO ALL AND ANY
RESTRICTIONS, EASEMENTS AND NOTES
SHOWN ON CERTIFIED SURVEY MAP
NUMBER 4064 RECORDED AT THE WALWORTH
COUNTY REGISTER OF DEEDS.

PROPOSED GRADES PER GRADING PLAN OR
ADJUSTED BY BUILDER. CONTRACTOR TO
VERIFY ALL PROPOSED GRADES AND WALL
HEIGHTS PRIOR TO EXCAVATION.

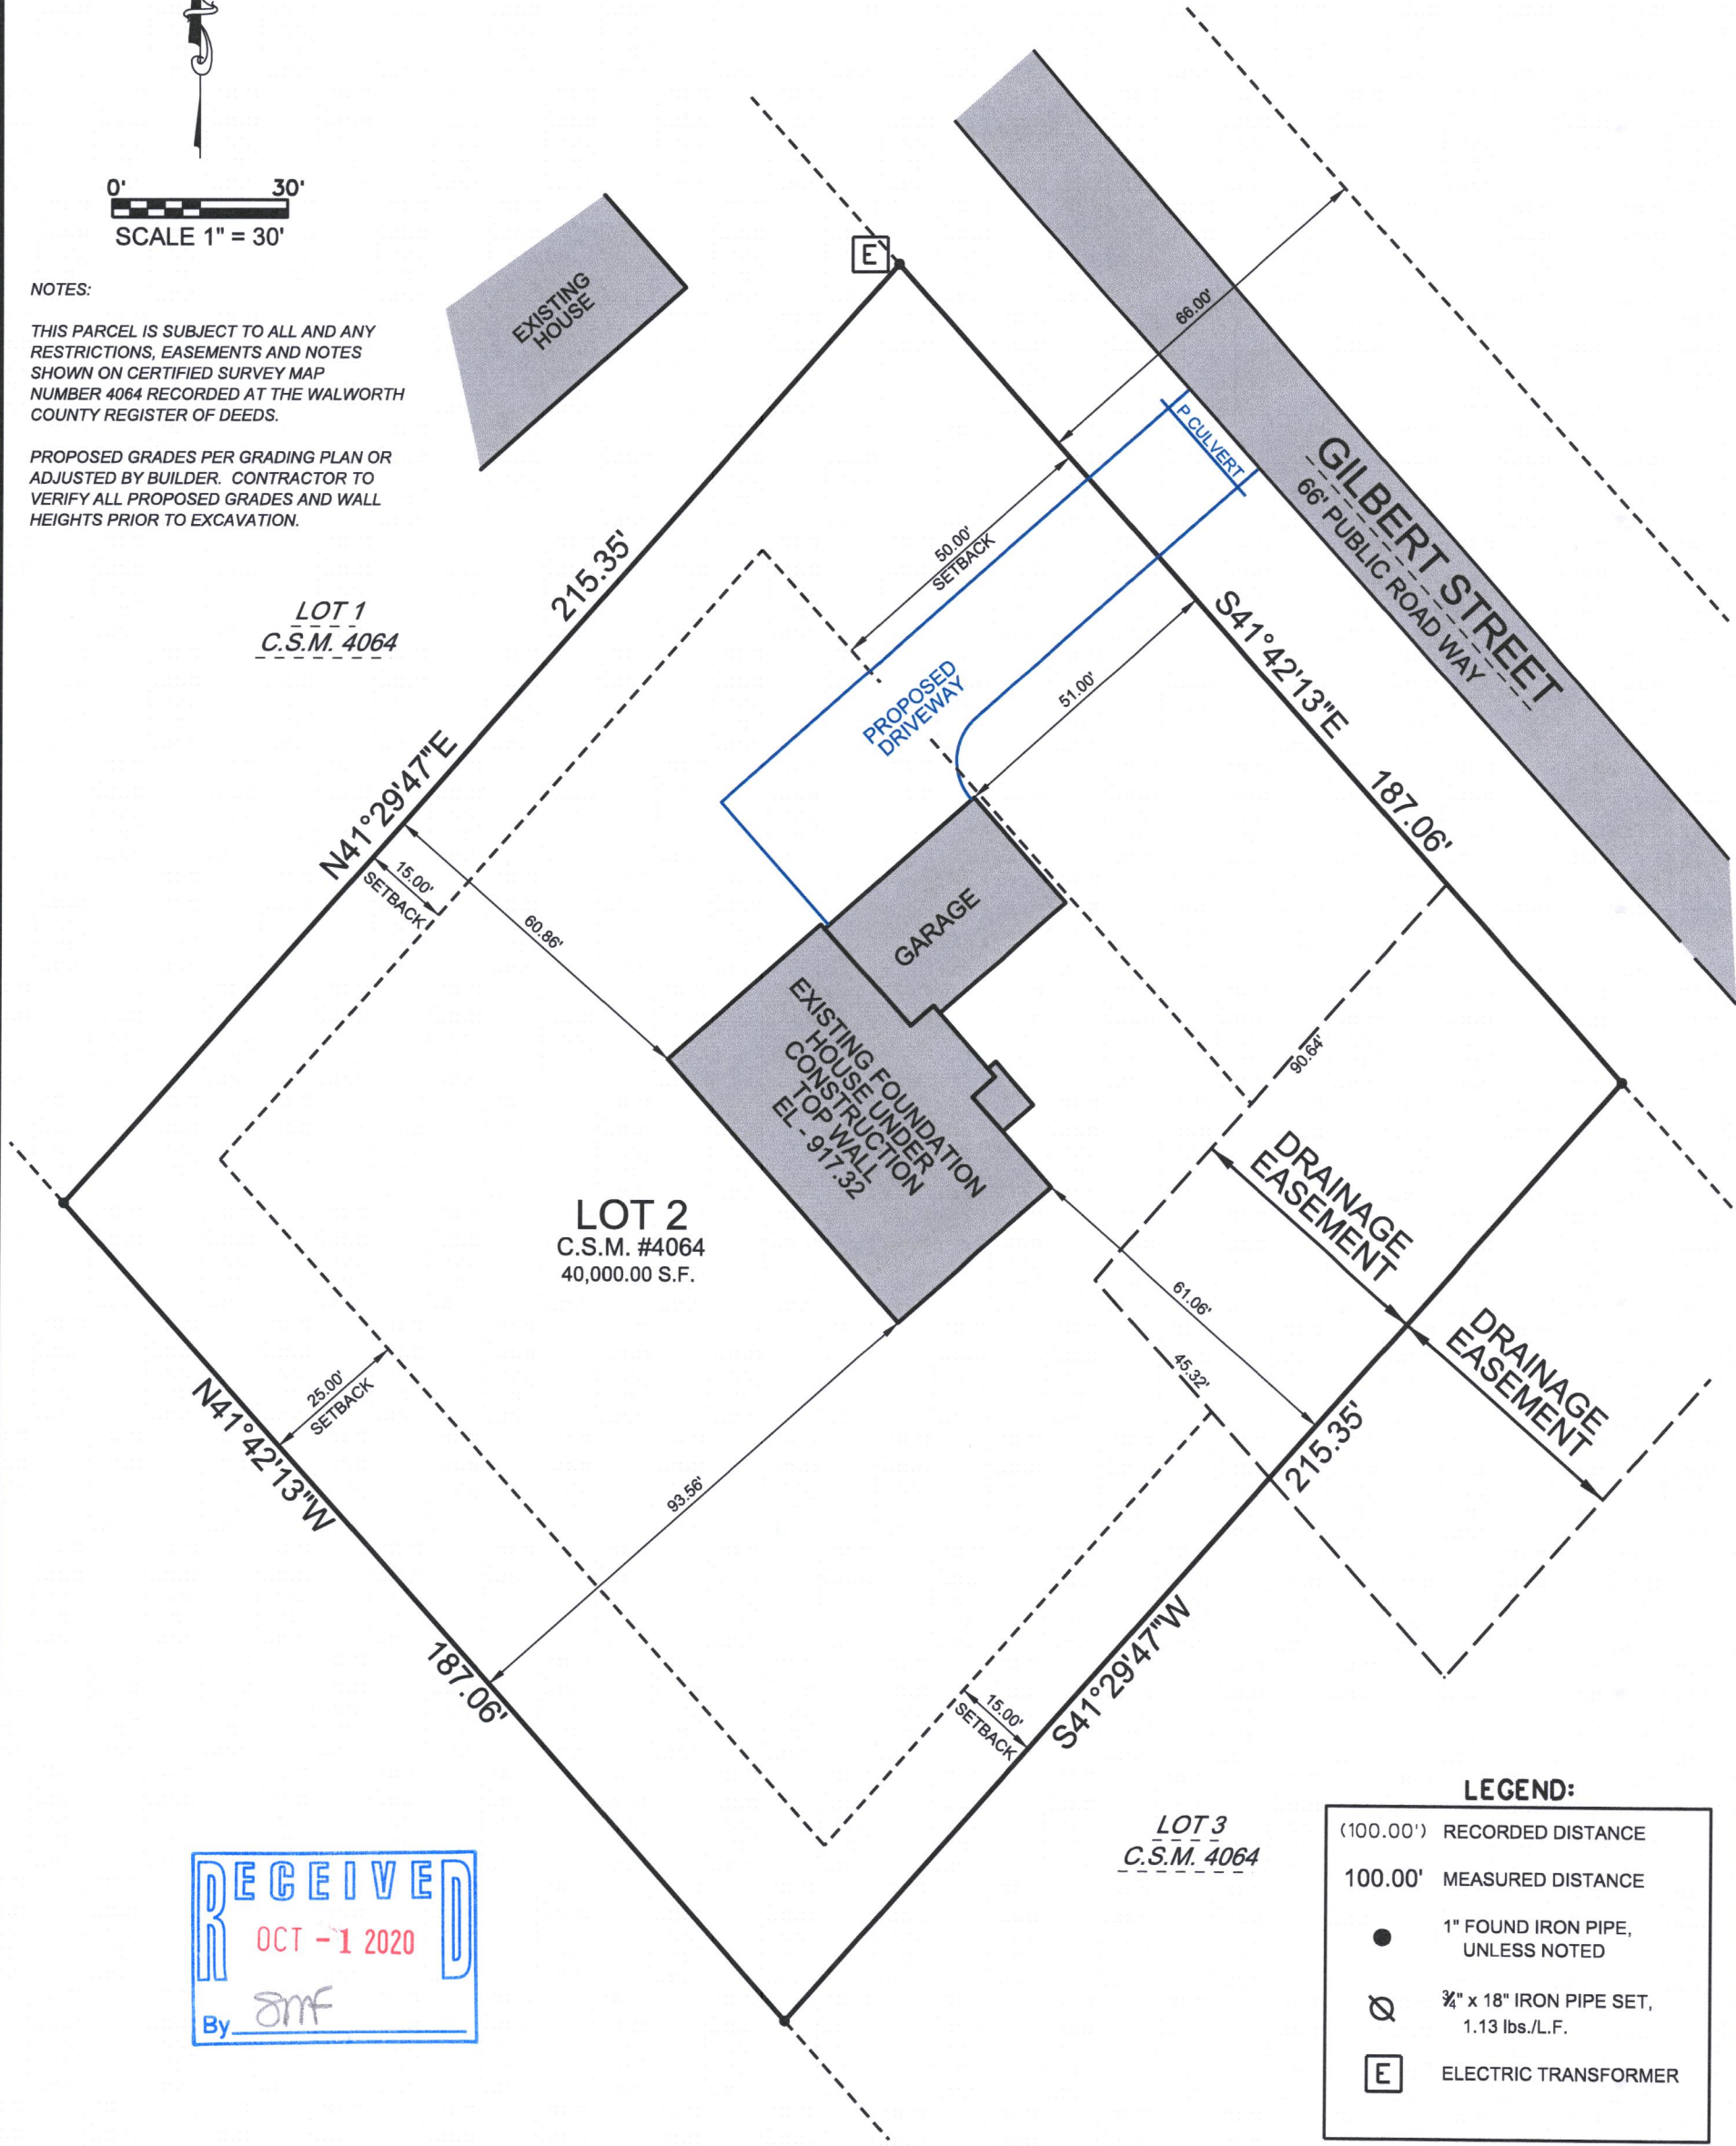

RECEIVED
OCT -1 2020
By *SMF*

LEGEND:

- (100.00') RECORDED DISTANCE
- 100.00' MEASURED DISTANCE
- 1" FOUND IRON PIPE, UNLESS NOTED
- ⊗ ¾" x 18" IRON PIPE SET, 1.13 lbs./L.F.
- [E] ELECTRIC TRANSFORMER

V²G
SURVEYING, LLC
123 WOLF RUN - SUITE 4
MUKWONAGO, WI 53149
(262) 378-5097

SURVEY MADE FOR:	
BIELINSKI HOMES, INC. 1830 MEADOW LANE PEWAUKEE, WI 53072	
DATE	ITEM
01/20/2020	PRELIM. SURVEY
01/22/2020	FINAL SURVEY
03/18/2020	REV. GARAGE GRD
04/06/2020	FOUND. ASBUILT

THIS SURVEY IS MADE FOR THE USE OF THE PRESENT OWNERS
OF THE PROPERTY, AND ALSO THOSE WHO PURCHASE, MORTGAGE
OR GUARANTEE TITLE TO WITHIN ONE (1) YEAR FROM DATE HERETO.

I, MICHAEL A. GREESON P.L.S. #2770, HEREBY CERTIFY THAT THIS
SURVEY WAS MADE IN ACCORDANCE WITH THE MINIMUM STANDARDS
FOR PROPERTY SURVEYS (CHAPTER A-E 7) FOR THE STATE OF WISCONSIN
AND HAS BEEN PREPARED UNDER MY DIRECTION AND CONTROL AND IS
CORRECT TO THE BEST OF MY KNOWLEDGE AND BELIEF.

WISCONSIN
Michael A. Greeson
S-2770
East Troy
Wis
Michael A. Greeson