
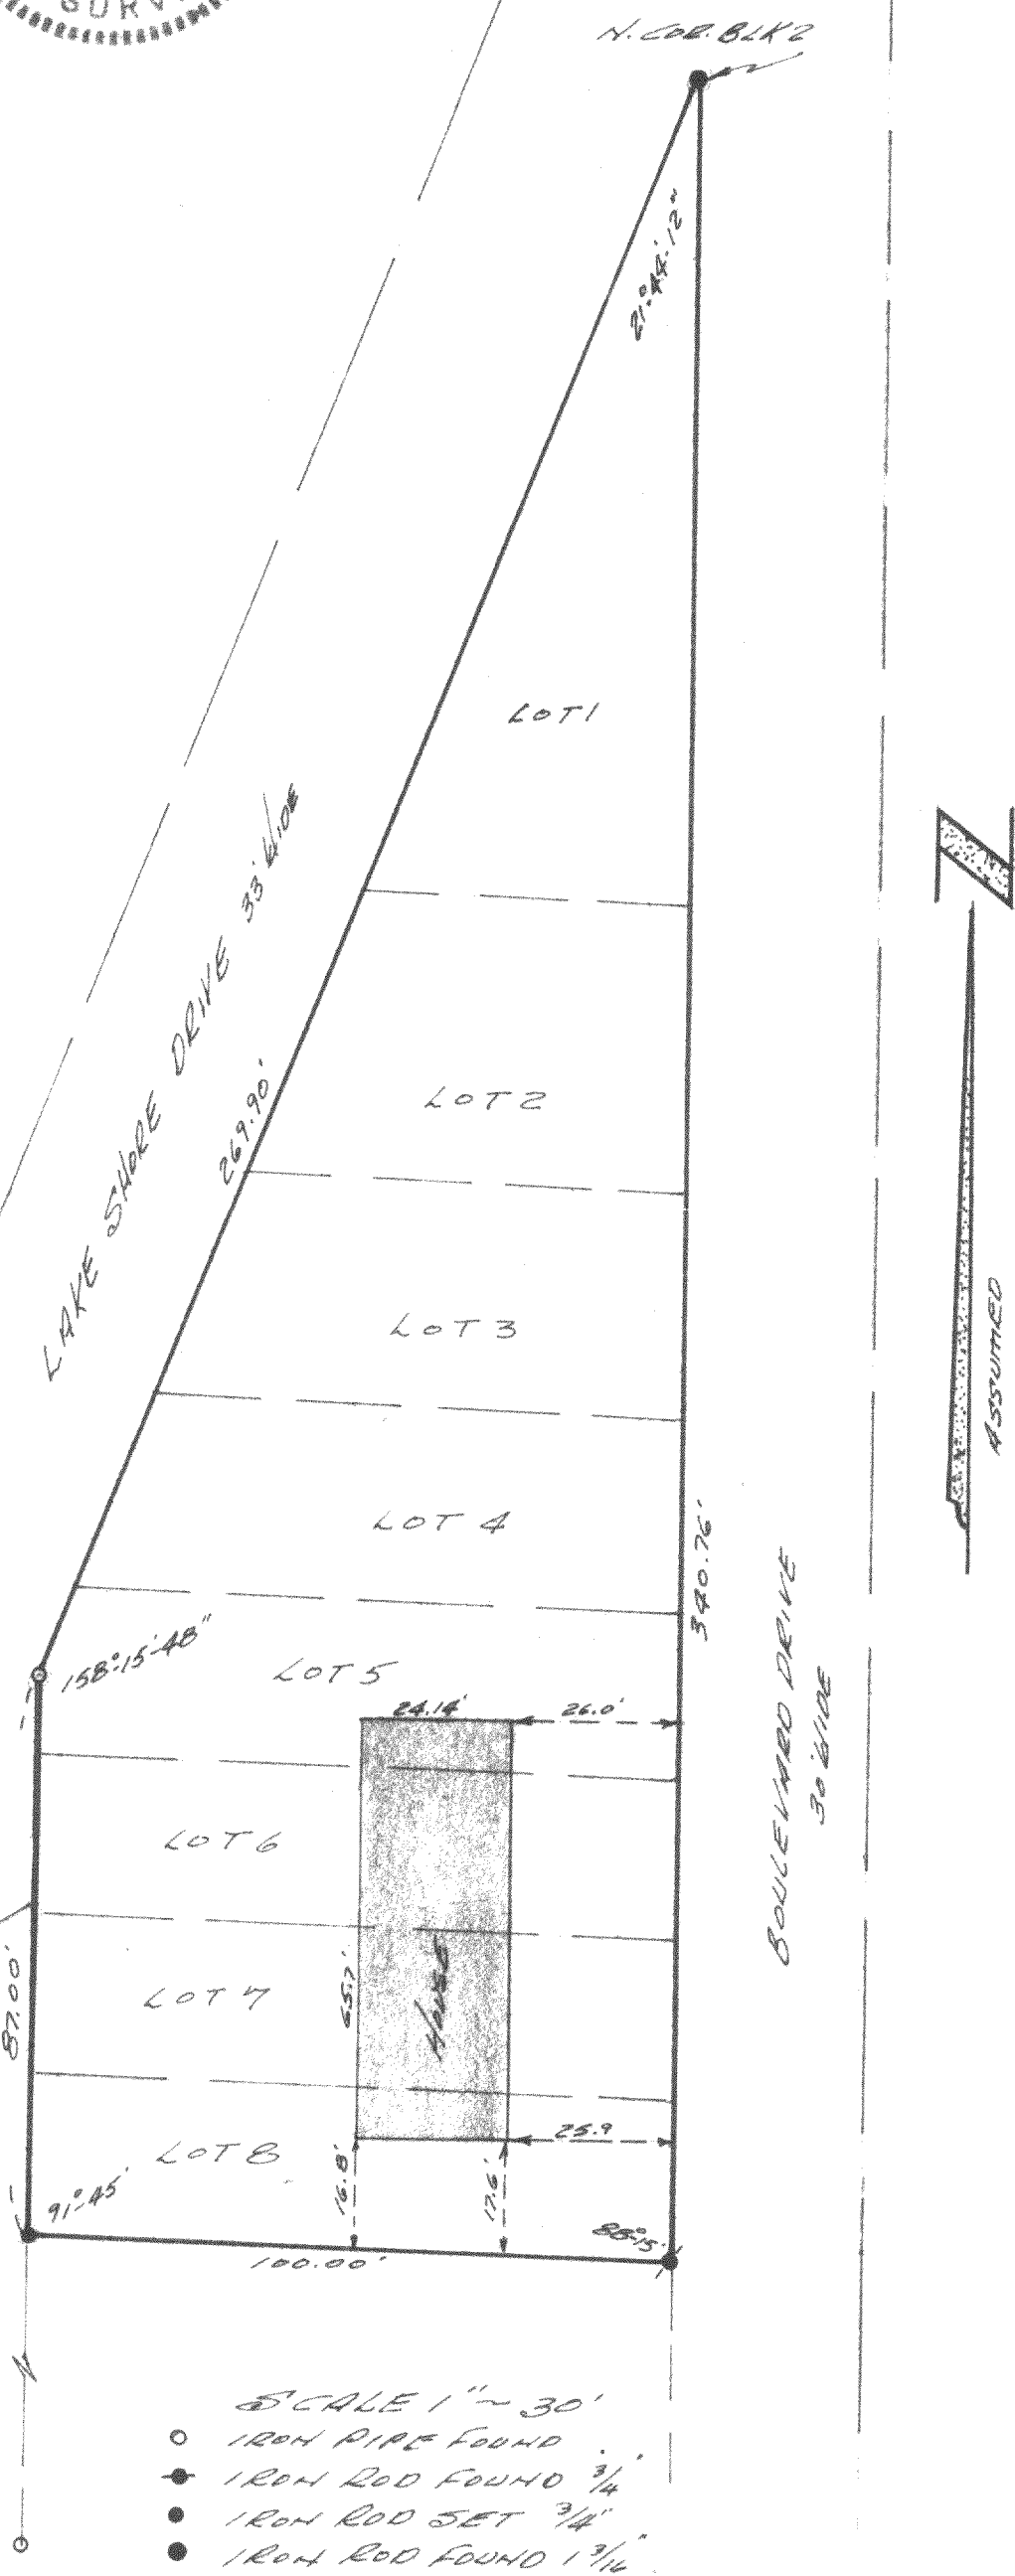


PLAT OF SURVEY of Lots 1, 2, 3, 4, 5, 6, 7, & 8, Block 2, North Lake Beach Tract No. 3 East Part, Town of Sugar Creek, Walworth County, Wisconsin.

Jan 11, 1978

I certify that I have surveyed the above described land and that the plat shown hereon is an accurate survey and a true representation thereof and correctly shows the exterior boundary lines and all divisions of said property and all buildings thereon.

Thomas P.A. Jensen
Thomas P.A. Jensen S-1084
Elkhorn, Wisconsin

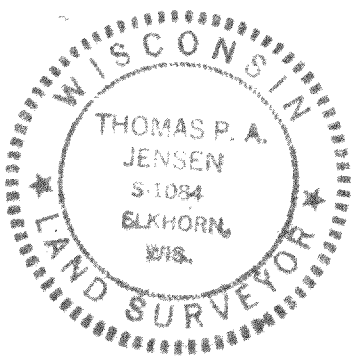

SCALE 1" = 30'
○ IRON PIPE FOUND
● IRON ROD FOUND 3/4"
● IRON ROD SET 3/4"
● IRON ROD FOUND 1 3/4"
SURVEYED FOR: C. MURRAY
ELKHORN, WIS.