
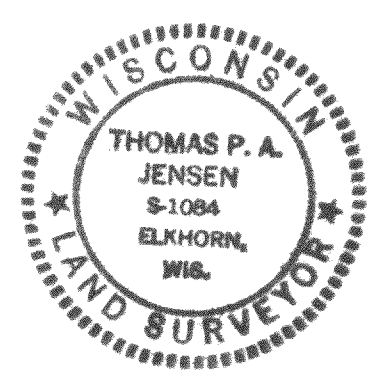


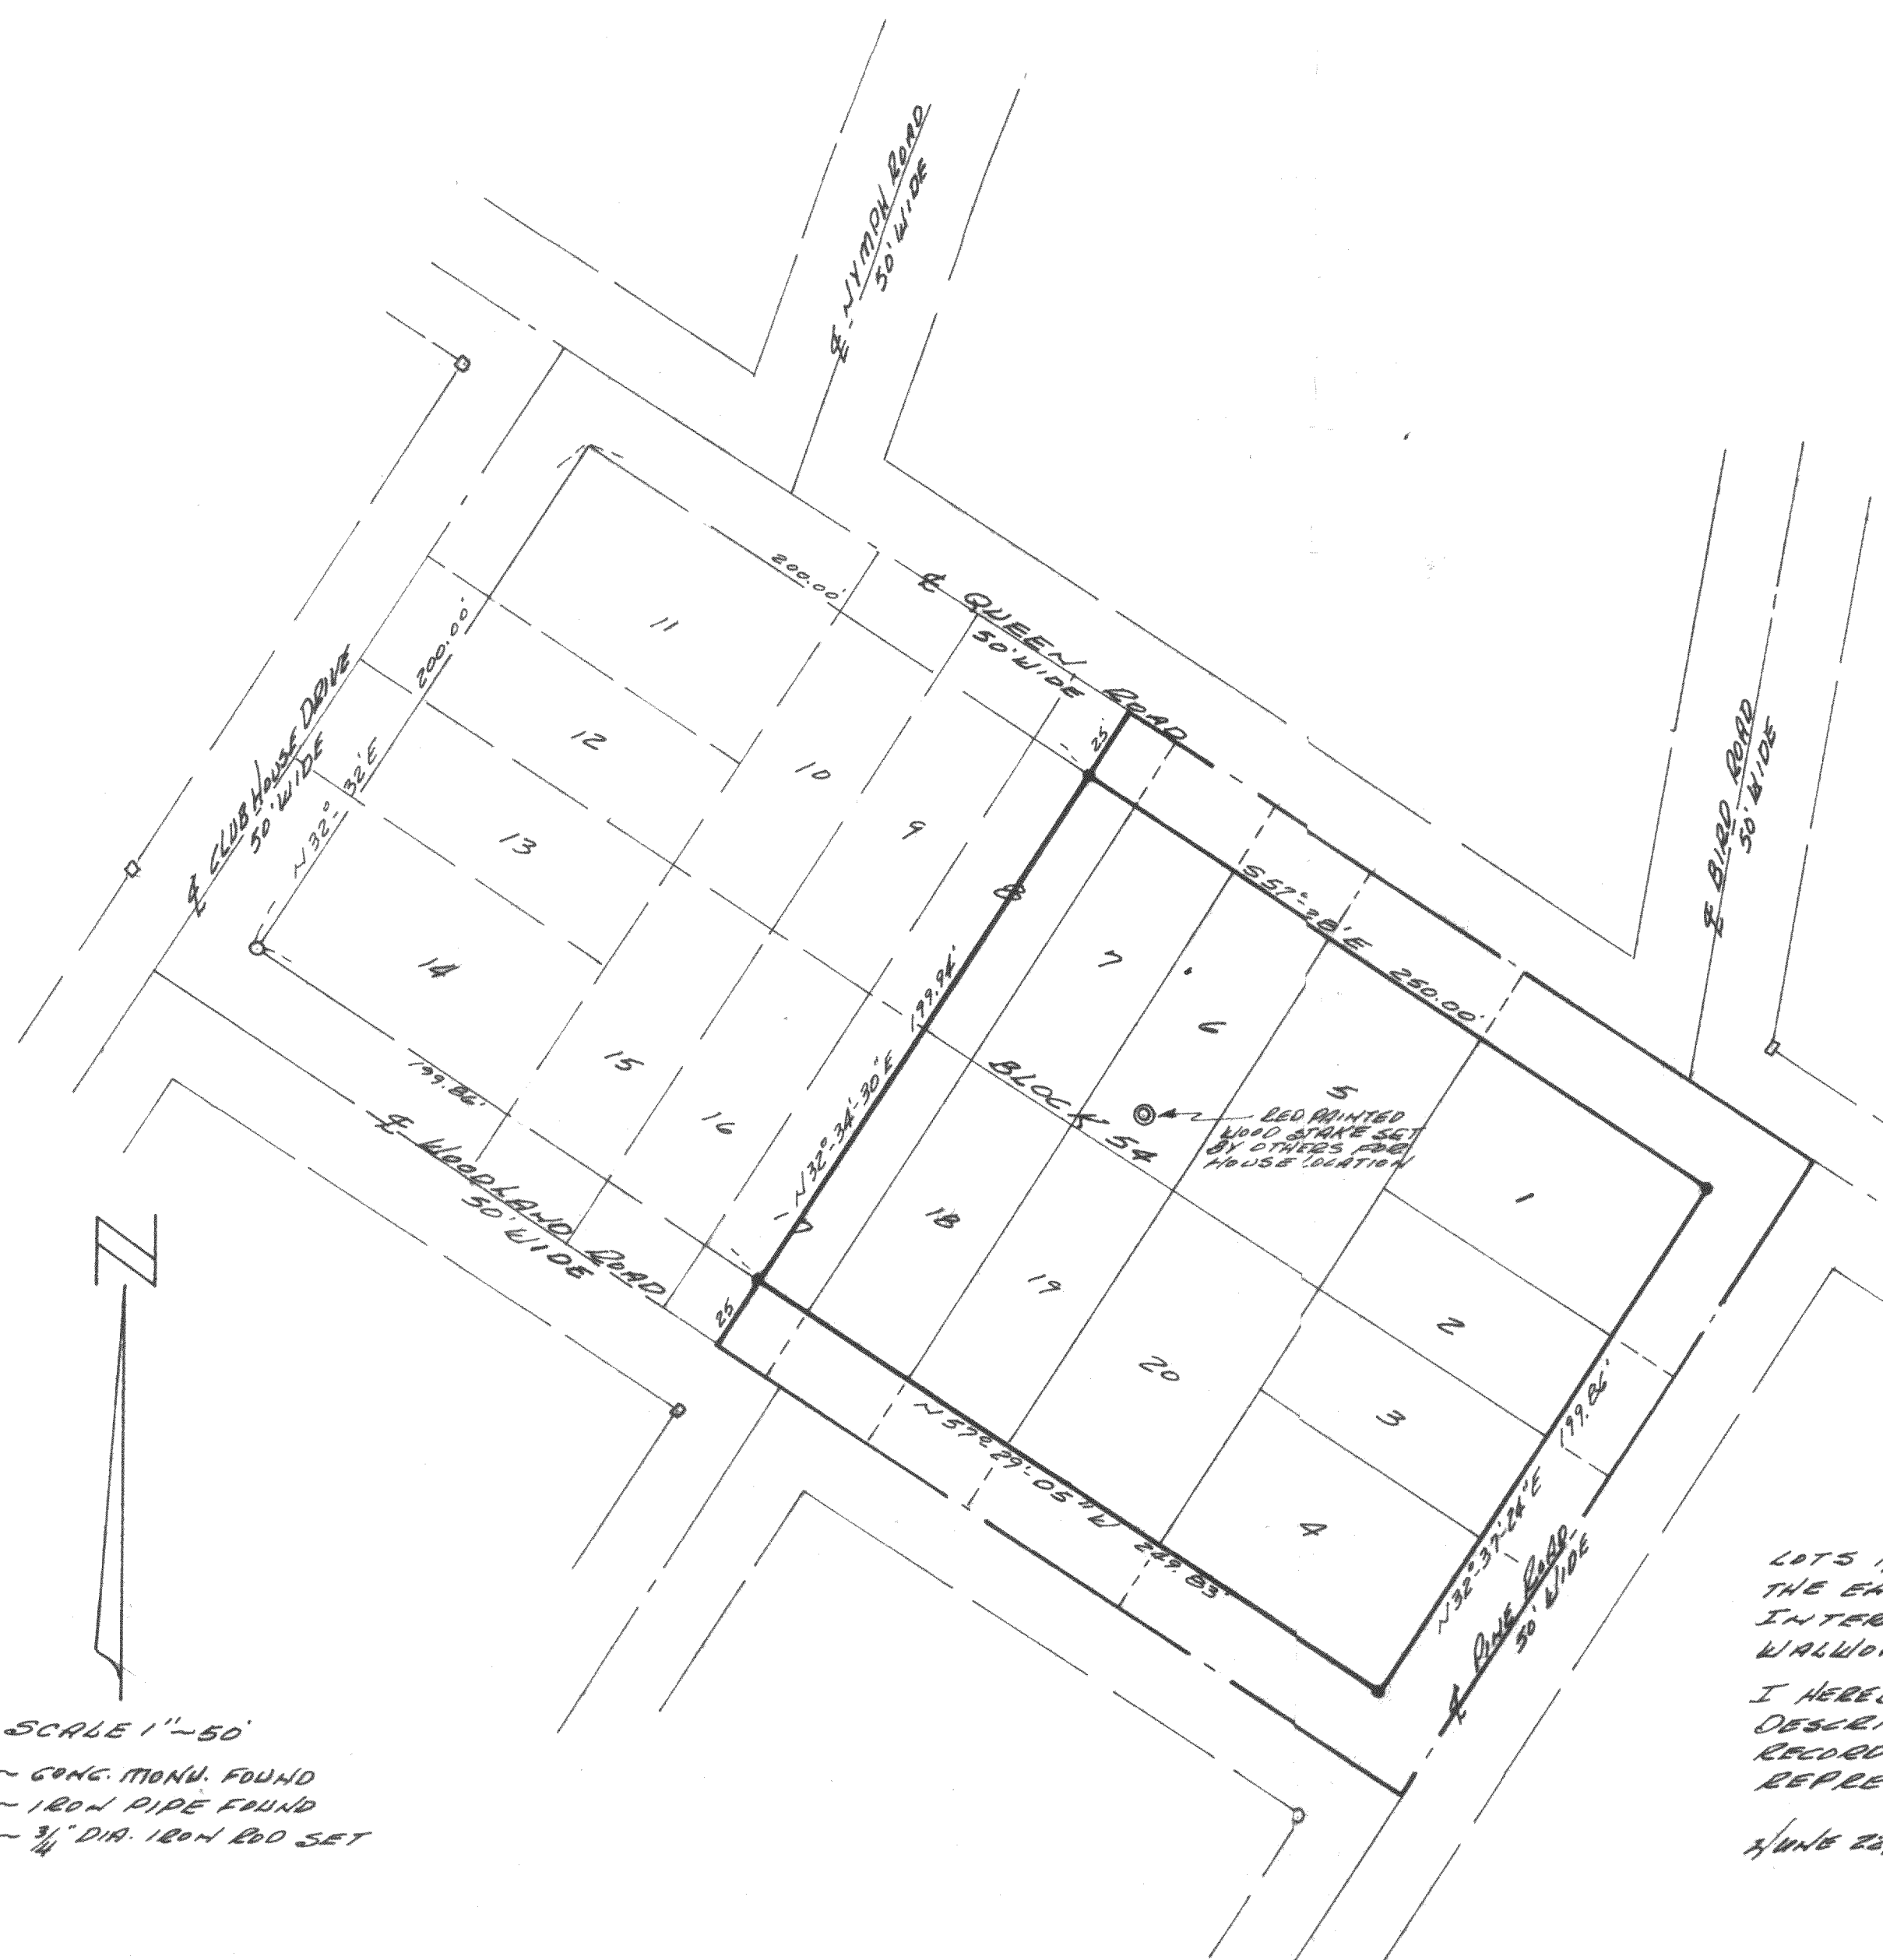

- SCALE 1"=50'
- ~ CONC. MOND. FOUND
 - ~ IRON PIPE FOUND
 - ~ 3/4" DIA. IRON ROD SET

PLAT OF SURVEY
OF
LOTS 1, 2, 3, 4, 5, 6, 7, 18, 19, 20, THE EAST 1/2 OF 8 AND
THE EAST 1/2 OF 17, BLOCK 54, FOURTH MAP OF
INTERLAKEN, LOCATED IN SECTION 11, T3N R16E,
WALWORTH COUNTY, WIS.

I HEREBY CERTIFY THAT I HAVE SURVEYED THE ABOVE
DESCRIBED PROPERTY ACCORDING TO THE OFFICIAL
RECORDS & THAT THE PLAT HEREON IS A CORRECT
REPRESENTATION OF THE LOT LINES.

JUNE 22, 1971

Thomas P. A. Jensen
THOMAS P. A. JENSEN P.L.S.-1084
JENSEN SURVEYING & MAPPING
ELKHORN, WISCONSIN

61-437, 438, 488

X
316-248