


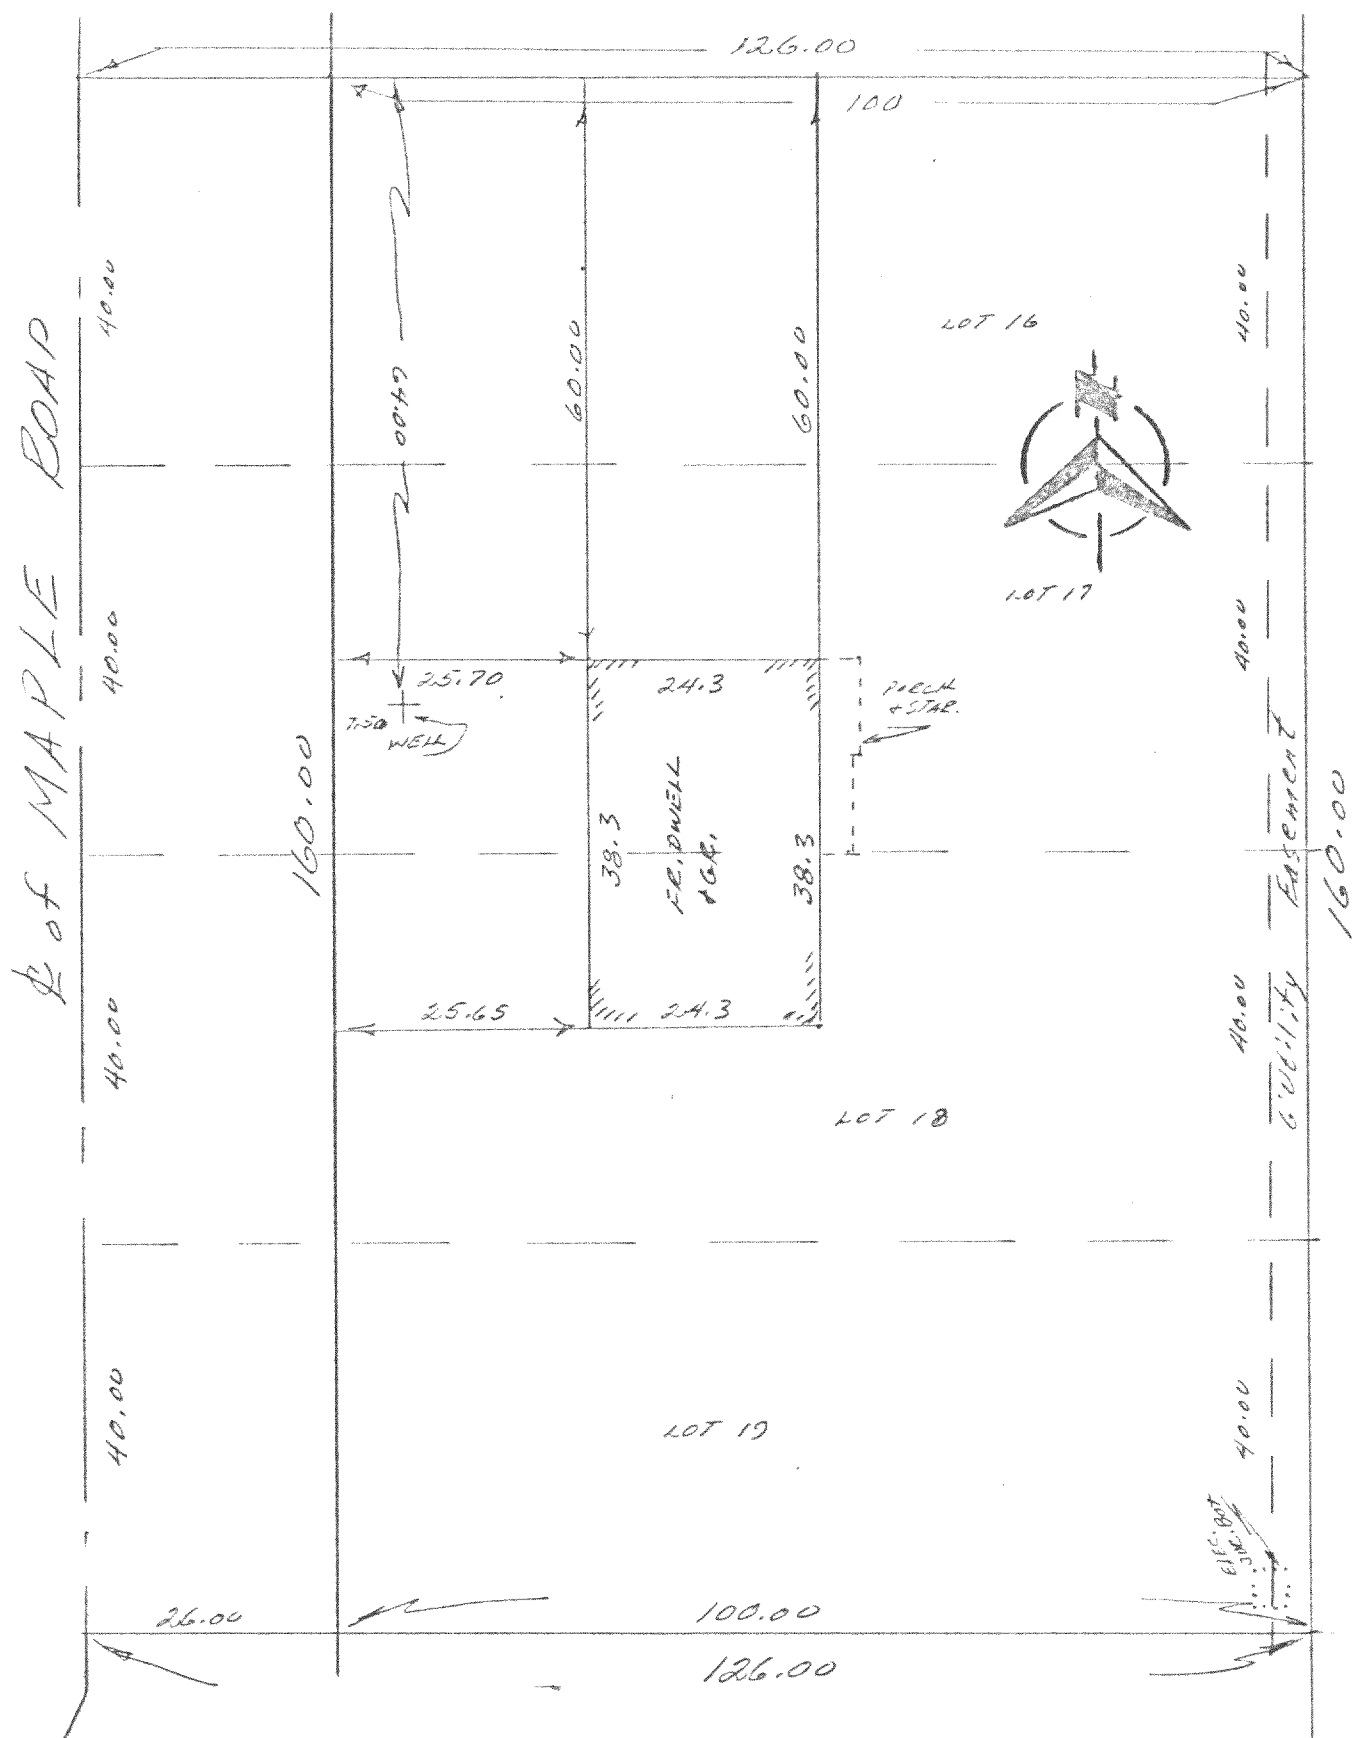

LOTS 16-17-18 & 19 IN BLOCK 23 OF INTERLAKEN
3RD MAP IN THE TOWN OF SUGAR CREEK.
LYING AND BEING IN THE TOWN OF SUGAR CREEK
WALWORTH COUNTY, STATE OF WISC.

Survey for:

Name: FULLER

Address of survey: N. 1830 MAPLE ROAD

Part of _____ Quarter of

Section 11 Town 3 N.R. 16 E.

Ref: _____

Date of survey, 4-1-78

SURVEY NO. 5272

SURVEY CERTIFICATE

I CERTIFY THAT I HAVE SURVEYED THE ABOVE DESCRIBED (PROPERTY) AND THE ABOVE MAP IS A TRUE REPRESENTATION THEREOF AND SHOWS THE SIZE AND LOCATION OF THE PROPERTY, ITS EXTERIOR BOUNDARIES, THE LOCATION AND DIMENSIONS OF ALL VISIBLE STRUCTURES THEREON, FENCES, APPARENT EASEMENTS AND ROADWAYS AND VISIBLE ENCROACHMENTS, IF ANY. THIS SURVEY IS MADE FOR THE EXCLUSIVE USE OF THE PRESENT OWNERS OF THE PROPERTY, AND ALSO THOSE WHO PURCHASE, MORTGAGE, OR GUARANTEE THE TITLE THERETO WITHIN ONE (1) YEAR FROM DATE HEREOF, AND AS TO THEM I WARRANT THE ACCURACY OF SAID SURVEY AND MAP

Harold M. Schneider
HAROLD M. SCHNEIDER

316-249