


# PLAT OF SURVEY

## FOUNDATION ASBUILT

LOT 2, C.S.M. No. 4105, LOCATED IN PART OF THE NE ¼ OF THE  
NW ¼ OF SECTION 14, TOWN 3 NORTH, RANGE 16 EAST, TOWN OF  
SUGAR CREEK, WALWORTH COUNTY, WISCONSIN.

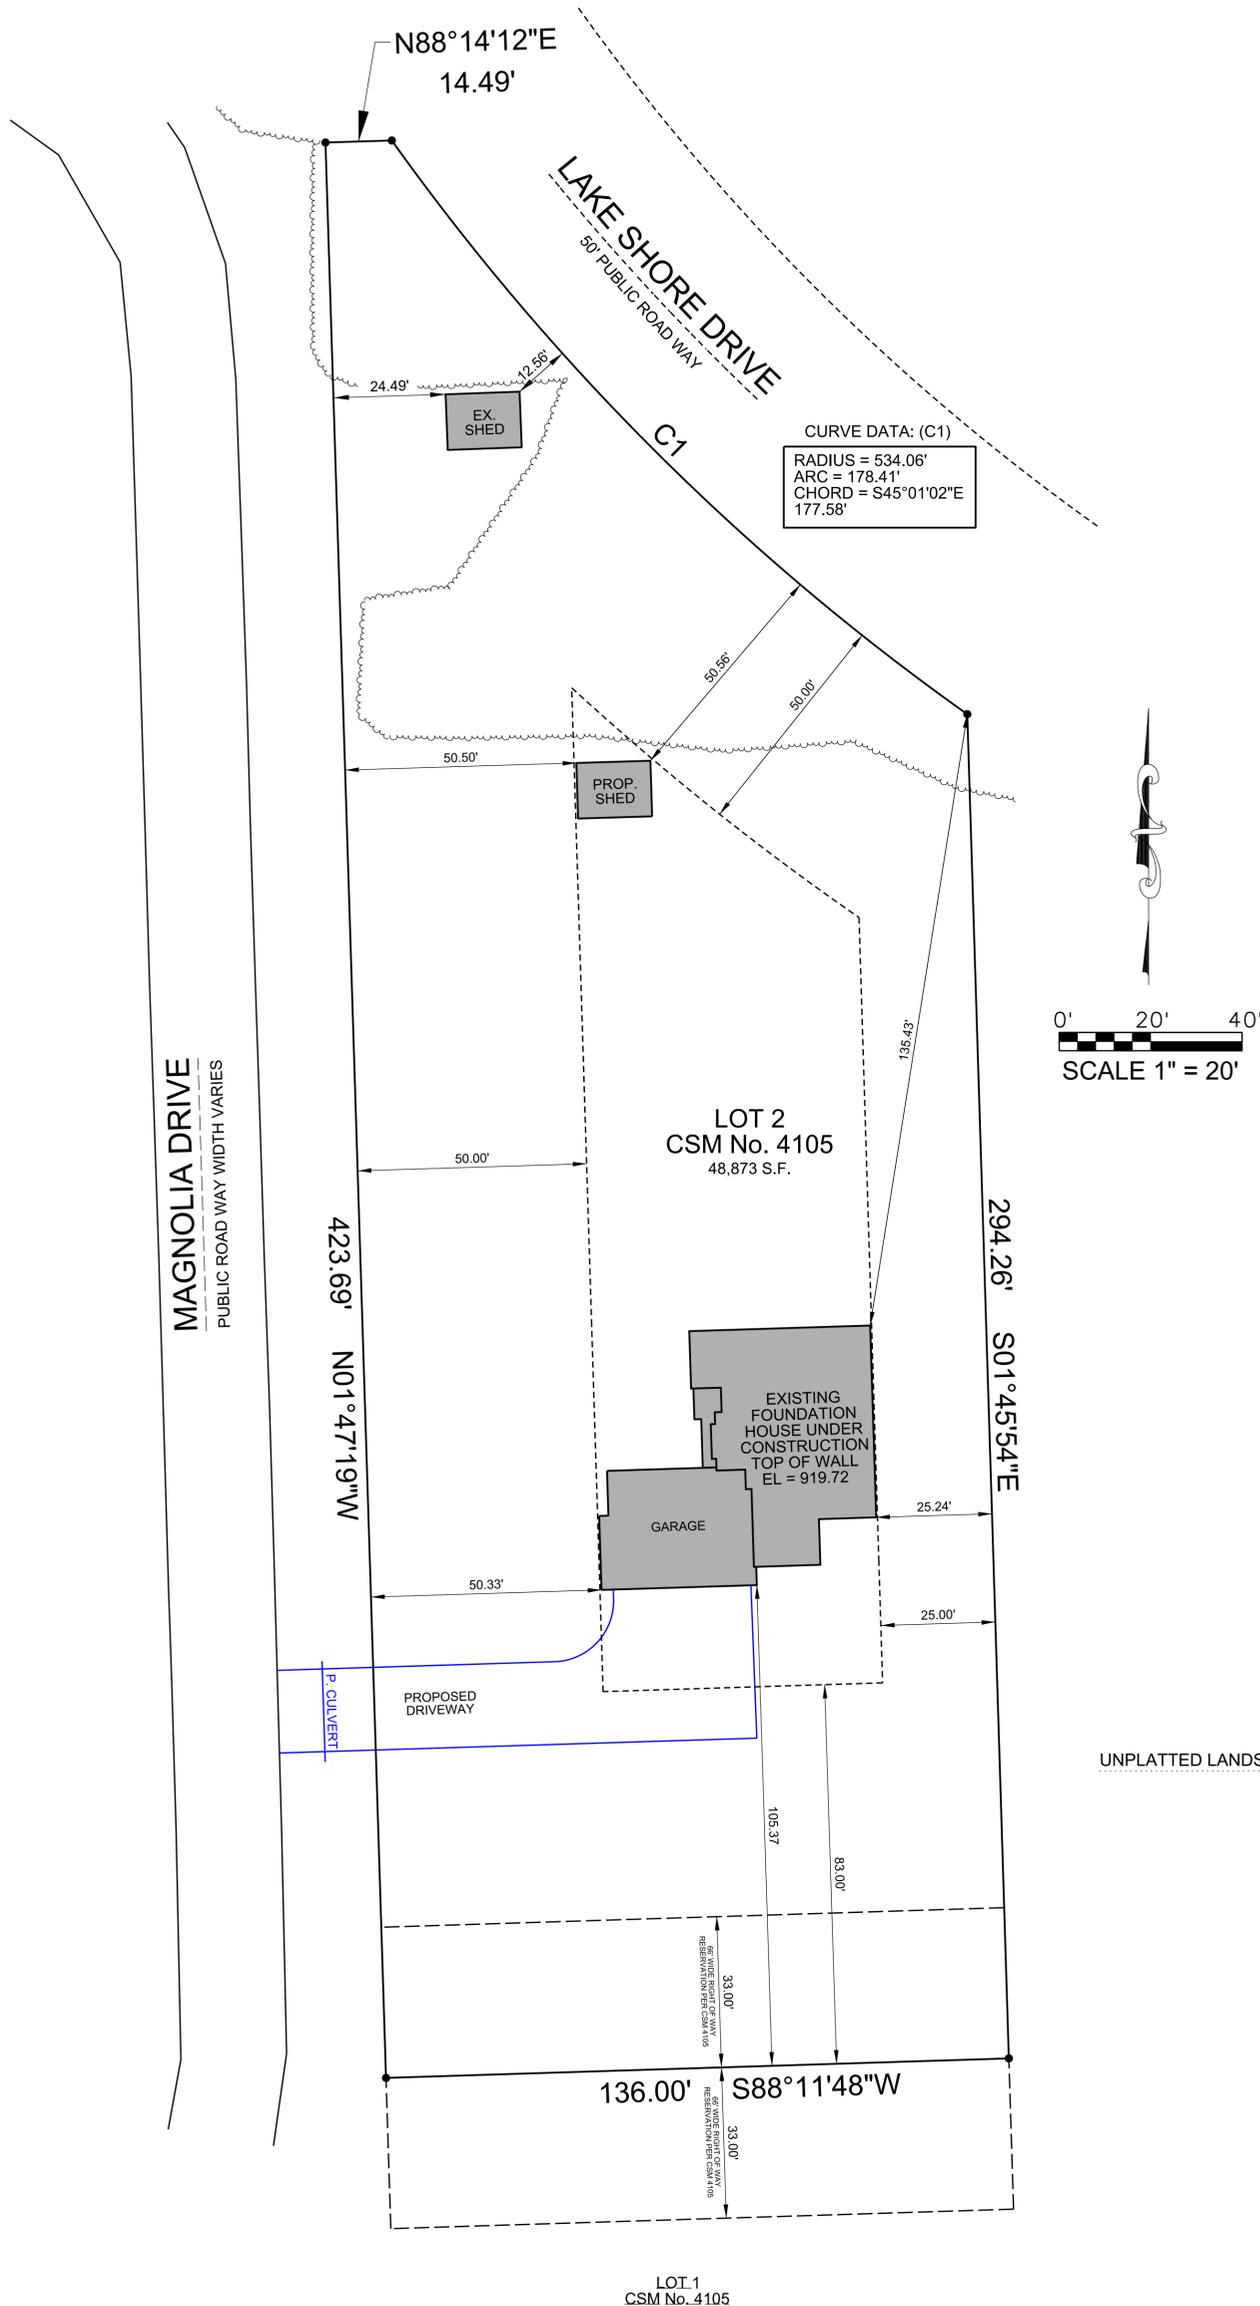

### LEGEND:

(100.00')	RECORDED DISTANCE
100.00'	MEASURED DISTANCE
●	1" FOUND IRON PIPE, UNLESS NOTED
⊗	¾" x 18" IRON PIPE SET, 1.13 lbs./L.F.
△	WELL
⊙	SEPTIC TANK
⊙	SEPTIC VENT
⊗	LIGHT POLE
⊞	ELECTRIC TRANSFORMER
⊞	ELECTRIC PEDESTAL
⊞	TELEPHONE PEDESTAL
⊞	CABLE TV PEDESTAL

**V<sup>2</sup>G SURVEYING, LLC**  
123 WOLF RUN - SUITE 4  
MUKWONAGO, WI 53149  
(262) 378-5097

DATE	ITEM
10/06/2021	PRELIM SURVEY
10/14/2021	PERMIT SURVEY
01/24/2022	FOUND. ASBUILT

THIS SURVEY IS MADE FOR THE USE OF THE PRESENT OWNERS OF THE PROPERTY, AND ALSO THOSE WHO PURCHASE, MORTGAGE OR GUARANTEE TITLE TO WITHIN ONE (1) YEAR FROM DATE HERETO.

I, MICHAEL A. GREESON P.L.S. #2770, HEREBY CERTIFY THAT THIS SURVEY WAS MADE IN ACCORDANCE WITH THE MINIMUM STANDARDS FOR PROPERTY SURVEYS (CHAPTER A-E 7) FOR THE STATE OF WISCONSIN AND HAS BEEN PREPARED UNDER MY DIRECTION AND CONTROL AND IS CORRECT TO THE BEST OF MY KNOWLEDGE AND BELIEF.

