


PLAT OF SURVEY
--OF--

—FO—

PART OF THE SOUTHEAST 1/4 OF SECTION 14, TOWNSHIP 3 NORTH, RANGE 18 EAST OF THE FOURTH PRINCIPAL MERIDIAN, TOWNSHIP OF SPRING PRAIRIE, COUNTY OF WALWORTH, STATE OF WISCONSIN AND MORE PARTICULARLY DESCRIBED AS FOLLOWS: COMMENCE AT A STONE MONUMENT AT THE SOUTH 1/4 CORNER OF SAID SECTION 14; RUN THENCE NORTH 00°06' WEST, ALONG THE NORTH-SOUTH 1/4 SECTION LINE OF SECTION 14, 978.30 FEET TO THE CENTER LINE OF POTTER ROAD; THENCE SOUTH 81°38'30" EAST, ALONG SAID CENTER LINE, 533.46 FEET TO THE PLACE OF BEGINNING OF PARCEL OF LAND HEREINAFTER DESCRIBED: THENCE CONTINUE SOUTH 81°38'30" EAST, ALONG SAID CENTER LINE, 152.66 FEET; THENCE NORTH 00°06' WEST, PARALLEL WITH THE NORTH-SOUTH 1/4 SECTION LINE OF SECTION 14, 477.93 FEET; THENCE NORTH 76°51'30" WEST, 206.16 FEET; THENCE SOUTH 19°40'30" EAST, 148.27 FEET; THENCE SOUTH 00°06' EAST, 363.00 FEET TO THE PLACE OF BEGINNING. CONTAINING 76,334 SQUARE FEET OF LAND. SUBJECT TO THE RIGHTS OF THE PUBLIC OVER THE SOUTH 33 FEET FOR HIGHWAY PURPOSES.

SURVEY FOR: ROBERT SCHULTHEIS

SURVEY ADDRESS: W660 POTTER ROAD

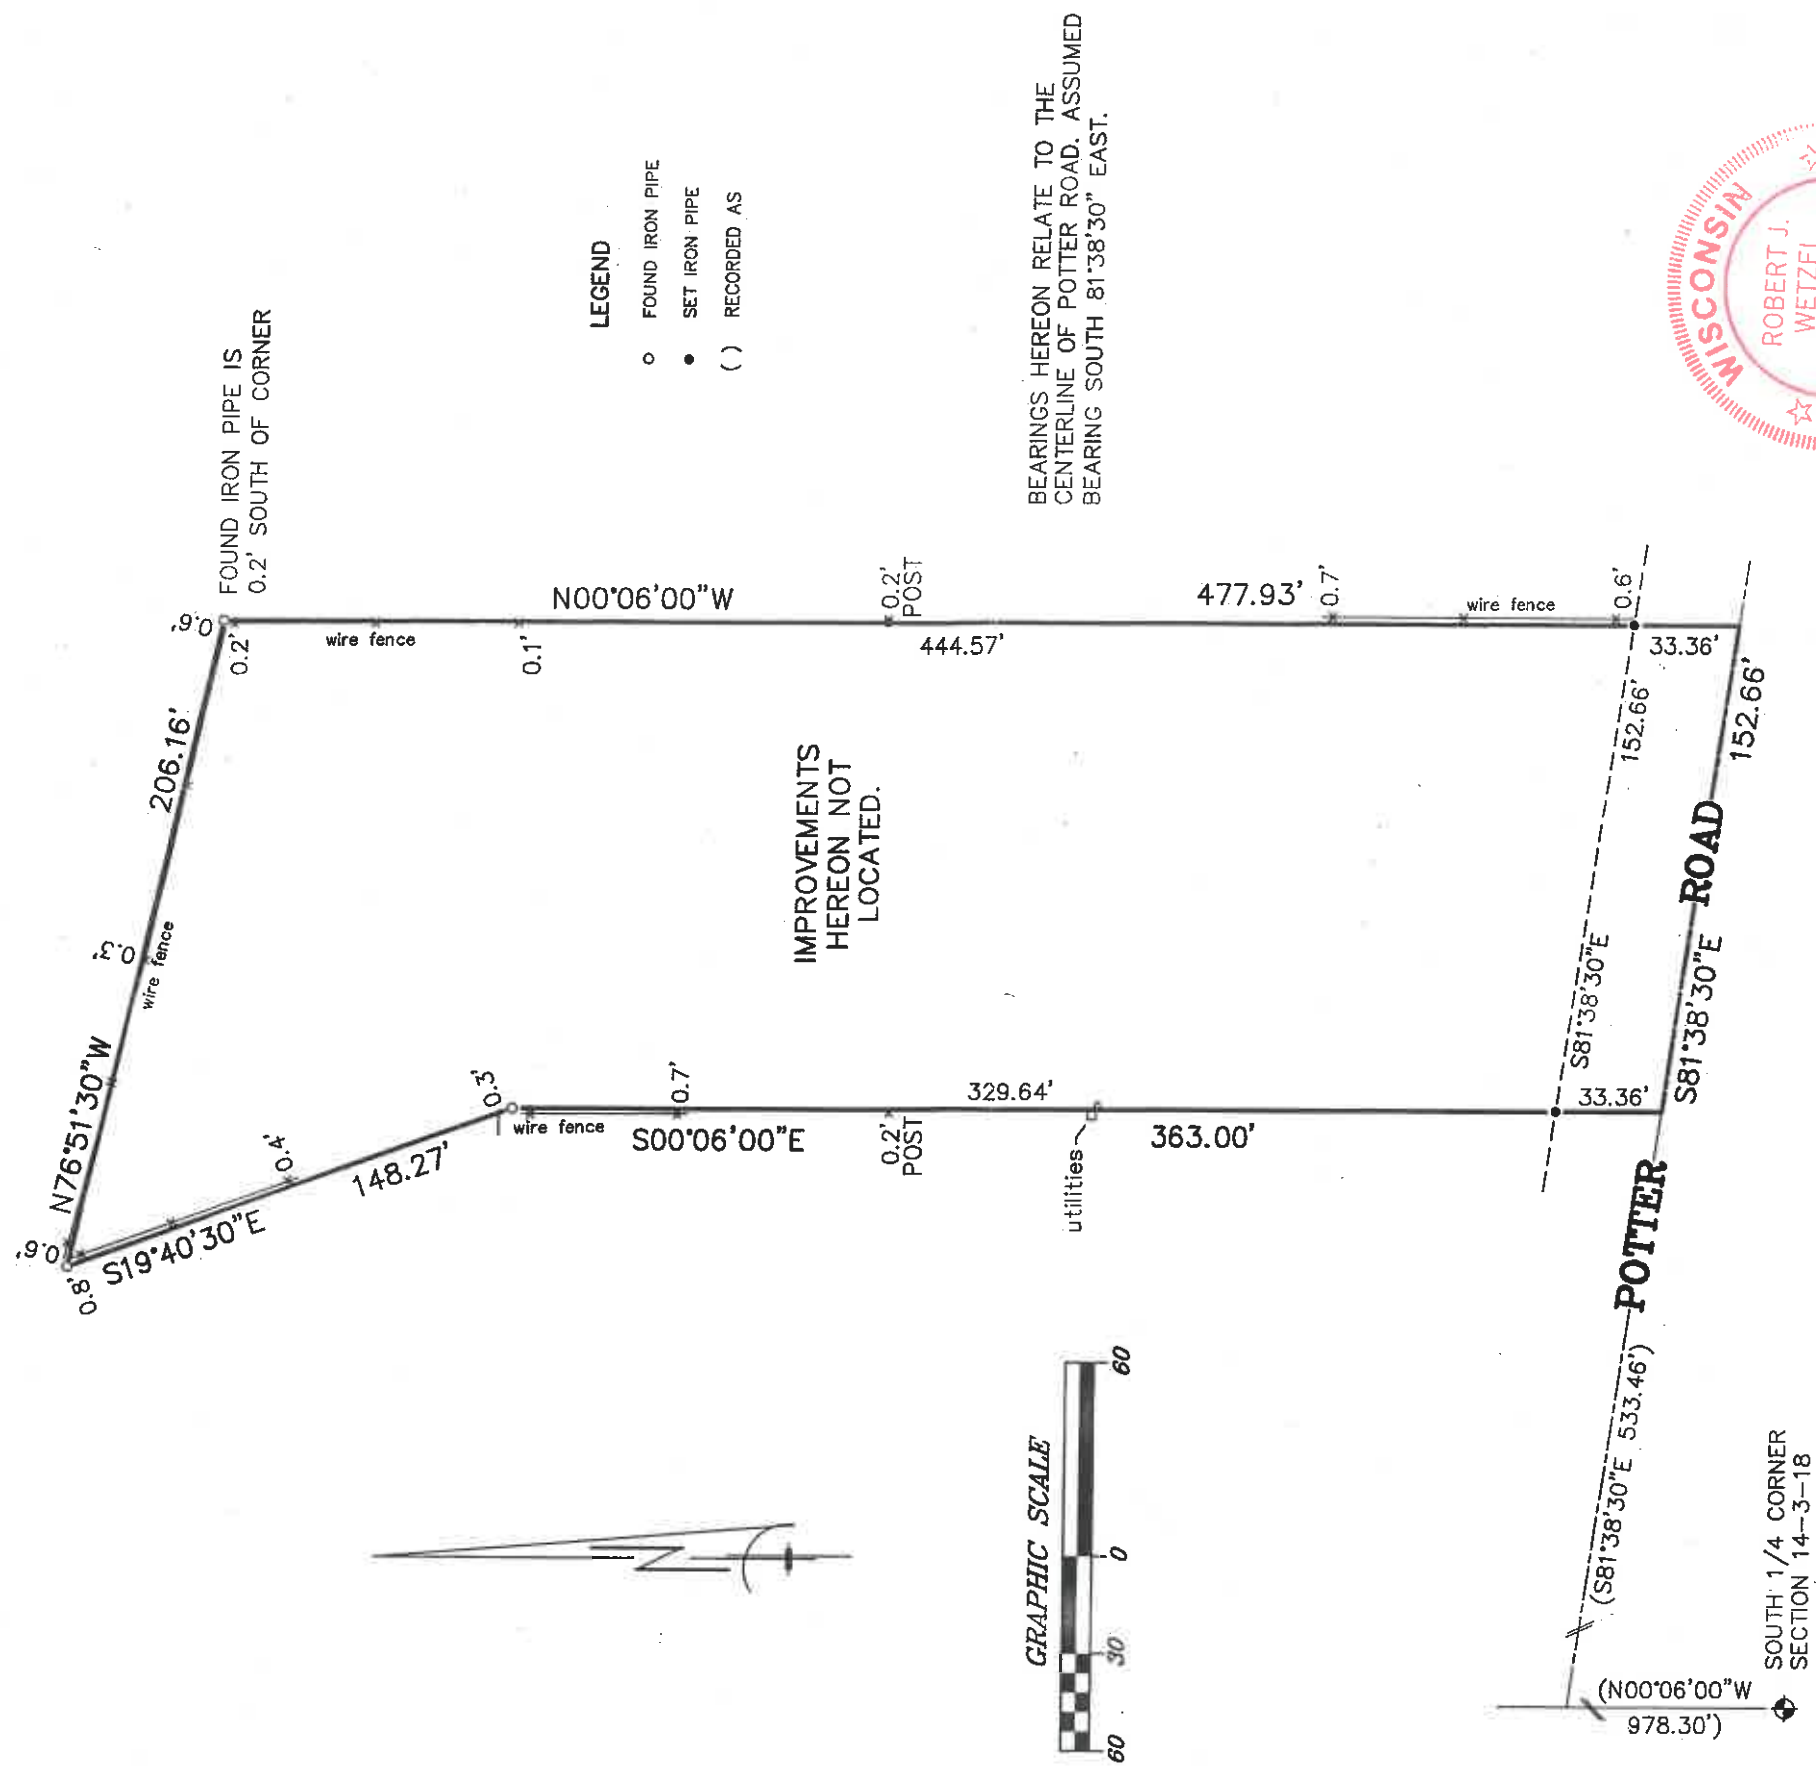

THIS IS NOT AN ORIGINAL PRINT
UNLESS THIS SEAL IS RED.

B.W. SURVEYING, INC.

LAND SURVEYS
MAPPING AND PLANNING
412 N. PINE STREET
BURLINGTON, WI 53105
(262)-767-0225

ROBERT J. WETZEL

S-1778

MARCH 22, 2022

DATE _____

10622

JOB NUMBER