

FARRIS, HANSEN & COOPER, INC.

ENGINEERING, SURVEYING AND LAND PLANNING
715 W. WALWORTH ST. - P.O. BOX 487 - ELKHORN, WI 53121
OFFICE: 414/723-2098

PLAT OF SURVEY OF LOT 1, BLOCK 10
AND LOTS 1 & 2 BLOCK 13 OF BLUE
WING ESTATES, TOWN OF SUGAR
CREEK, WALWORTH COUNTY
WISCONSIN

N



SCALE 1" = 40'

(xxx) = RECORD DIMENSION

Ø = IRON PIPE SURVEY STAKE FOUND

○ = IRON PIPE SURVEY STAKE SET

△ = CUT CROSS IN CONCRETE BASE FOR BIRDHOUSE AND

WORK ORDERED BY:

BERNARD SCHWARTZ
232 LAUNDALE
WILMETTE, ILL. 60091


I certify that I have surveyed the above described property and that the above map is a true representation thereof and shows the size and location of the property, its exterior boundaries, the location of all visible structures, boundary fences, apparent easements, roadways and visible encroachments, if any.

This survey is made for the use of the present owners of the property, and also those who purchase, mortgage, or guarantee the title thereto within one year from the date hereof.

Robert A. Farris
RLS - 1293

DATED THIS 29th DAY OF AUGUST 1980

DRAWING NUMBER 1742

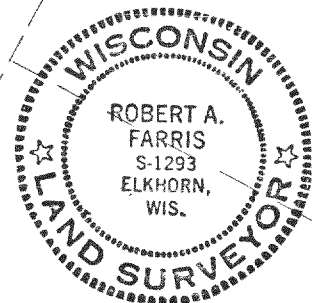

METAL STORAGE SHED ON CONCRETE SLAB

RESIDENCE

Portable Shed on Skids

SHORE

LAKE

BLOCK

BLOCK

680-18, 38