


Found no monuments
in this direction.
Much fill along
the lakefront.

MORTGAGE INSPECTION SURVEY

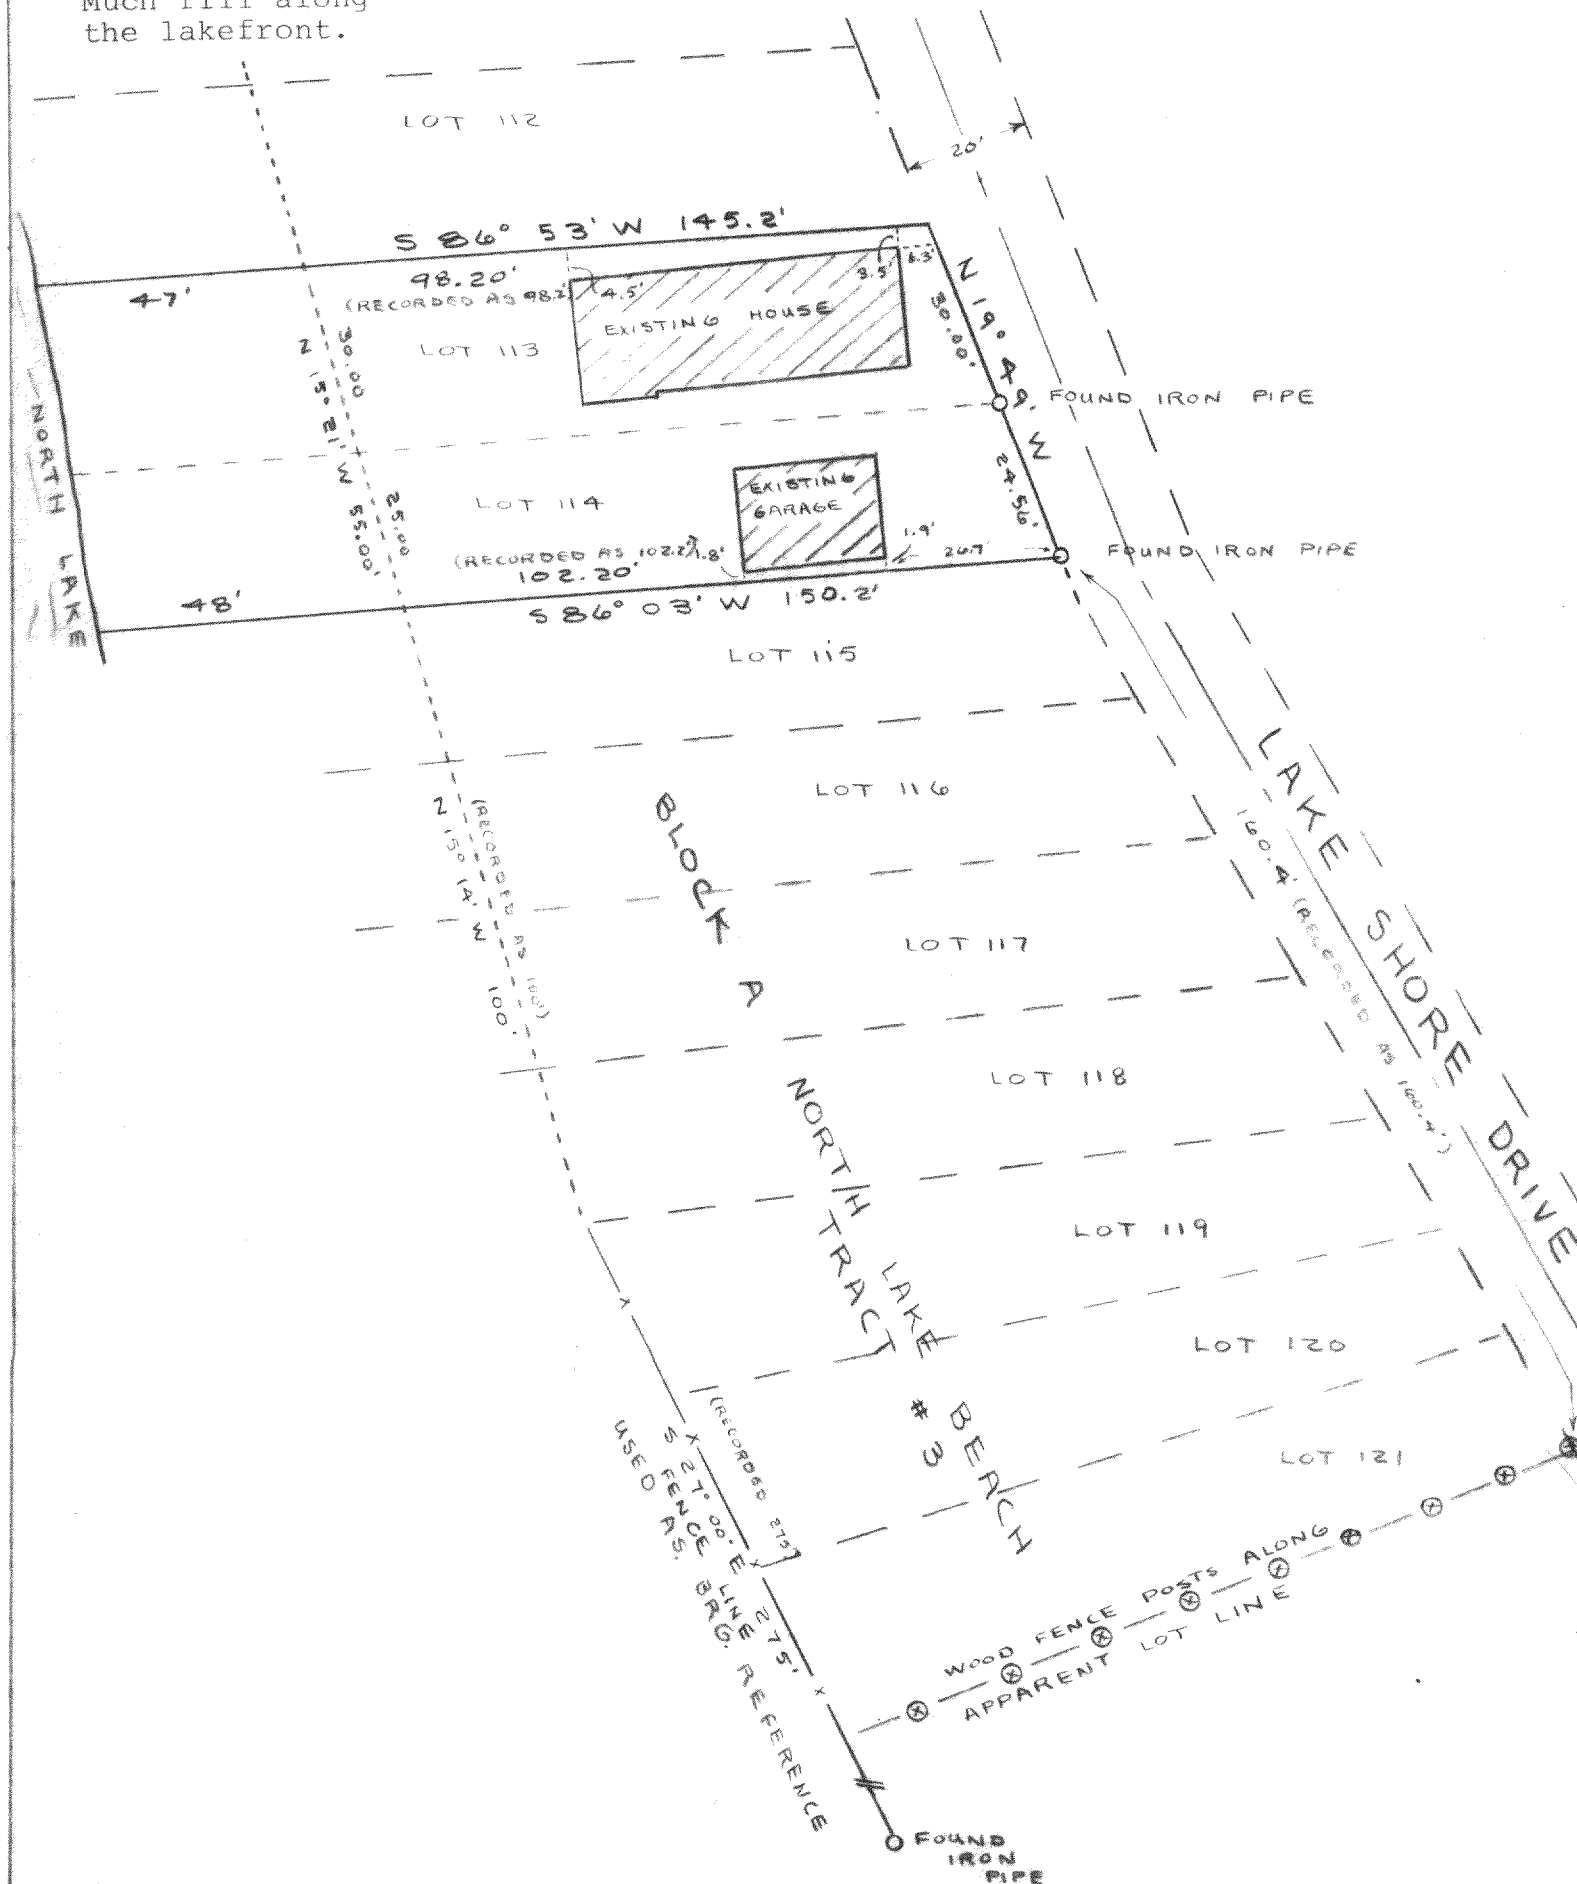

Note: This is not a "Property Survey" as defined in Sec. A-E 5.01 of the Wisconsin Administration Code.

SURVEY AND MAP BY:

Farris, Hansen & Cooper Inc.
715 W. Walworth St. P.O. Box 487
Elkhorn, Wisconsin 53121

SELLER: Richard Lightfield
BUYER: Robert W. & Karen S. Fox
PROPERTY: Route 2, Box 187
Elkhorn, Wisconsin 53121

WORK ORDERED BY: Sandra J. Butler for
Waukesha Savings and
Loan Association

LEGAL DESCRIPTION: Lot 113, Block A & Lot 114, Block A
North Lake Beach Tract #3, Town of Sugar
Creek, Walworth County, Wisconsin.

I hereby certify that this map is a true and accurate
representation of the lot lines and the buildings located
thereon to the best of my knowledge and belief.

Robert A. Farris
Robert A. Farris, RLS 1293,

Dated this 18th day of April, 1978

DRWG. NO. 1324 316-257