


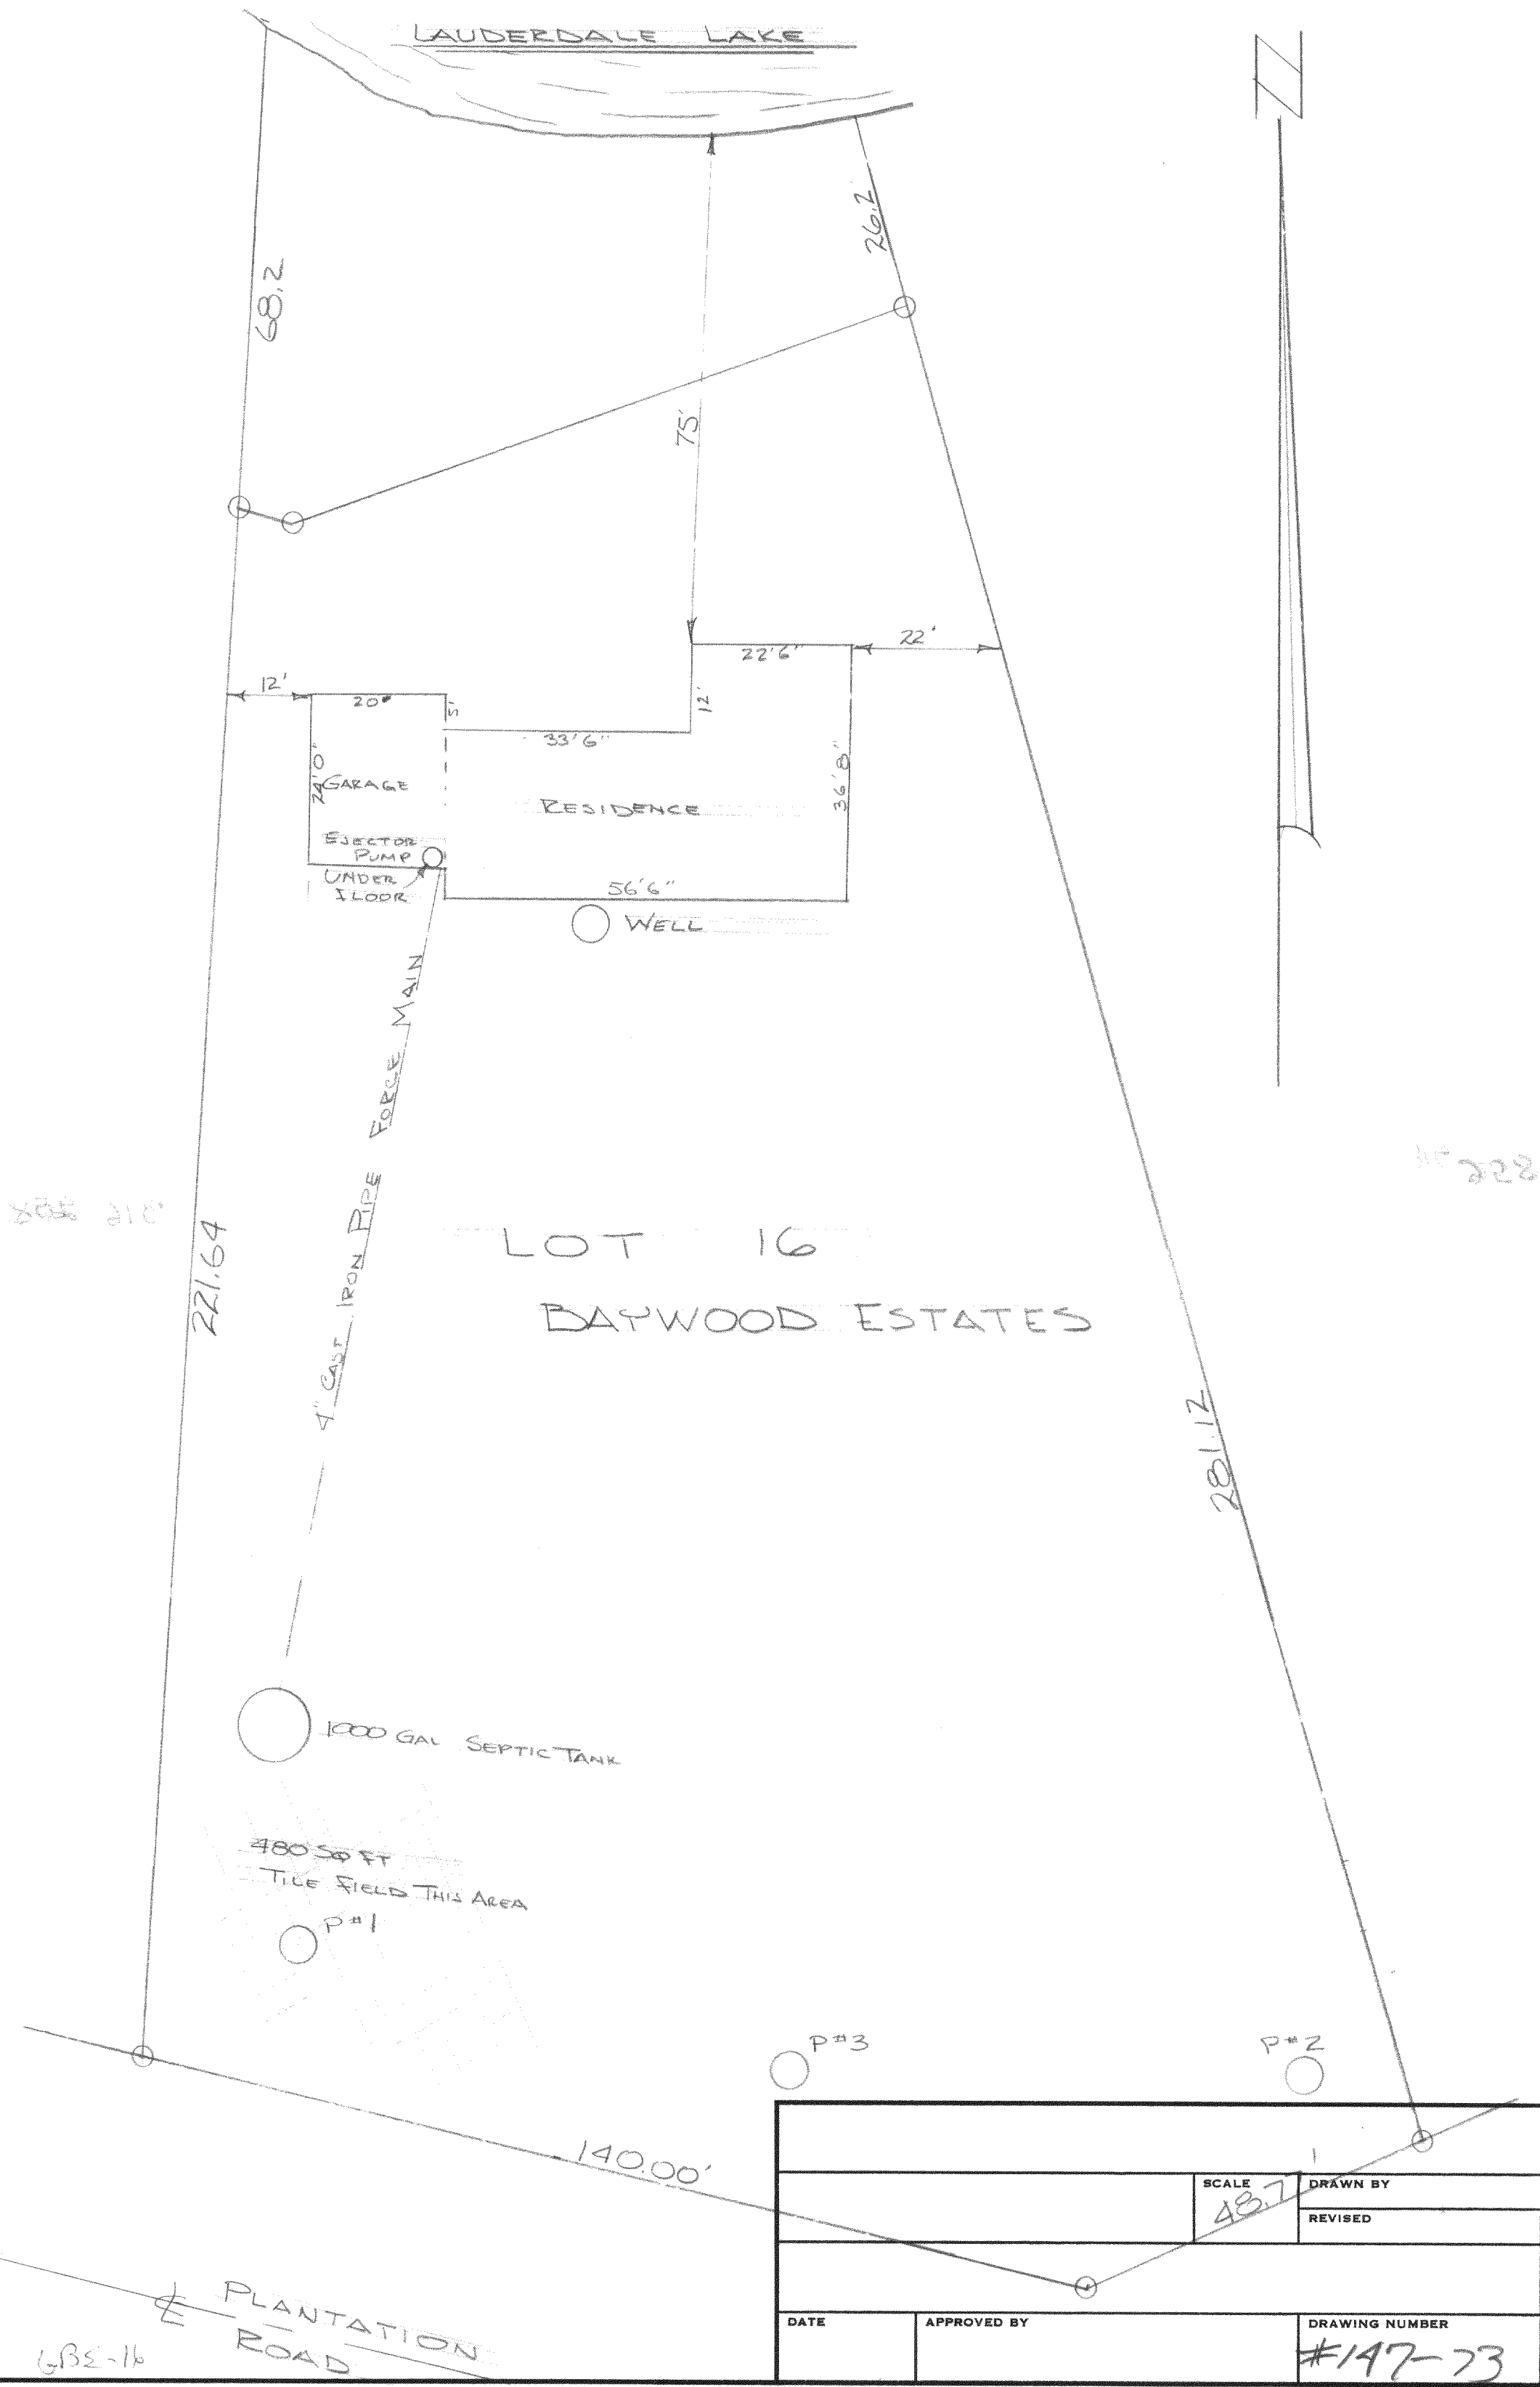

DATE		APPROVED BY		DRAWING NUMBER	
				#147-73	
SCALE		DRAWN BY		REVISED	
48.7					