


Building Permit Survey

Lot 3 Block II of Cool Hill
Park Addition No 2, Town of ~~La Grange~~ *Sugar Creek*
Walworth County, Wisconsin.

NINE-INDIANS

TRAIL

R. = 133.00'
ARC. L = 74.59'
CH. L = 73.62'
CH. B = S 75°-29'W
C.A. = 32°-08'-00"

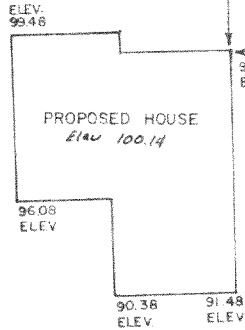

LOT 4


LOT 3

LOT 2

BLOCK II

SCALE: 1" = 40'

Bearing referenced to westerly
line of parcel assumed bearing
N 32°-55'W.

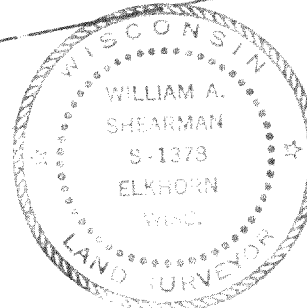

SURVEY AND PLAT BY
JENSEN & JOHNSON,
CIVIL ENGINEERS AND SURVEYORS

Elkhorn, Wisconsin

LEGEND

- — 1 3/16 Iron rod found.
- — 1 1/4 Iron pipe found.

WE CERTIFY: That we have surveyed the above described property and that the plat shown hereon is an accurate survey and a true representation thereof and correctly shows the exterior boundary lines and all divisions of said property to the best of my knowledge and belief.

Date

August 25, 1977 *William A. Shearman*
William A. Shearman

Wisconsin Registered Land Surveyor, No. S-1373

6CHB-3

Building Permit Survey


Lot 3 Block 11 of Cool Hill
Park Addition No 2, Town of La Grange
Walworth County, Wisconsin.

Sugar Creek

NINE-INDIANS

TRAIL

R. = 133.00'
ARC. L = 74.59'
CH. L = 73.62'
CH. B = S 75°-29'W
C.A. = 32°-08'-00"

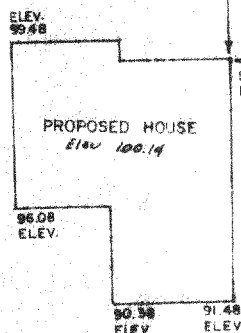


LOT 4


LOT 3

LOT 2

BLOCK 11

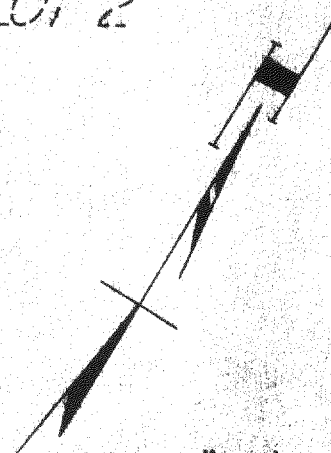

Bearing referenced to westerly
line of parcel assumed bearing
N 32°-55' W.

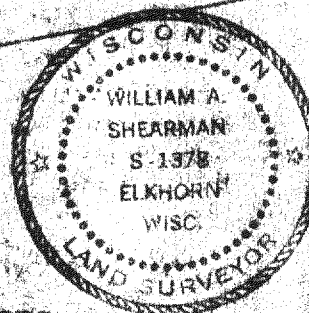

SURVEY AND PLAT BY
JENSEN & JOHNSON,
CIVIL ENGINEERS AND SURVEYORS
Elkhorn, Wisconsin

LEGEND

- — 1 3/16 Iron rod found.
- — 1 1/4 Iron pipe found.

WE CERTIFY: That we have surveyed the above described property and that the plat shown hereon is an accurate survey and a true representation thereof and correctly shows the exterior boundary lines and all divisions of said property to the best of my knowledge and belief.

Date *August 25, 1977* *William A. Shearman*
William A. Shearman

Wisconsin Registered Land Surveyor, No. S-1378

816-259