

Plat of Survey

of
Lots 58 - 64 in Block 5 of North Lake Shorewoods,
 recorded February 22, 1926 in Vol. 8 of Plats of Walworth County on Page 73 as Document
 Number 256205 and located in Government Lot 2 in the Northeast 1/4 of Section 5, Town 3
 North, Range 16 East, Town of Sugar Creek, Walworth County, Wisconsin.


South 1/4 Corner Section 31-4-16
 N89°44'27"E 30.71' (30.69')
 North 1/4 Corner Section 6-3-16
 N 278.448.90
 E 2,367.328.39

Blue Wing Road

House

Lot 1 Block 5 Blue Wing Estates

Center 1/4 Corner Section 6-3-16
 N 275.947.81
 E 2,367.471.10

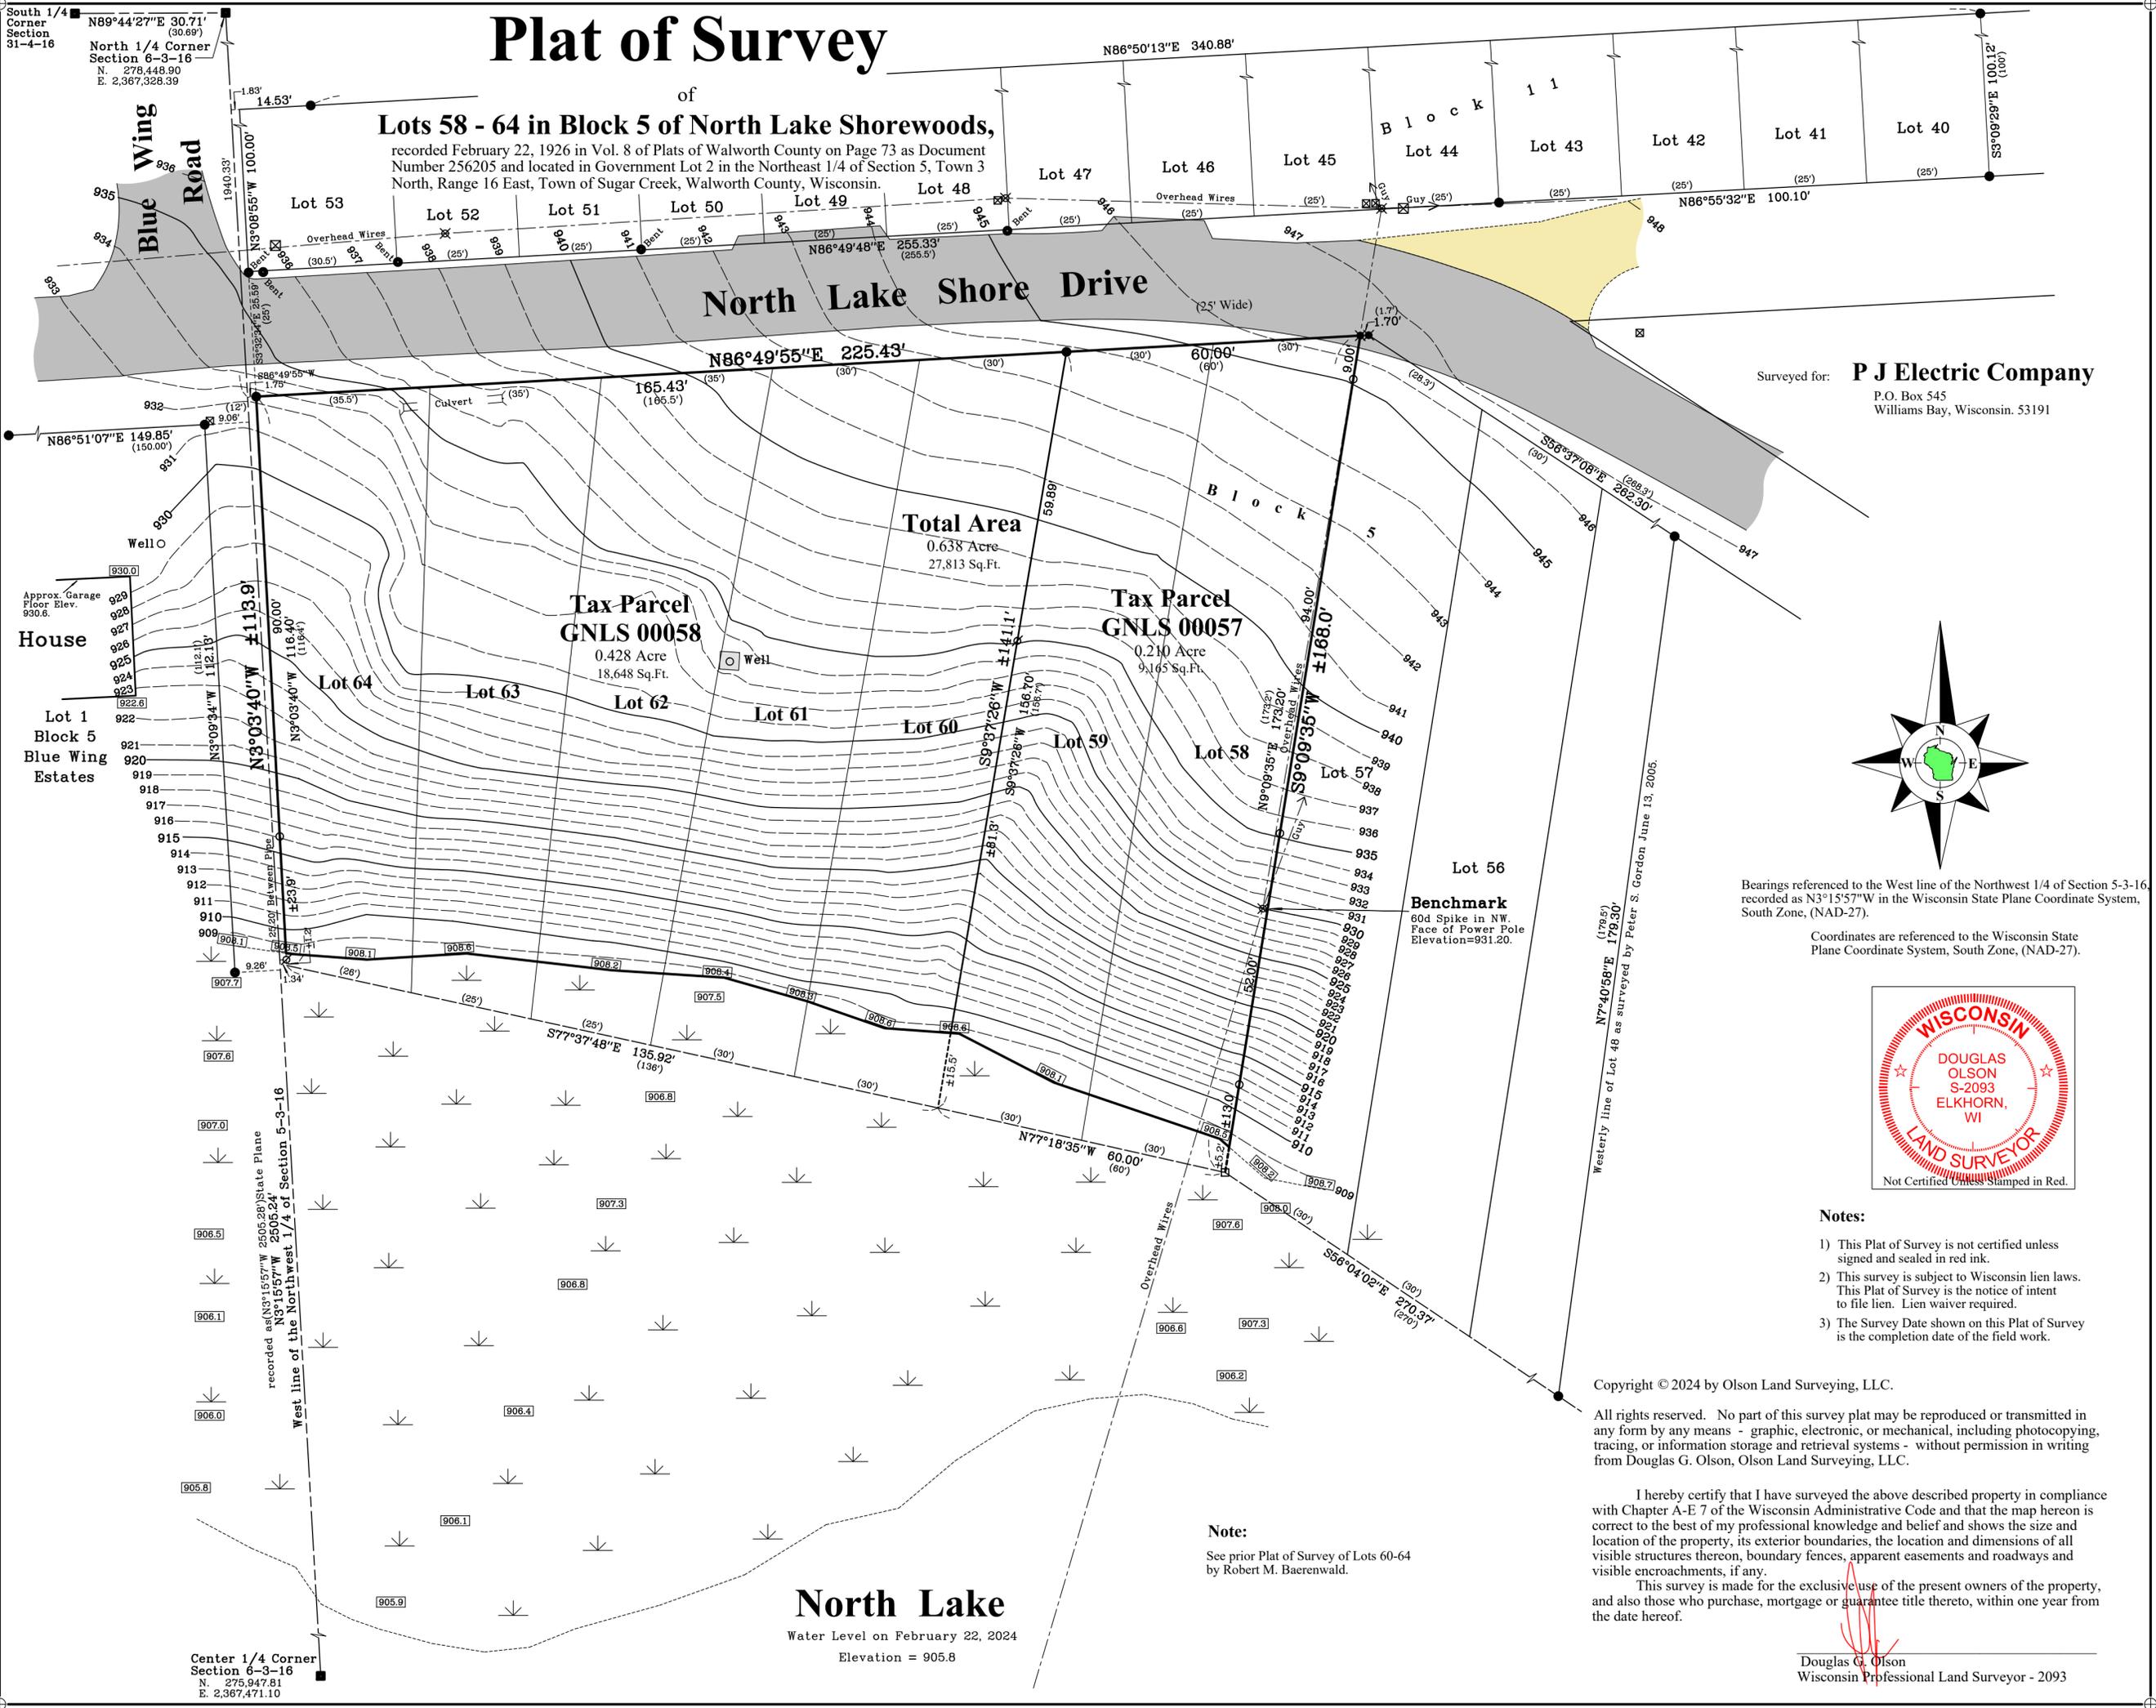

Surveyed for: **P J Electric Company**
 P.O. Box 545
 Williams Bay, Wisconsin. 53191



Bearings referenced to the West line of the Northwest 1/4 of Section 5-3-16, recorded as N3°15'57"W in the Wisconsin State Plane Coordinate System, South Zone, (NAD-27).

Coordinates are referenced to the Wisconsin State Plane Coordinate System, South Zone, (NAD-27).



- Notes:**
- 1) This Plat of Survey is not certified unless signed and sealed in red ink.
 - 2) This survey is subject to Wisconsin lien laws. This Plat of Survey is the notice of intent to file lien. Lien waiver required.
 - 3) The Survey Date shown on this Plat of Survey is the completion date of the field work.

Copyright © 2024 by Olson Land Surveying, LLC.

All rights reserved. No part of this survey plat may be reproduced or transmitted in any form by any means - graphic, electronic, or mechanical, including photocopying, tracing, or information storage and retrieval systems - without permission in writing from Douglas G. Olson, Olson Land Surveying, LLC.

I hereby certify that I have surveyed the above described property in compliance with Chapter A-E 7 of the Wisconsin Administrative Code and that the map hereon is correct to the best of my professional knowledge and belief and shows the size and location of the property, its exterior boundaries, the location and dimensions of all visible structures thereon, boundary fences, apparent easements and roadways and visible encroachments, if any.

This survey is made for the exclusive use of the present owners of the property, and also those who purchase, mortgage or guarantee title thereto, within one year from the date hereof.

Douglas G. Olson
 Wisconsin Professional Land Surveyor - 2093

Survey Date: February 22, 2024.
 Revisions: No. 1 - Misc.



45 South Wisconsin Street | P.O. Box 322
 Elkhorn, Wisconsin. 53121
 Telephone: (262) 723-3434
 Facsimile: (262) 723-8044
 Email: doug@olsonsurveying.com
 Website: www.olsonsurveying.com

OLSON
 LAND SURVEYING, LLC
 Rural | Residential | Commercial

Legend of Symbols & Abbreviations

- North County Section Corner
- Found Iron Pipe
- Found Iron Peg
- Sound Iron Peg
- Recorded Information
- Utility Pole
- Asphalt Surface
- Concrete Surface
- Gravel Surface

Sheet 1 of 1 Sheets
 Drawing Name:
 Job Reference Number
2024.006
2024.006