

FARRIS, HANSEN & COOPER, INC.

WARREN E. HANSEN
PROFESSIONAL ENGINEER

ENGINEERING, SURVEYING AND LAND PLANNING
715 W. WALWORTH ST. - P.O. BOX 487 - ELKHORN, WI 53121
OFFICE: 414/723-2098

DANIEL D. COOPER
ROBERT A. FARRIS
LAND SURVEYOR

ENGINEERING
MUNICIPAL - STRUCTURAL
HIGHWAYS - PUBLIC WORKS


SURVEYING & PLANNING
SUBDIVISIONS - LOT SURVEYS
CONSTRUCTION STAKING - MAPPING

MORTGAGE INSPECTION SURVEY

Lots 1, 2, and the Westerly 1/2 of Lot 3 in Block 16 of Interlaken Subdivision,
Town of Sugar Creek, Walworth County, Wisconsin.

PARK ROAD 50' WIDE


ASPEN ROAD 50' WIDE

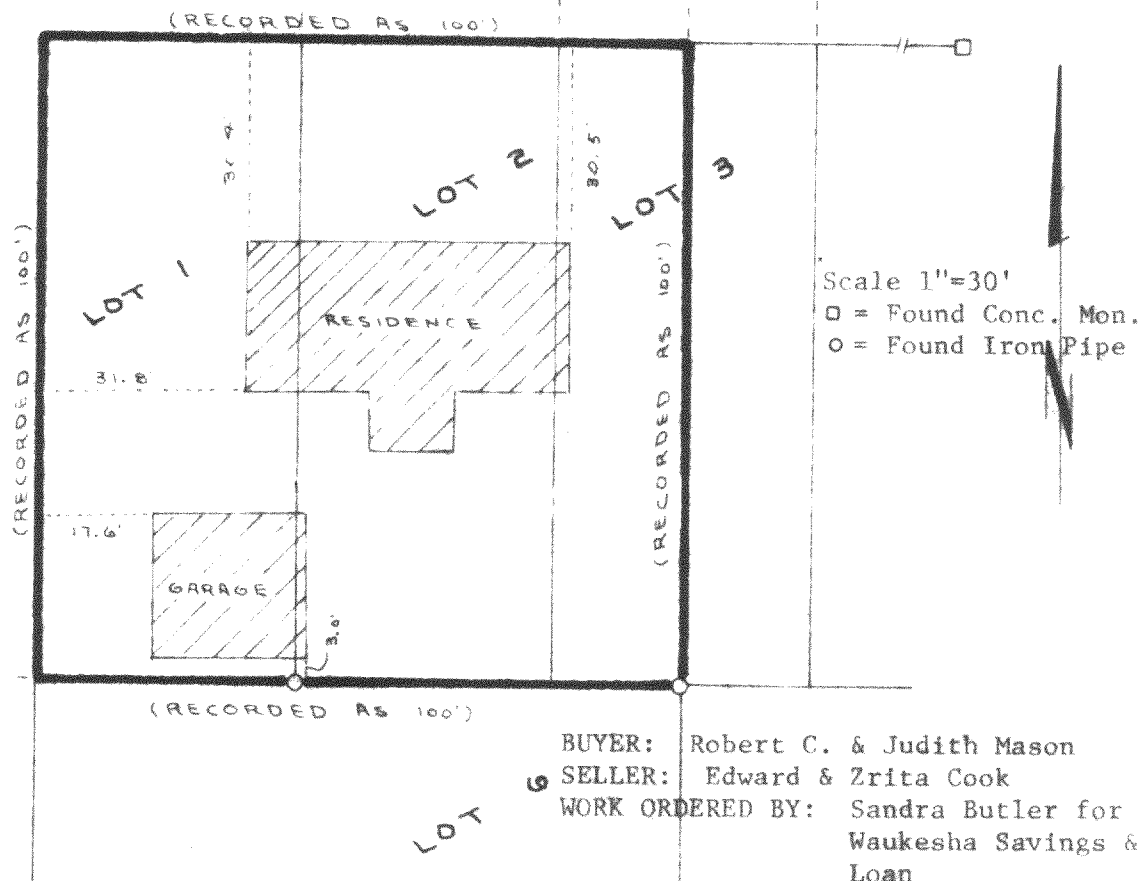

NOTE: This is not a "Property Survey" as defined in Section AE-5.01 of the Wisconsin Administrative Code.

I hereby certify that this map is a true representation of the Lot Lines and Buildings located thereon to the best of my knowledge & belief.

Dated This 4th Day Of Aug., 1978. Robert A. Farris
Robert A. Farris, RLS

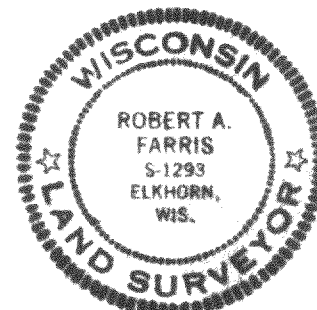

Drawing No. 1372

61-194

316-263V