

PLAT OF SURVEY


OF LOTS 6, 7, 8 AND 9, BLOCK 32, OF THE THIRD MAP OF INTERLAKEN, ALSO THAT PART OF VACATED ROSEWOOD ROAD AS DESCRIBED IN DOCUMENT No. 315421, BEING A PART OF THE NW 1/4 OF THE SE 1/4 OF SECTION 11, T.3N., R.16E. OF THE 4TH P.M. TOWN OF SUGAR CREEK, WALWORTH COUNTY, WISCONSIN.

MONUMENT KEY

- Iron Rebar Set
3/4" x 24" (1.5 Lbs./Ft.)
- ⊙ 3/4" Iron Rebar Found
- Wooden Lath Set on Line
- ⊙ Iron Pipe Found
- (XXX.XX) Record Information

LEGEND

- Existing Boundary Line
- - - Existing Right-of-Way
- - - Existing Adjacent Property
- - - Existing Easement Line
- x Existing Fence
- PW Existing Well
- T Existing Transformer
- ST Existing Septic Tank
- ⊙ Existing Septic Vent
- ⊙ Existing Telephone Pedestal
- ⊙ Existing Utility Pole
- ⊙ Existing Mailbox
- ⊙ Existing Flag Pole

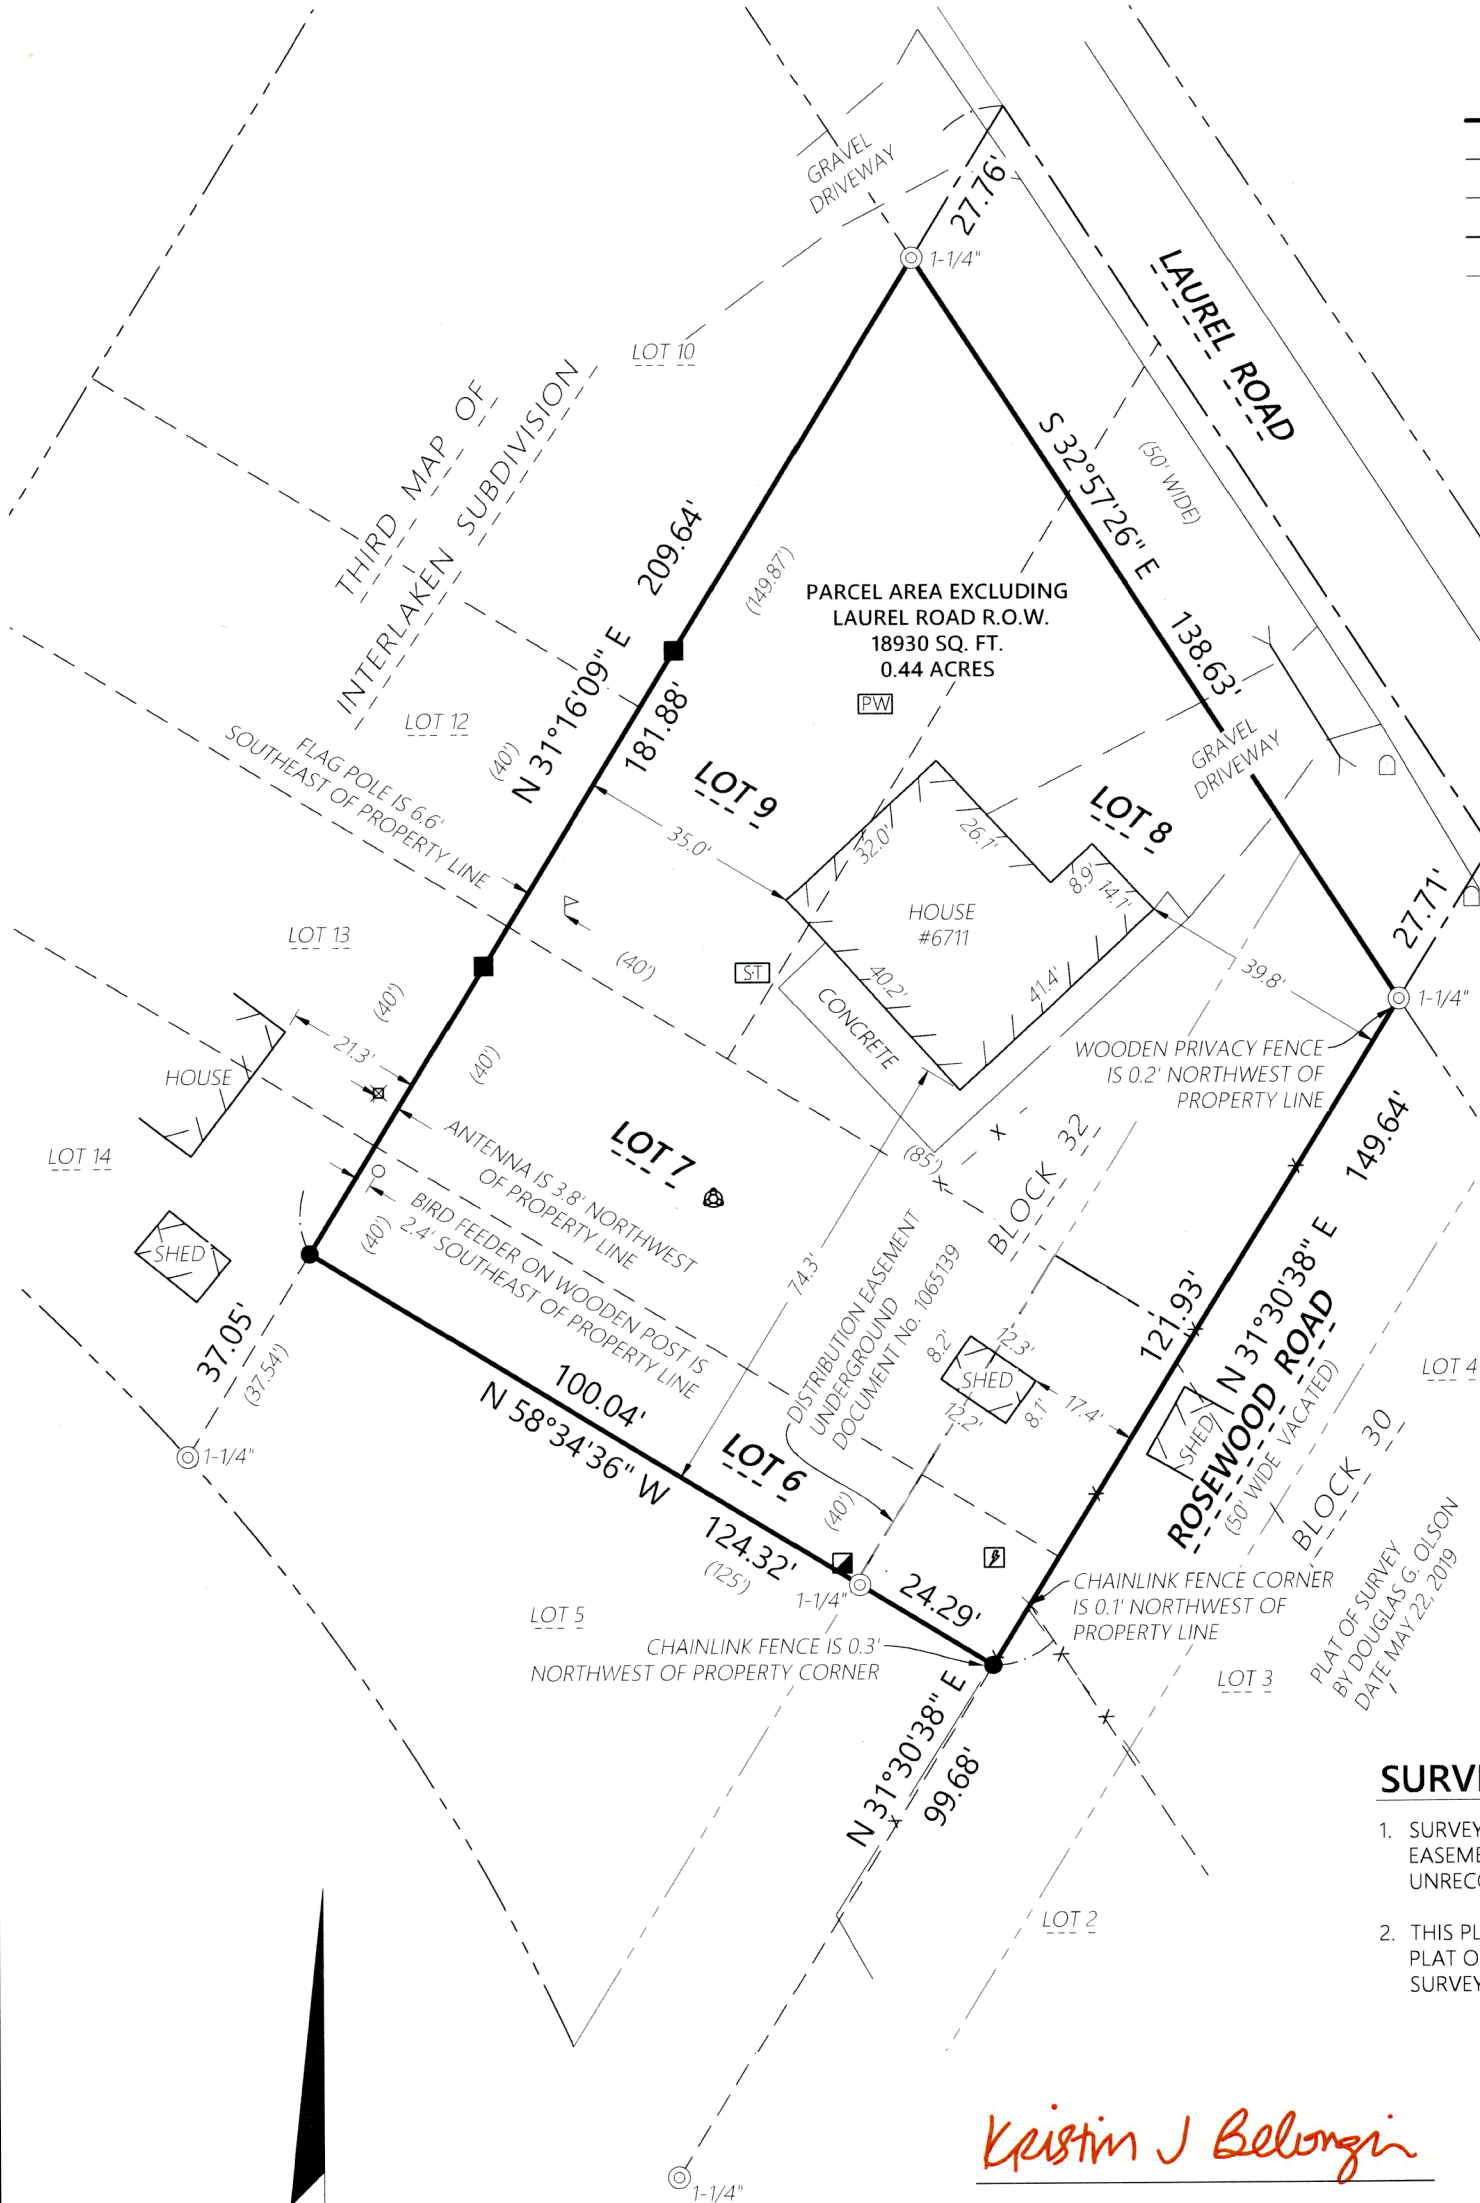

SURVEY NOTES

1. SURVEYED PROPERTY SUBJECT TO ANY AND ALL EASEMENTS AND AGREEMENTS RECORDED AND UNRECORDED.
2. THIS PLAT OF SURVEY IS A RETRACEMENT OF A PLAT OF SURVEY PREPARED BY LAND-MARK SURVEYING DATED NOVEMBER 8TH, 2004.

Kristin J Belongia


Kristin J. Belongia, P.L.S.
Wisconsin Professional Land Surveyor S-2943

State of Wisconsin } ss
County of Walworth }

I hereby certify that I have supervised the survey of the property described above and to the best of my knowledge and belief, the plat drawn hereon complies with Chapter A-E 7 of the State of Wisconsin Administrative Code, Minimum Standards for Property Surveys and correctly represents said survey and its location.

Given under my hand and seal at Elkhorn, Wisconsin this 17th day of March, 2024.
Last day of field work March 7, 2025

If the surveyor's signature is not red in color, the plan is a copy that should be assumed to contain unauthorized alterations. The certification contained on this document shall not apply to any copies.

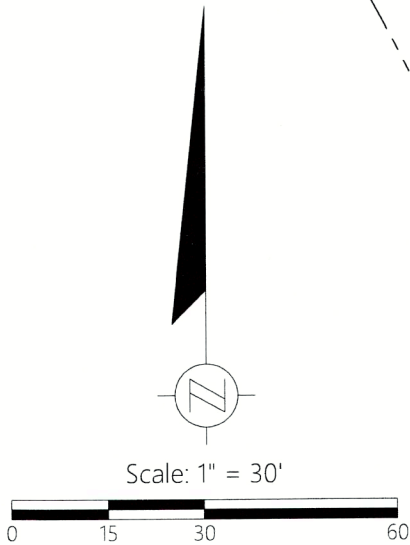

DISTANCE UNITS BASED ON THE UNITED STATES SURVEY FOOT
BEARINGS BASED ON THE WISCONSIN COORDINATE REFERENCE SYSTEM, WALWORTH ZONE. THE NORTH LINE OF LOTS 6, 7, & 9 BEARING N 31°16'09" E.

ORDER NO: 35437

FIELD CREW: DGM
DRAWN BY: DGM
SHEET 1 OF 1

FOR THE EXCLUSIVE USE OF:
STEVE STAEDTER
N6711 LAUREL ROAD
ELKHORN, WI 53121

PLAT OF SURVEY

Batterman
engineers surveyors planners
BELOIT | ELKHORN | JANESVILLE
2857 S. Bartells Dr., Beloit, WI 53511
608.365.4464 | www.rhbatterman.com

