


# Plat of Survey

of



## Lot 74 of Baywood Estates 3rd Addition,

recorded April 14, 1980 in Cab. B of Plats of Walworth County on Slide 47 as Document Number 57431 and located in the Northeast 1/4 of the Northwest 1/4 of Section 1, Town 3 North, Range 16 East, Town of Sugar Creek, Walworth County, Wisconsin.

Surveyed for: **Tim May**  
W5125 Hares Foot Road  
Elkhorn, Wisconsin. 53121

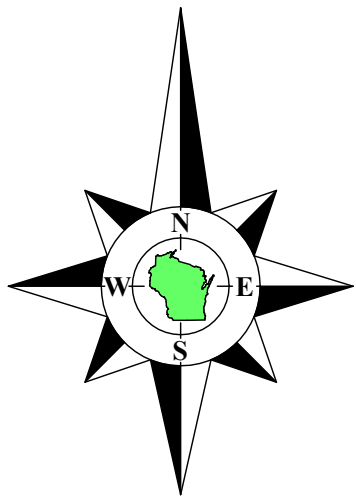

Bearings referenced to the South line of Lots 74 and 75,  
recorded as N87°46'05"W on the plat of Baywood Estates  
3rd Addition.

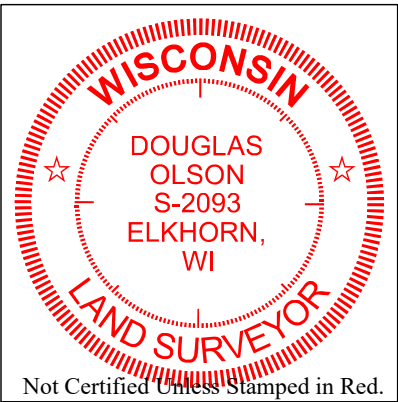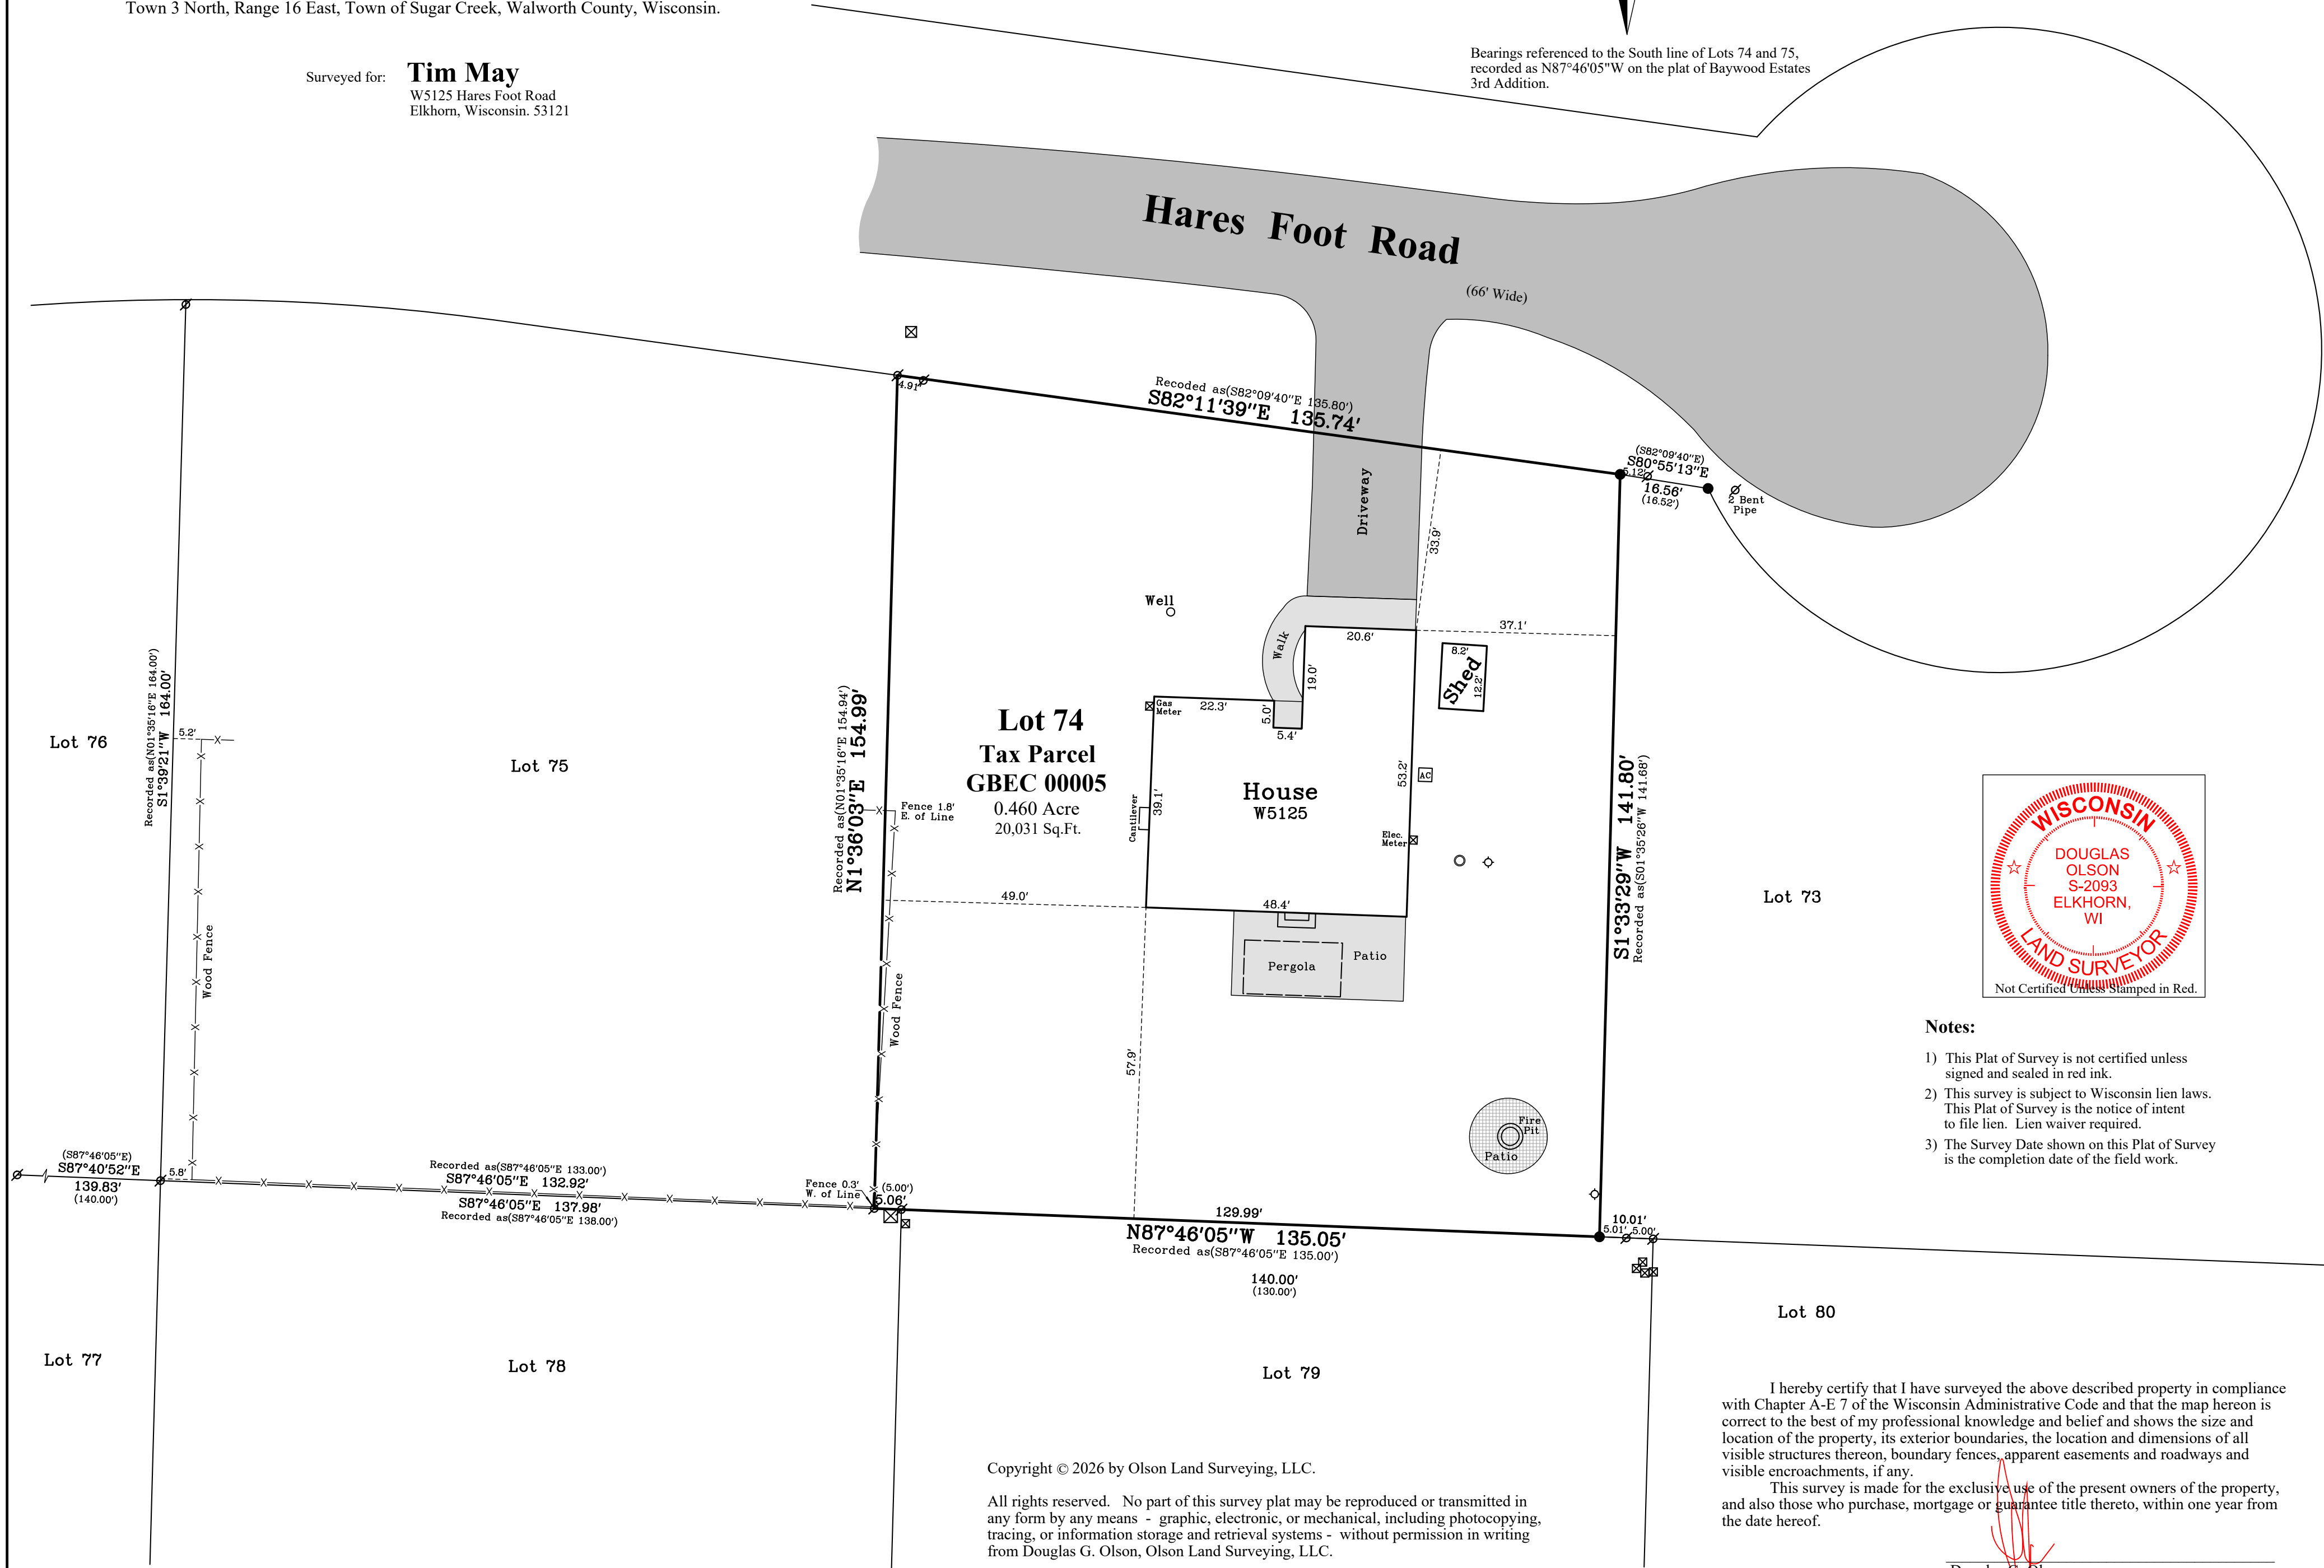

### Notes:

- 1) This Plat of Survey is not certified unless signed and sealed in red ink.
- 2) This survey is subject to Wisconsin lien laws. This Plat of Survey is the notice of intent to file lien. Lien waiver required.
- 3) The Survey Date shown on this Plat of Survey is the completion date of the field work.


I hereby certify that I have surveyed the above described property in compliance with Chapter A-E 7 of the Wisconsin Administrative Code and that the map hereon is correct to the best of my professional knowledge and belief and shows the size and location of the property, its exterior boundaries, the location and dimensions of all visible structures thereon, boundary fences, apparent easements and roadways and visible encroachments, if any.

This survey is made for the exclusive use of the present owners of the property, and also those who purchase, mortgage or guarantee title thereto, within one year from the date hereof.


Douglas G. Olson  
Wisconsin Professional Land Surveyor - 2093

Survey Date: May 15, 2026.

Revisions:

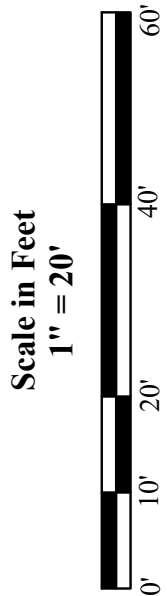

45 South Wisconsin Street | P.O. Box 322  
Elkhorn, Wisconsin. 53121  
Telephone: (262) 723-3434  
Facsimile: (262) 723-8044  
Email: doug@olsonsurveying.com  
Website: www.olsonsurveying.com

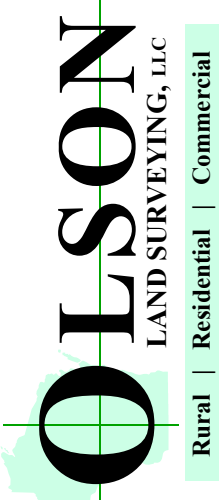

| Legend of Symbols & Abbreviations |            |
|-----------------------------------|------------|
| N North                           | ° Degrees  |
| S South                           | ' Minutes  |
| E East                            | \" Seconds |
| W West                            | \" Feet    |
| Found Iron Pipe                   | \" Inches  |
| Found Iron Rod                    |            |
| Recorded Information              |            |
| Utility Box or Pedestal           |            |
| Concrete Cover                    |            |
| Septic Vent                       |            |
| Septic Surface                    |            |
| Brick Pavers                      |            |

Sheet 1 of 1 Sheets

Drawing Name:

Job Reference Number

2026.025

2026.025

Copyright © 2026 by Olson Land Surveying, LLC.

All rights reserved. No part of this survey plat may be reproduced or transmitted in any form by any means - graphic, electronic, or mechanical, including photocopying, tracing, or information storage and retrieval systems - without permission in writing from Douglas G. Olson, Olson Land Surveying, LLC.