

MORTGAGE INSPECTION SURVEY

WORK ORDERED BY: First National
Bank--Duane D.
Katzman

LEGEND

- Iron Pipe Found
C—"Posey" Iron Pin Found
()—Record Dimension

SCALE: 1"=30'

NOTE: THIS IS NOT A "PROPERTY SURVEY" AS DEFINED IN SEC. A-E 5.01 OF THE WISCONSIN ADMINISTRATIVE CODE.

I hereby certify that this map is a true and accurate representation of the lines described and the location of the buildings thereon to the best of my knowledge and belief.


Robert A. Farris

Robert A. Farris
Wis. Reg. Surveyor, S-1293

31 Aug. 1978
Date

Date _____

GW H-6

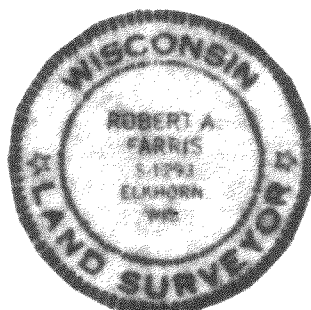

DRAWING NO. 1393

316-271