


MORTGAGE INSPECTION SURVEY

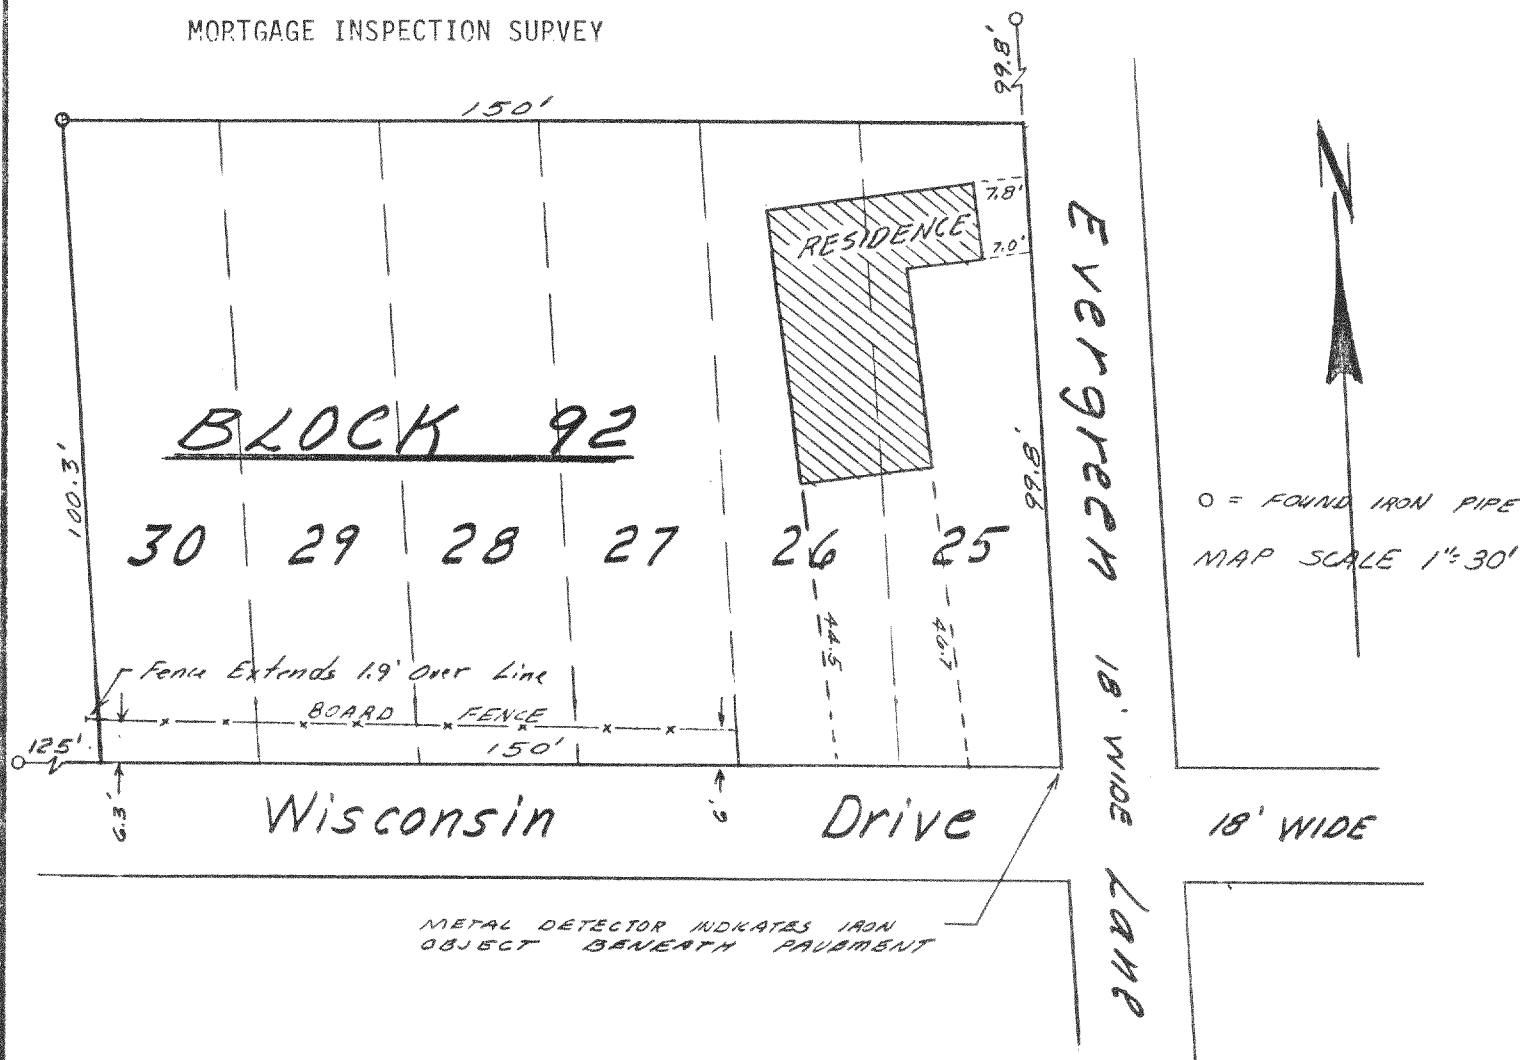

NOTE: This is not a "Property Survey" as defined in Section AE-5.01 of the Wisconsin Administrative Code.


LEGAL DESCRIPTION: Lots 25,26,27,28,29 and 30 inclusive, Block 92, Lake Wandawega Subdivision, Town of Sugar Creek, Walworth County, Wisconsin

BUYER: Ronnie Gough

SELLER: Walter Lauman

WORK ORDERED BY: Johnston Mortgage Corporation

I HEREBY CERTIFY that this map is a true and accurate representation of the lot lines and of the building located thereon to the best of my knowledge and belief.

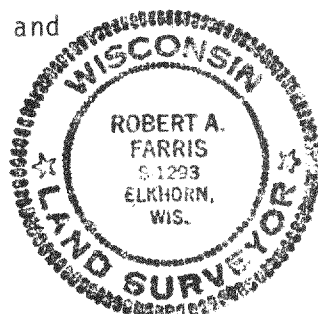

Robert A. Farris
ROBERT A. FARRIS, RLS
DATED THIS 12th DAY OF Sept. 1978

FARRIS, HANSEN & COOPER, INC.

715 W. WALWORTH AVE. P.O. BOX 487
ELKHORN, WISCONSIN 53121
TELEPHONE 414-723-2000

DRAWING NO. 1398