


54 core
55 34 4-16

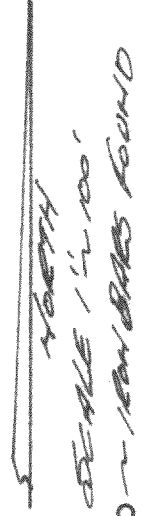

Dec. 19, 1978

WISCONSIN STATE LAND SURVEYOR

THOMAS P. A. JENSEN
STATE
ELKHORN, WIS.

316-275 J

79 10/10/2000 10:10:10