



DESCRIPTION: Lots 18, 19, and 20 of Block 34, Map 3 of Interlaken, a Subdivision located in Section 11, T3N R16E, Walworth County, Wisconsin.

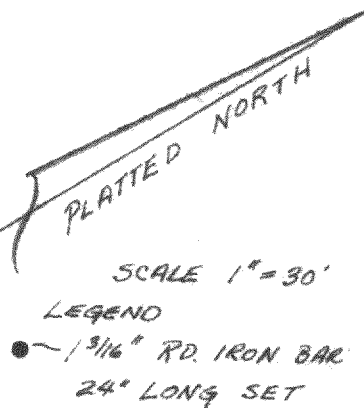

OWNER: R. SIMONSON
Box 51
Eagle, Wis
53119

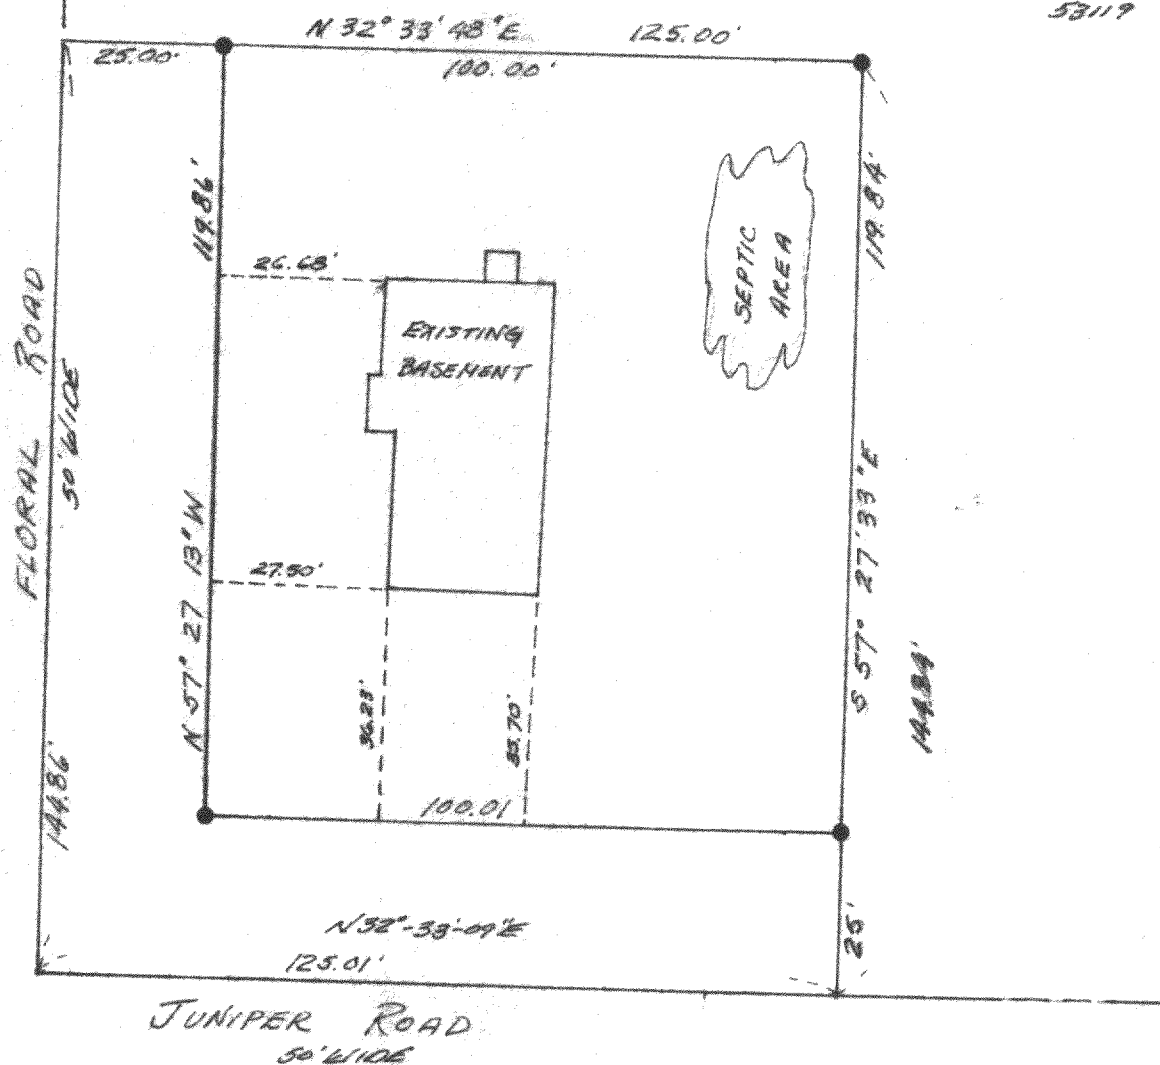

Nov. 29, 1978

Thomas P.A. Jensen S-1084
JENSEN SURVEYING & MAPPING
ELKHORN, WISCONSIN