


KOLB LAND CONSULTING, INC.
LAND SURVEYING • SUBDIVIDING • LAND PLANNING

LAKE GENEVA, WISCONSIN 53147

WHITEWATER, WISCONSIN 53190

NORTHEAST CORNER
BLOCK 62

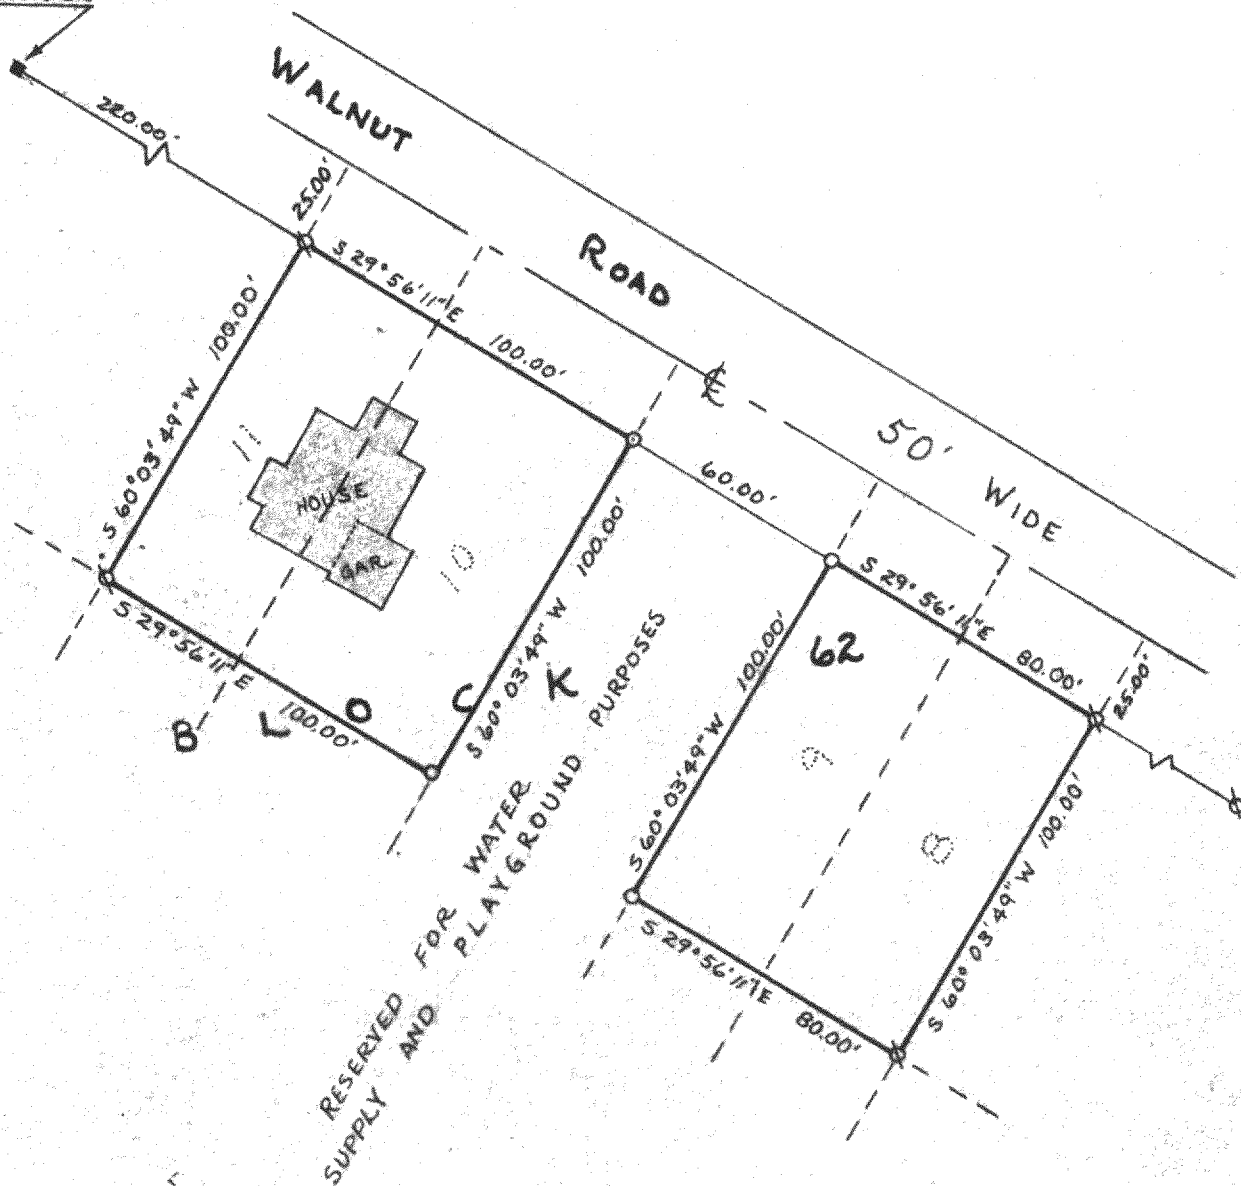

PLAT OF SURVEY OF

Lots 8, 9, 10 & 11, Block 62,
Interlaken 4th Map T3N, R16E,
Walworth County, Wisconsin.

Note: Bearings assumed as plotted.


Owned by: Harry Pederson
1211 N. Waller Ave.
Chicago, Ill. 60651

N

LEGEND

- - IRON PIPE SET
- - IRON PIPE FOUND
- - CONCRETE MONUMENT

SCALE: 1" = 50'

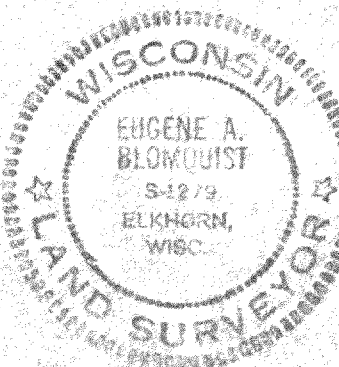

I, Eugene A. Blomquist, do hereby certify
that I have surveyed the property hereon
described according to the official records,
and that plat hereon is a correct
representation of the lot lines.

[Signature]
EUGENE A. BLOMQUIST
WISCONSIN REGISTERED LAND SURVEYOR, S-1279

DATE

Aug. 13, 1979

61-563

316-285K