


FARRIS, HANSEN & COOPER, INC.

ENGINEERING, SURVEYING AND LAND PLANNING
715 W. WALWORTH ST. - P.O. BOX 487 - ELKHORN, WI 53121
OFFICE: 414/723-2098

BLOCK 5

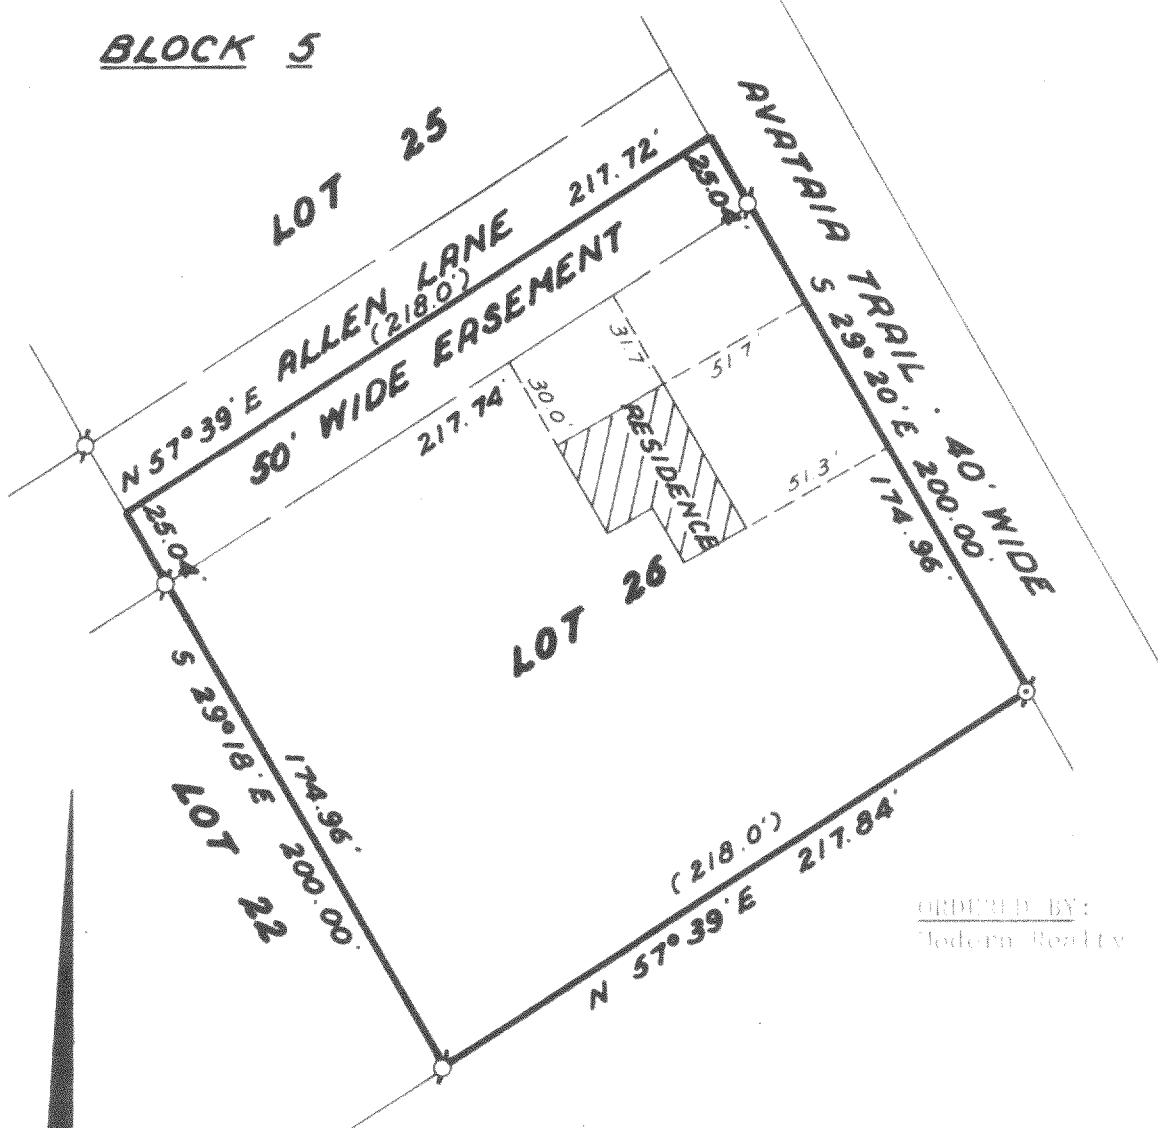

ORDERED BY:
Modern Realty

PLAT OF SURVEY OF

Lot 26, Block 5, Lake Mendota Highlands First Addition,
Town 3 North, Range 16 East, Walworth County, Wisconsin,
subject to a roadway easement over the Northwest 25
feet thereof.

NOTE: The Southwestly right-of-way line of Avatara Trail
is assumed S 29° 20' E as shown on existing survey
records.

0 10 20 30 60




SCALE IN FEET

1"=60'

LOCATED

- Ø—1" Dia. Iron Pipe Found
- Ø—1-1/2" Dia. Iron Pipe Found
- ()—Record Dimension

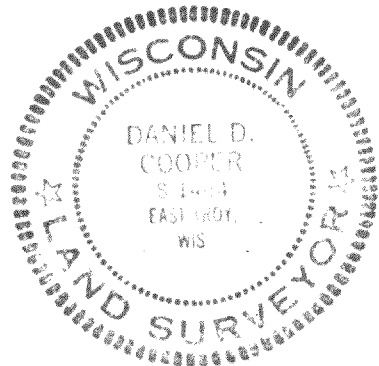

I hereby certify that I have surveyed
the property described herein and that
this Plat of Survey is a true and accu-
rate representation of the lot lines
and the buildings thereon to the best
of my knowledge and belief.

Daniel D. Cooper, REC. No. 1464
Date Feb. 1979

DRAWING NUMBER 1464

GWHA-97

316-286