



FARRIS, HANSEN & COOPER, INC.

ENGINEERING, SURVEYING AND LAND PLANNING
715 W. WALWORTH ST. - P.O. BOX 487 - ELKHORN, WI 53121

MORTGAGE INSPECTION SURVEY

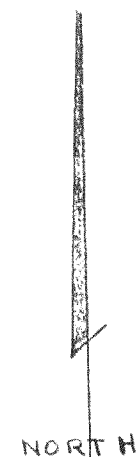

Scale 1" = 50'
■ = Found Conc.
Mon.
○ = Found Iron
Pipe

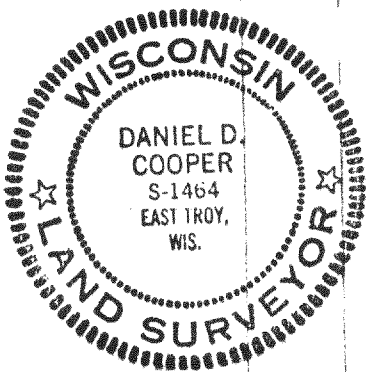

ASPEN ROAD

1005.2'

25.0'
25.0'

25.0'

180.0'

25.0'

PARK ROAD

200.0'

420.0'

420.0'

BLOCK 16

RESIDENCE

SHED

BIRCH ROAD

SUB 16

INTERLAKEN

Mortgage Inspection of North 1/2 of
Lot 37, all of Lots 38 & 39, Lots 14,
15, 16, 17 and the North 1/2 of Lot
18 in Block 16 of Interlaken Subdivision
Town of Sugar Creek, Walworth County, Wis.

BUYER: Rodney J. & Marlys F. Millette
SELLER: Gary L. & Nellie Sutherland
WORK ORDERED BY: Dennis F. DeBartelo
for Waukesha Savings and Loan

NOTE: THIS IS NOT A "PROPERTY SURVEY" AS DEFINED IN SECTION AE-5.01
OF THE WISCONSIN ADMINISTRATIVE CODE.

I HEREBY CERTIFY that this map is a true representation of the Lot Lines and
Buildings located thereon to the best of my knowledge & belief.

Dated this 9TH day of Jan., 1979

Daniel D. Cooper
Daniel D. Cooper
DRAWING NO. 1448

G1-217

316 - 288