


OF
LOTS 15 AND 16 AND THE NORTH 40 FEET OF
LOT 12 OF BLOCK 6 OF INTERLAKEN SUBDIVISION
LOCATED IN SECTION 11, T3N, R16E, TOWN OF SUGAR CREEK,
WALWORTH COUNTY, WISCONSIN

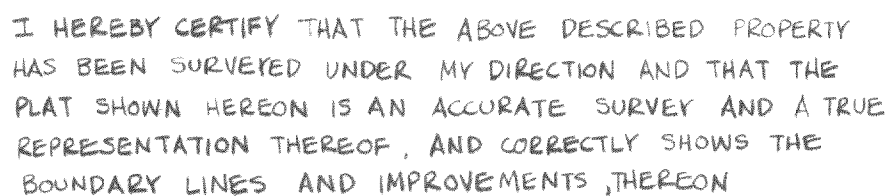

LEGEND

- ~ IRON PIPE FOUND
- ~ IRON ROD 3/4" DIA, 24" LONG SET
- ~ CONC. MONUMENT FOUND
- () ~ RECORDED AS

A circular seal for the Wisconsin Land Surveyor. The outer ring contains the text "WISCONSIN" at the top and "LAND SURVEYOR" at the bottom, separated by two stars. The center of the seal contains the text "THOMAS P. A. JENSEN", "S-1084", and "ELKHORN, WIS." in three lines.

DATE 6-25-81

316-290 J
1981.044