


FARRIS, HANSEN & COOPER, INC.

ENGINEERING, SURVEYING AND LAND PLANNING
715 W. WALWORTH ST. - P.O. BOX 487 - ELKHORN, WI 53121

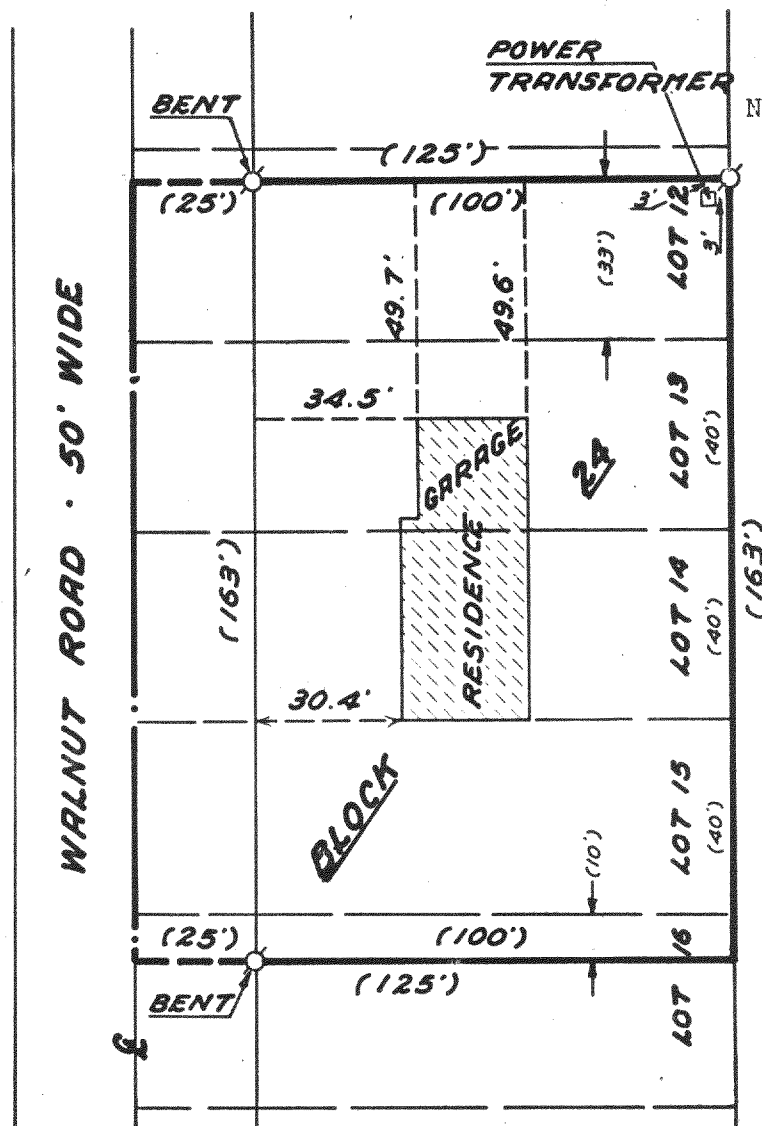

MORTGAGE INSPECTION SURVEY

NOTE: THIS IS NOT A "PROPERTY SURVEY" AS DEFINED IN SECTION AE-5.01 OF THE WISCONSIN ADMINISTRATIVE CODE.

ALL OF LOTS 13, 14 AND 15, THE SOUTHERLY 33.00 FEET OF LOT 12 AND THE NORTHERLY 10.00 FEET OF LOT 16, ALL IN BLOCK 24 IN THE THIRD MAP OF INTERLAKEN SUBDIVISION, TOWN OF SUGAR CREEK, WALWORTH COUNTY, WISCONSIN.

ORDERED BY:

SANDRA J. BUTLER
WAUKESHA SAVINGS
AND LOAN ASSOCIATION

BUYERS:

ROBERT A. AND MAUREEN FROST


SELLERS:

PAUL E. AND KAREN P. PETERSON

LEGEND

○—IRON PIPE FOUND

()—RECORD DIMENSION

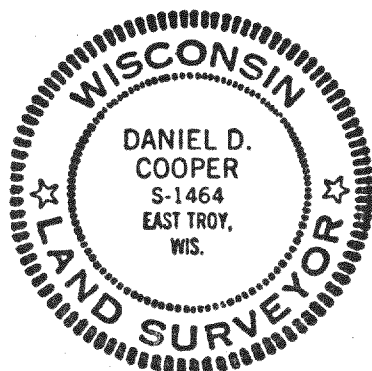

I HEREBY CERTIFY that this map is a true representation of the location of the structure with respect to the survey monuments indicated as found to the best of my knowledge and belief.

Daniel D. Cooper
Daniel D. Cooper, RLS No. 1464

Dated this 30 day of July, 1979.

0 10 20 40
SCALE IN FEET
1"=40'

PROJ. NO. 1568