




LEGEND

- = ORIGINAL TYPE 6" SQUARE CONCRETE MONUMENT FOUND
- = IRON PIPE STAKE SET 1" O.D. x 24" WITH PLASTIC CAP "FHC."
- △ = IRON NAIL SET

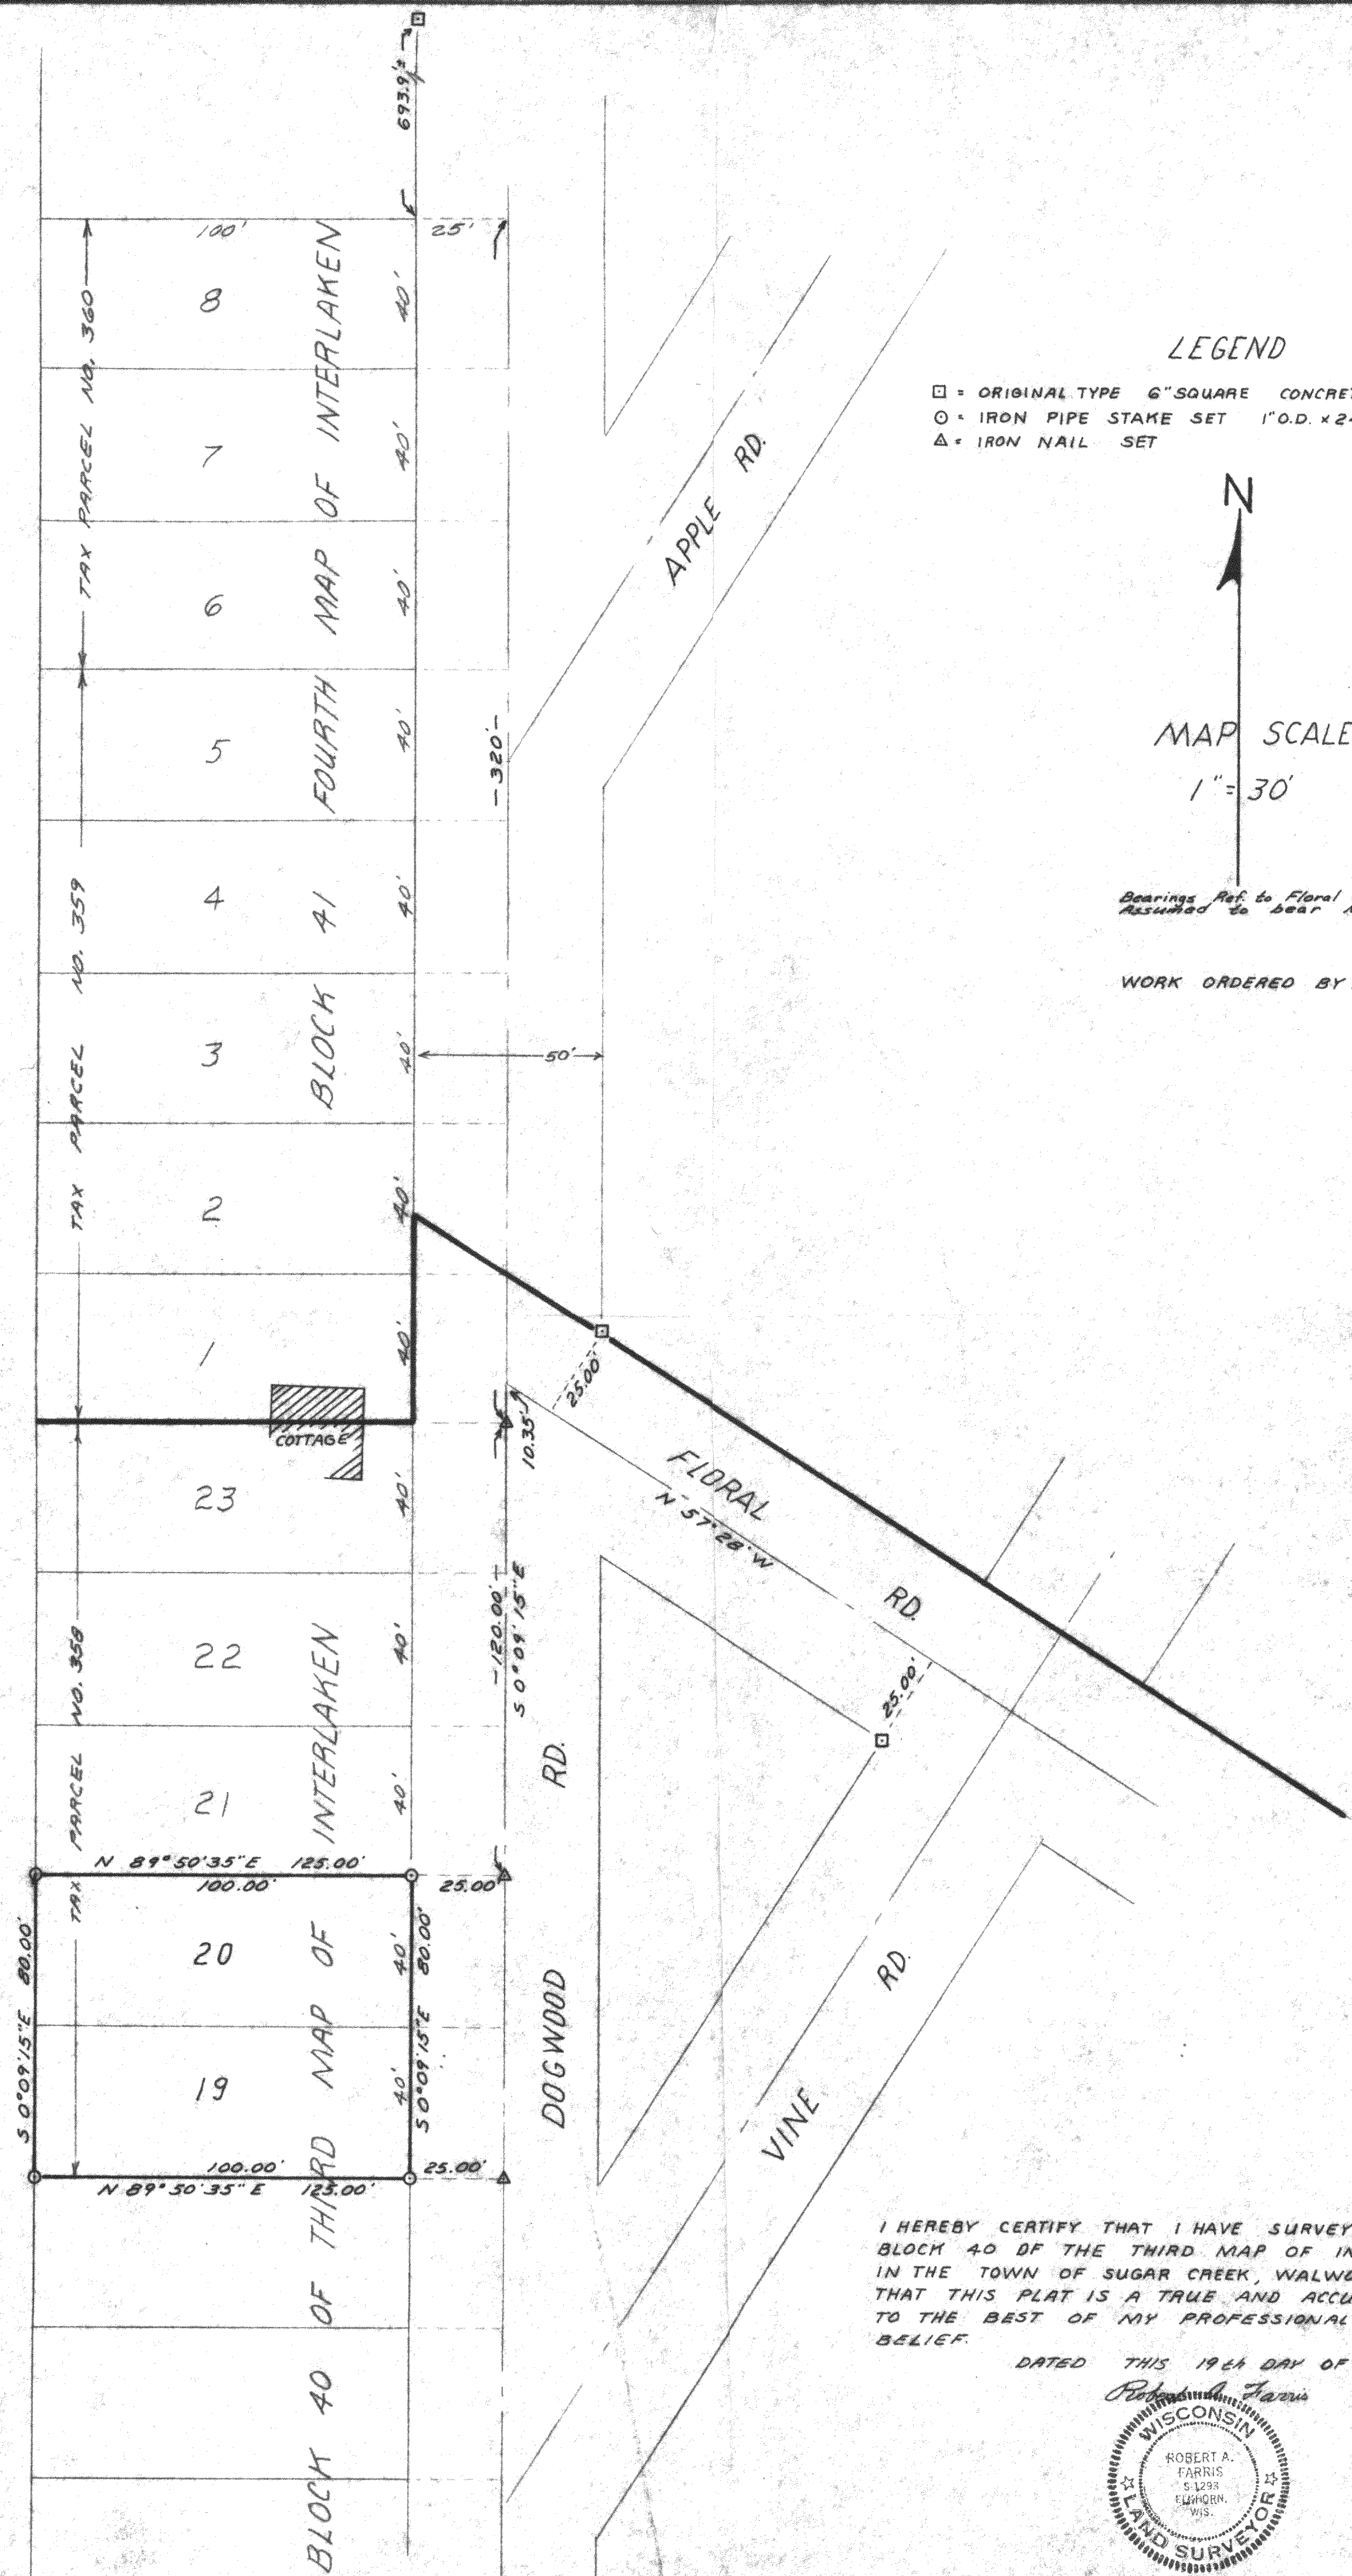

MAP SCALE
1" = 30'


Bearings Ref to Floral Road as found to be monumented
Assumed to bear N 57° 28' W as recorded

WORK ORDERED BY: FRANK SIMEK, OWNER

I HEREBY CERTIFY THAT I HAVE SURVEYED LOTS 19 & 20 OF
BLOCK 40 OF THE THIRD MAP OF INTERLAKE LOCATED
IN THE TOWN OF SUGAR CREEK, WALWORTH COUNTY, WIS., AND
THAT THIS PLAT IS A TRUE AND ACCURATE REPRESENTATION
TO THE BEST OF MY PROFESSIONAL KNOWLEDGE AND
BELIEF.

DATED THIS 19th DAY OF AUGUST, 1982

Robert A. Farris

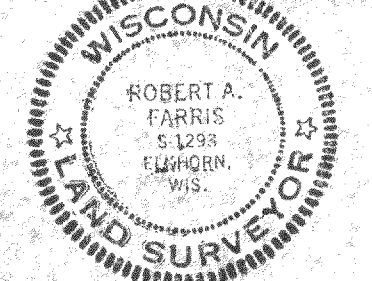

FARRIS, HANSEN & ASSOCIATES, INC.
715 W. Walworth St. P.O. Box 487
Elkhorn, WI 53121

PROJECT NO. 1989