



FARRIS, HANSEN & COOPER, INC.

ENGINEERING, SURVEYING AND LAND PLANNING
715 W. WALWORTH ST. - P.O. BOX 487 - ELKHORN, WI 53121
OFFICE: 414/723-2086

Plat of Survey of Lots 1 through 6, Block 97 of
Lake Wandawega Subdivision, Town of Sugar Creek,
Walworth County Wisconsin.

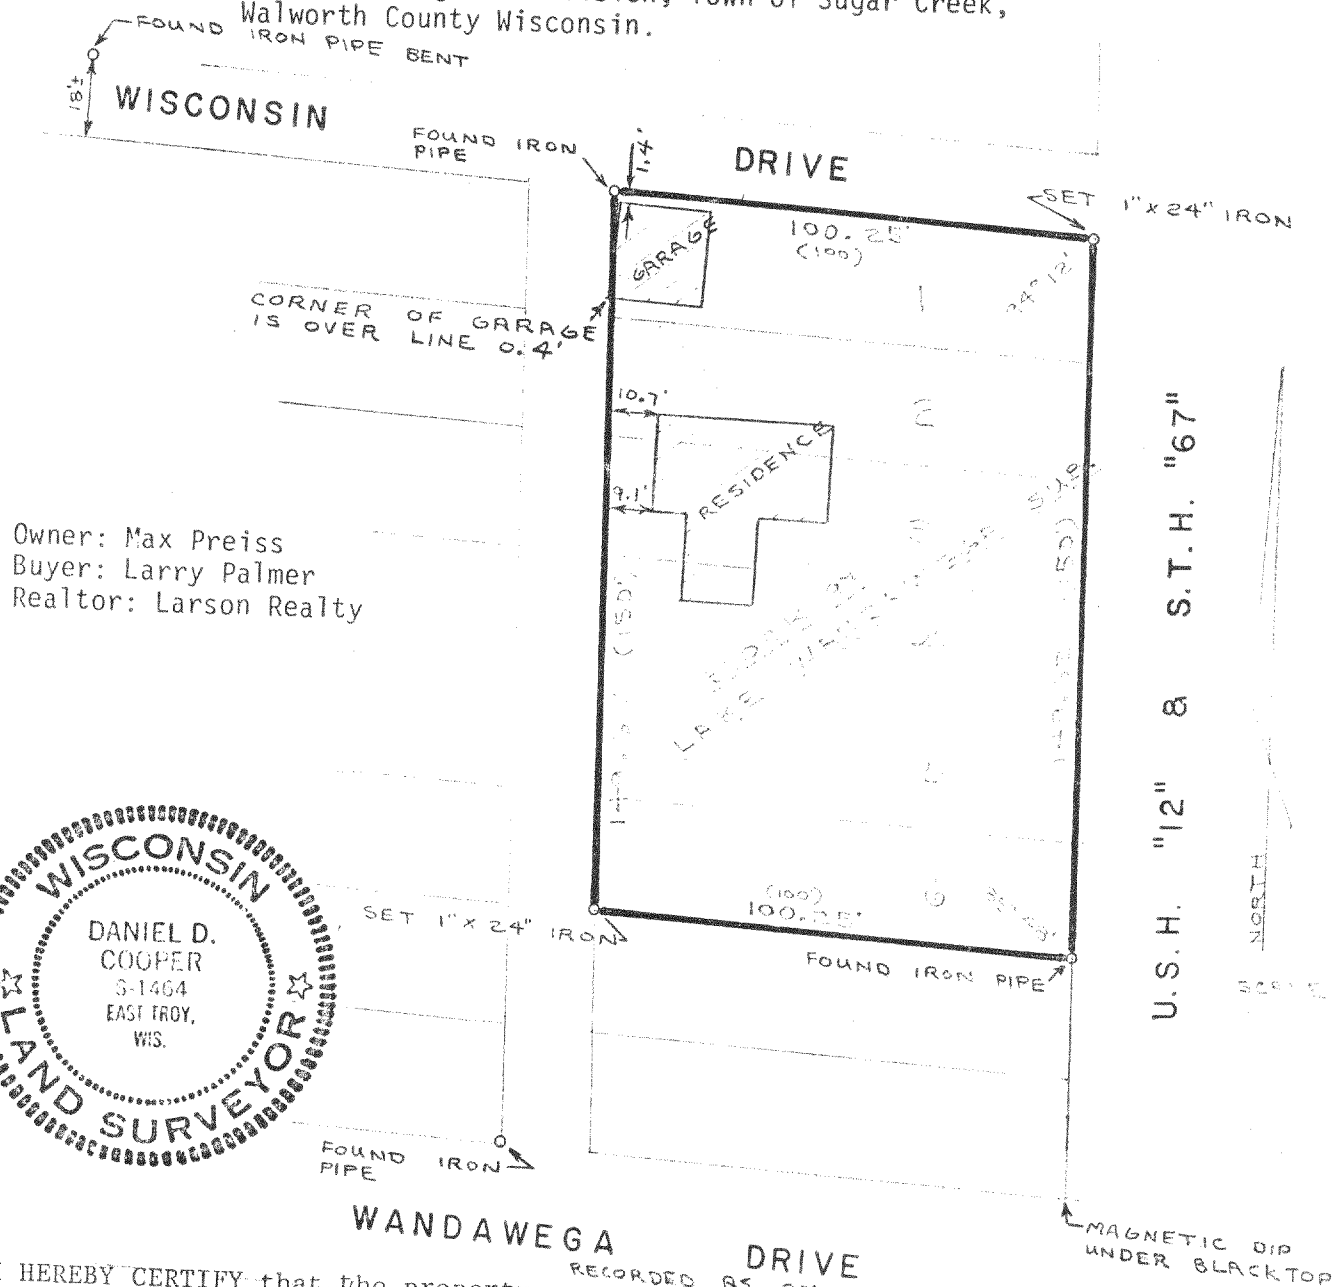

Owner: Max Preiss
Buyer: Larry Palmer
Realtor: Larson Realty

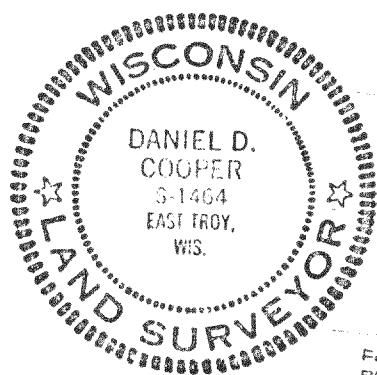

I HEREBY CERTIFY that the property described hereon has been surveyed under my supervision and that this plat of survey is a true and accurate representation of the lot lines to the best of my professional knowledge and belief.

Daniel D. Cooper
Daniel D. Cooper
Wis. Reg. Land Surveyor No. S-1464

April 2 1980
Date

DRAWING NUMBER 1691