


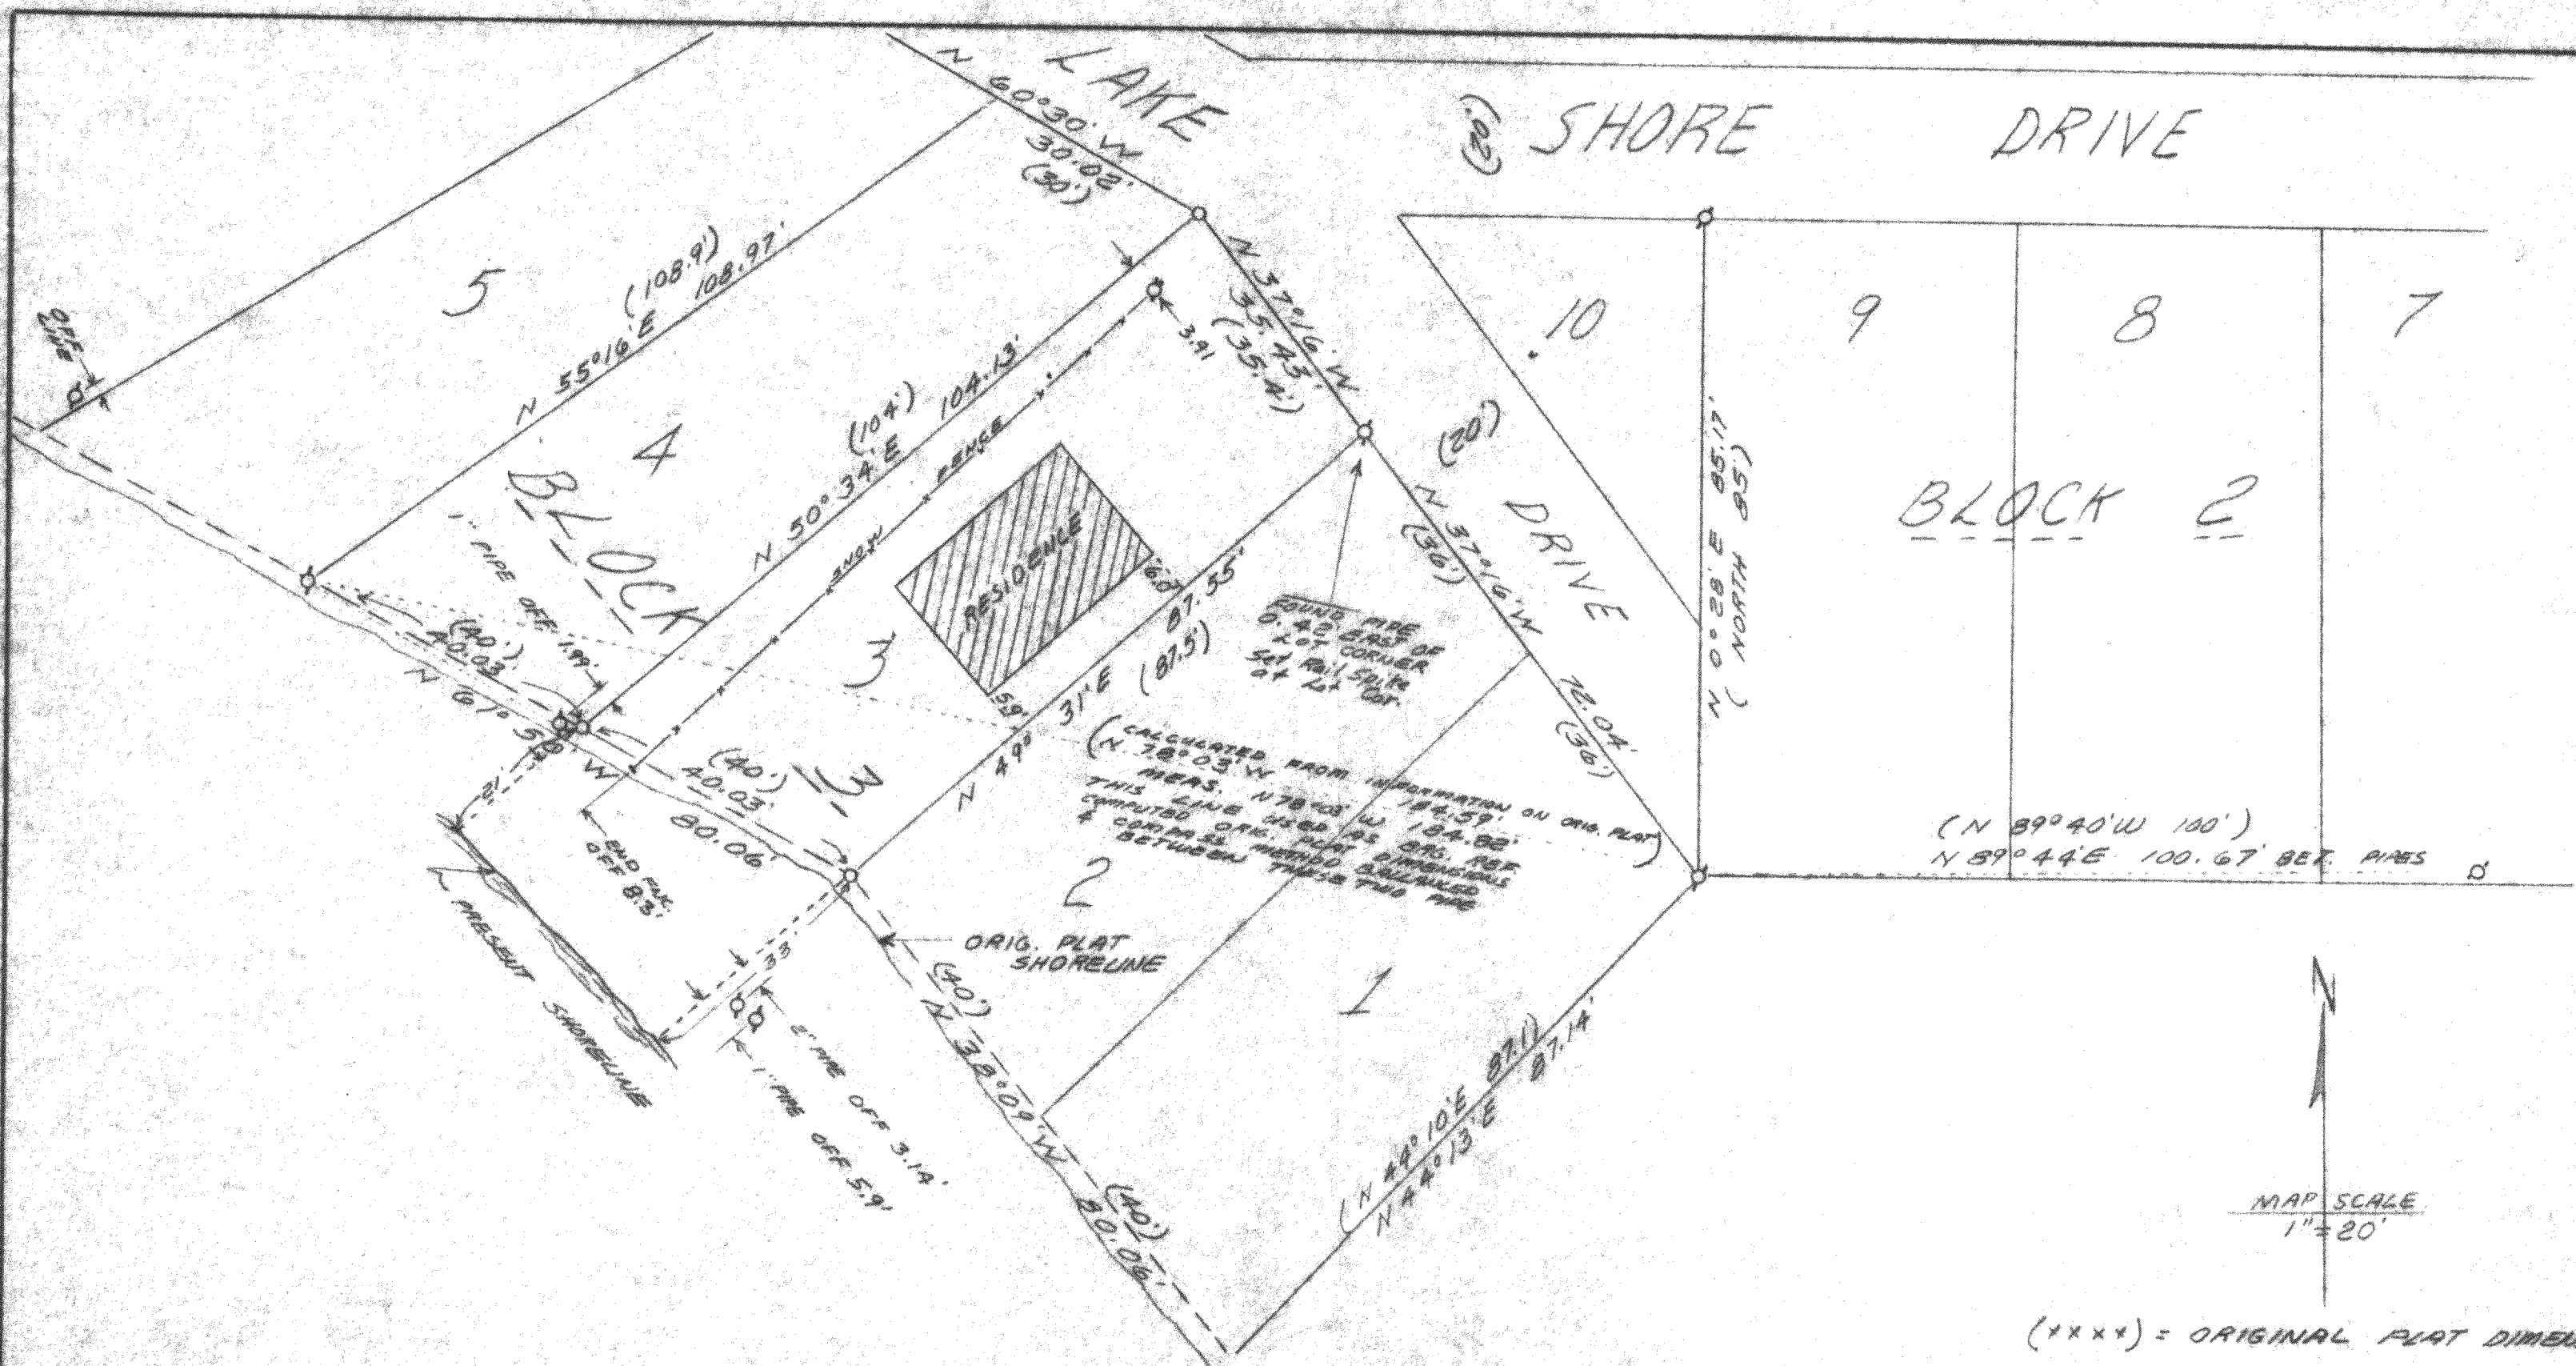


PLAT OF SURVEY OF LOT 3 OF BLOCK 3 OF NORTH LAKE EVERGREEN BEACH SUBDIVISION FOR WILLIAM PETERSON

I hereby certify that the above described lands have been surveyed under my direction and that this Plat of Survey is a true and accurate representation of the lot lines and of the building location to the best of my professional knowledge and belief.

Dated this 15th day of July, 1963

Robert A. Farris
Robert A. Farris RLS

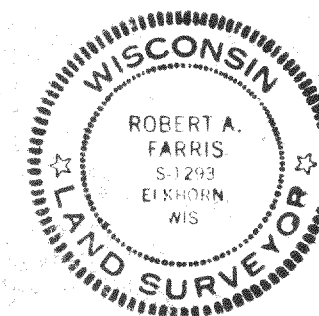

(XXXX) = ORIGINAL PLAT DIMENSION
Ø = IRON PIPE STAKE FOUND
O = IRON PIPE STAKE SET 10A

FARRIS, HANSEN & ASSOCIATES, INC.
715 W. WALNORTH STREET
ELKHORN, WISCONSIN

PROJECT NO. 2132

415-295-F