

PLAT OF SURVEY OF-

Lot 16 of Twin Heights Estates Subdivision, located in Section 23, Town 5 North, Range 12 East, according to the recorded plat thereof, County of Walworth, and State of Wisconsin.

Survey for: Logan & Pettibone Co.

Buyer: Dennis and Jane Munro

BEARINGS:

Bearings hereon refer to the bearings of the recorded plat.


SCHMIDT ROAD

EAST 100.00'


Denotes existing fences.

Denotes 1"Ø iron pipe found.

Denotes 1"Ø iron pipe set.

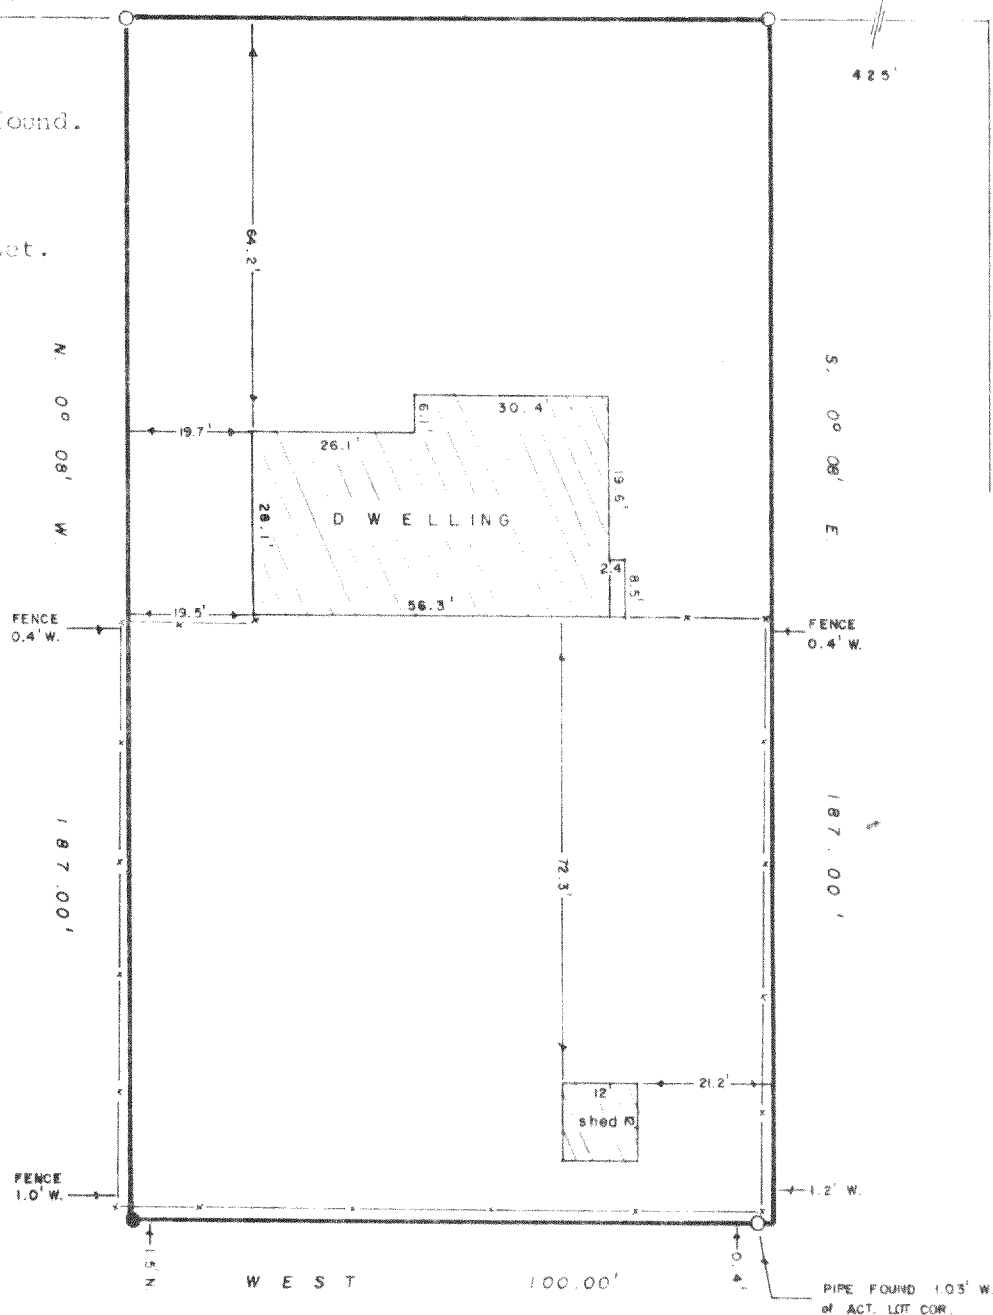

Scale 1" = 30'

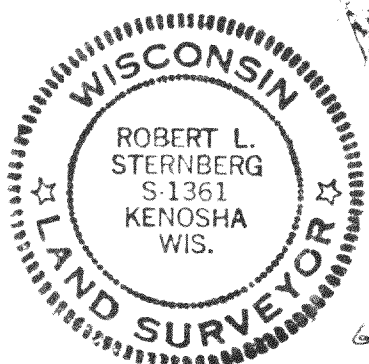

I Certify that I have surveyed the described property and the above map is a true representation thereof and shows the size and location of the property, its exterior boundaries, the location and dimensions of all visible structures thereon, fences, apparent easements and roadways and visible encroachments, if any.

This survey is made for the exclusive use of present owners of property, and also those who purchase, mortgage or guaranty the title thereto within one (1) year from date hereof.

Robert L. Sternberg 6/80
Registered Land Surveyor Date

30142 W.M.A.
Job No.

6THS-10

316-299