


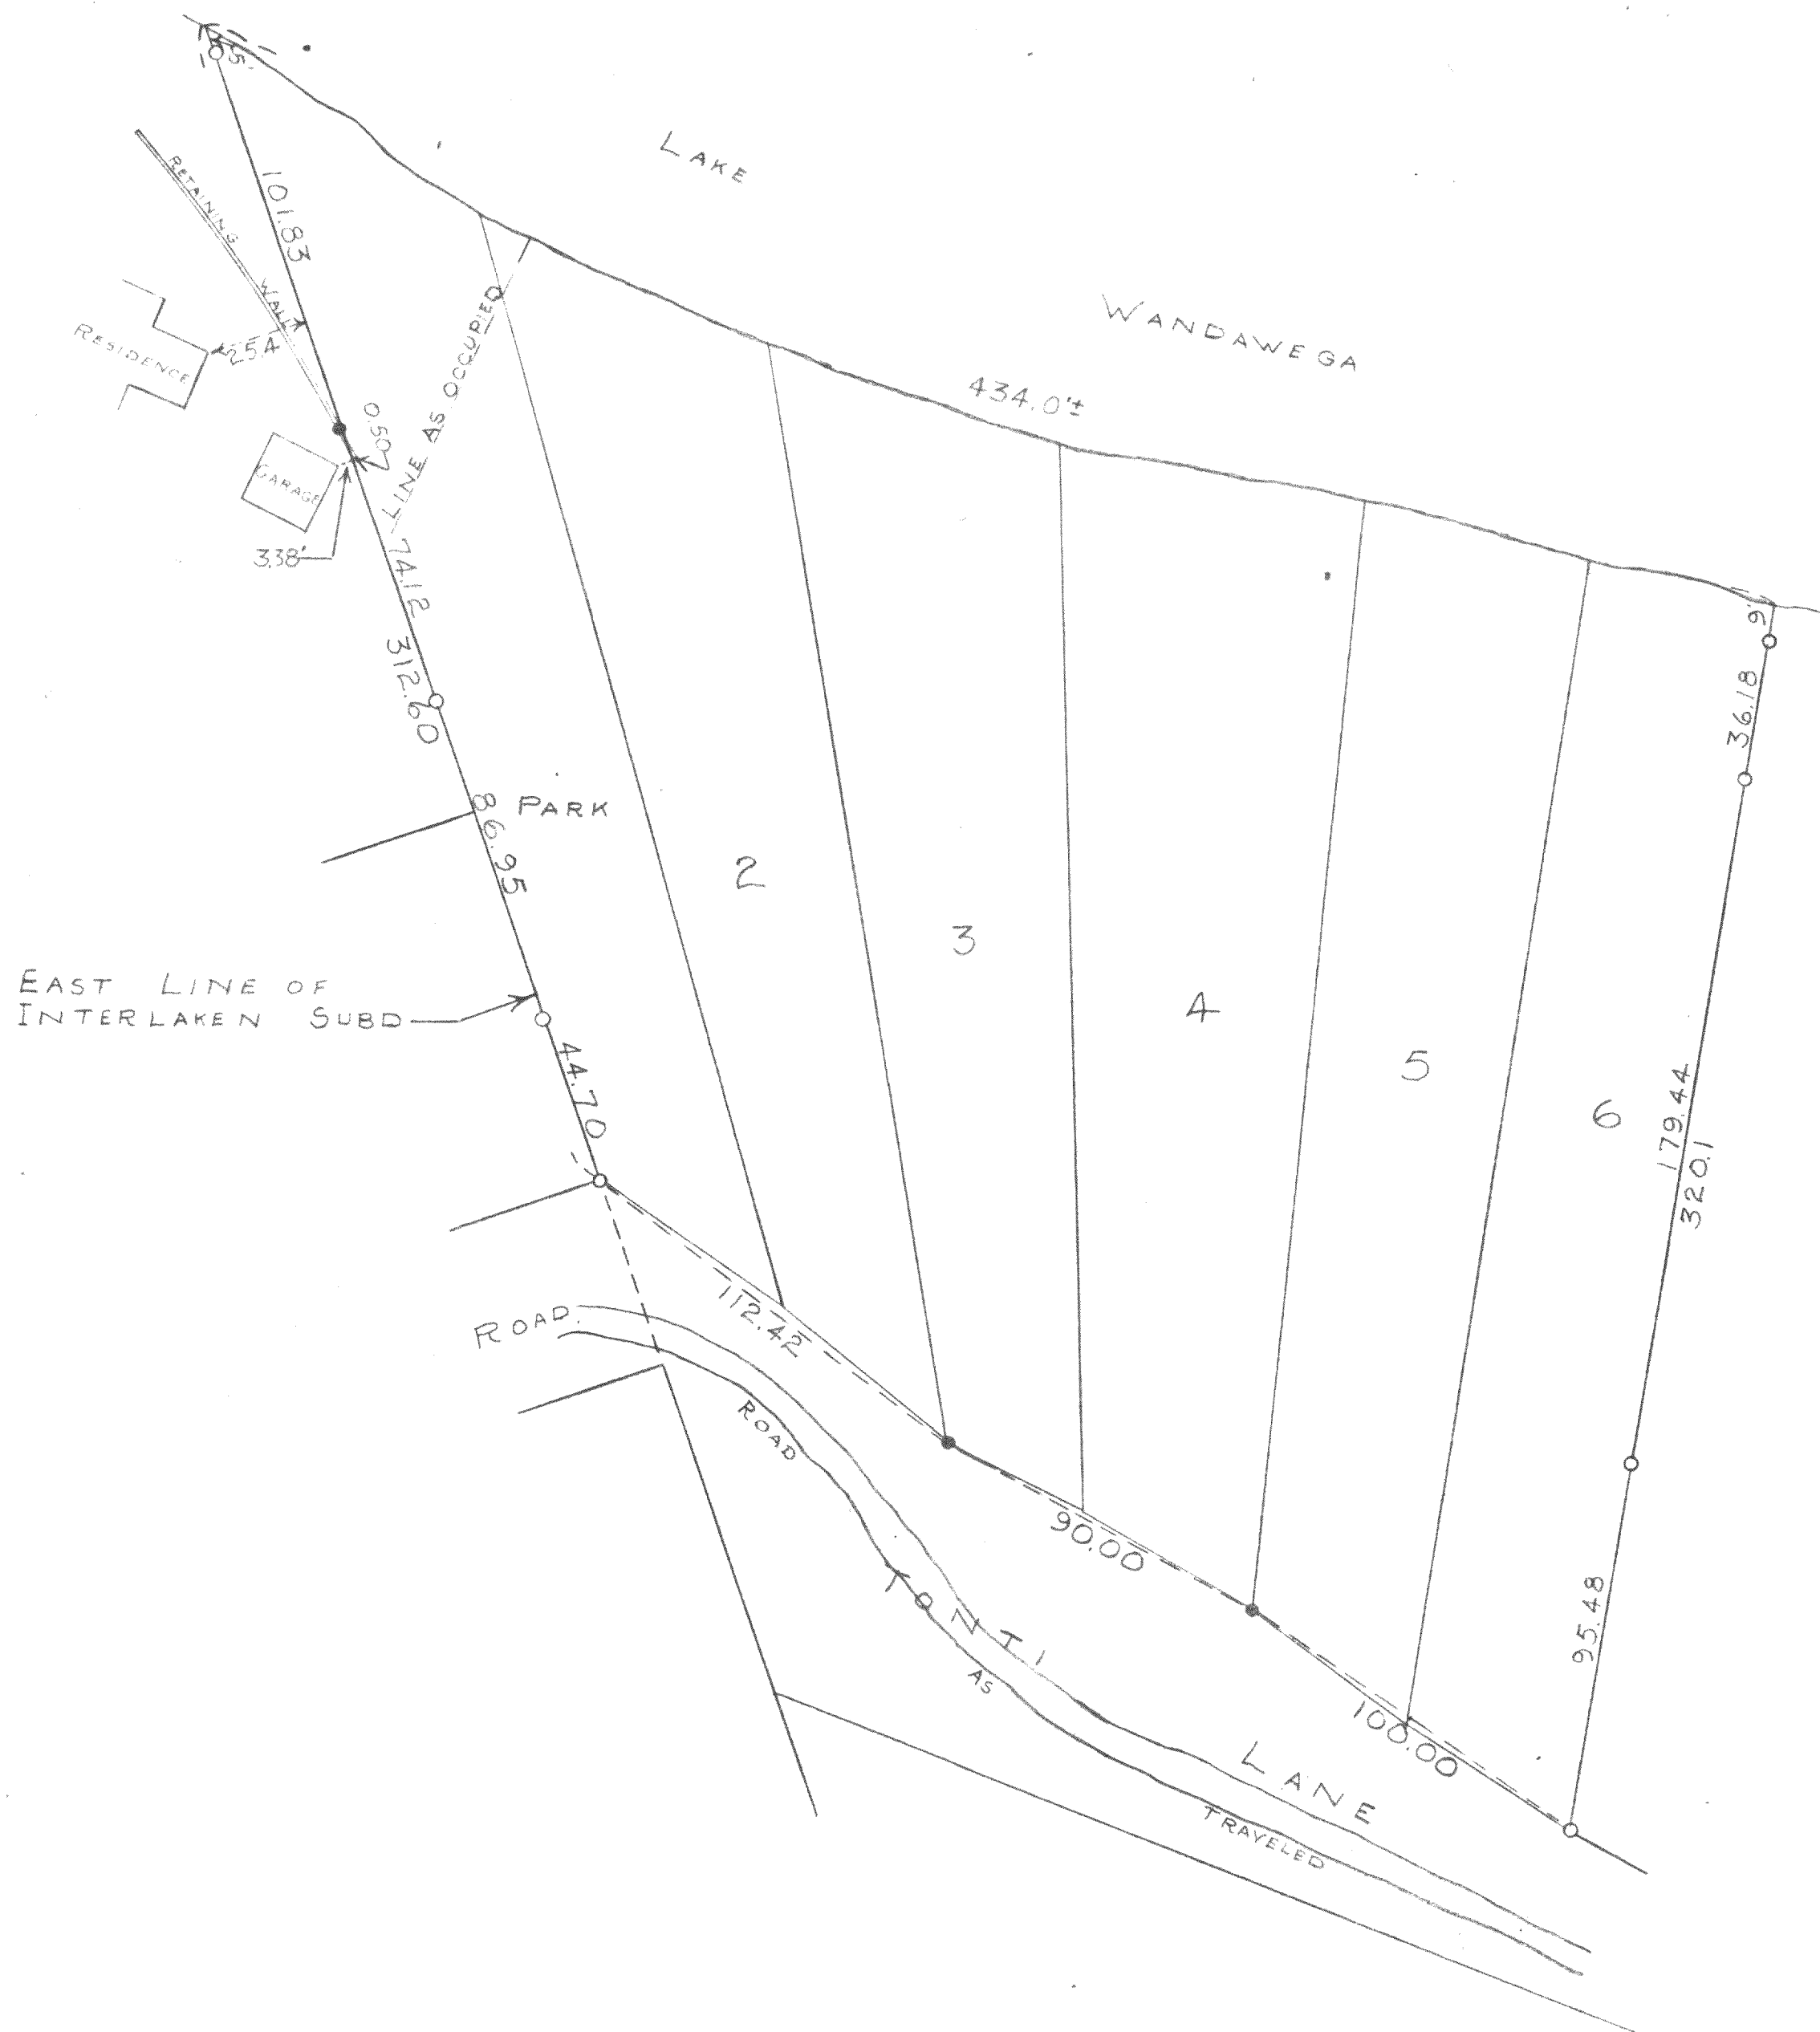

PLAT OF SURVEY OF LAND DESIGNATED AS PARK AND LOTS  
2.-6 INCLUSIVE, BLOCK 1 OF LAKE WANDAWEGA HIGHLANDS  
LOCATED IN SECTION 11, T3NR16E OF WALWORTH COUNTY, WIS.  
AUGUST 1954

*George T. Dunham*  
GEORGE T. DUNHAM, SURVEYOR  
DELAVER, WISCONSIN

G-WH-1  
11-2