


DUNHAM SURVEYING, S.C.
SURVEYING & SUBDIVIDING
DELAVAN, WISCONSIN 53115

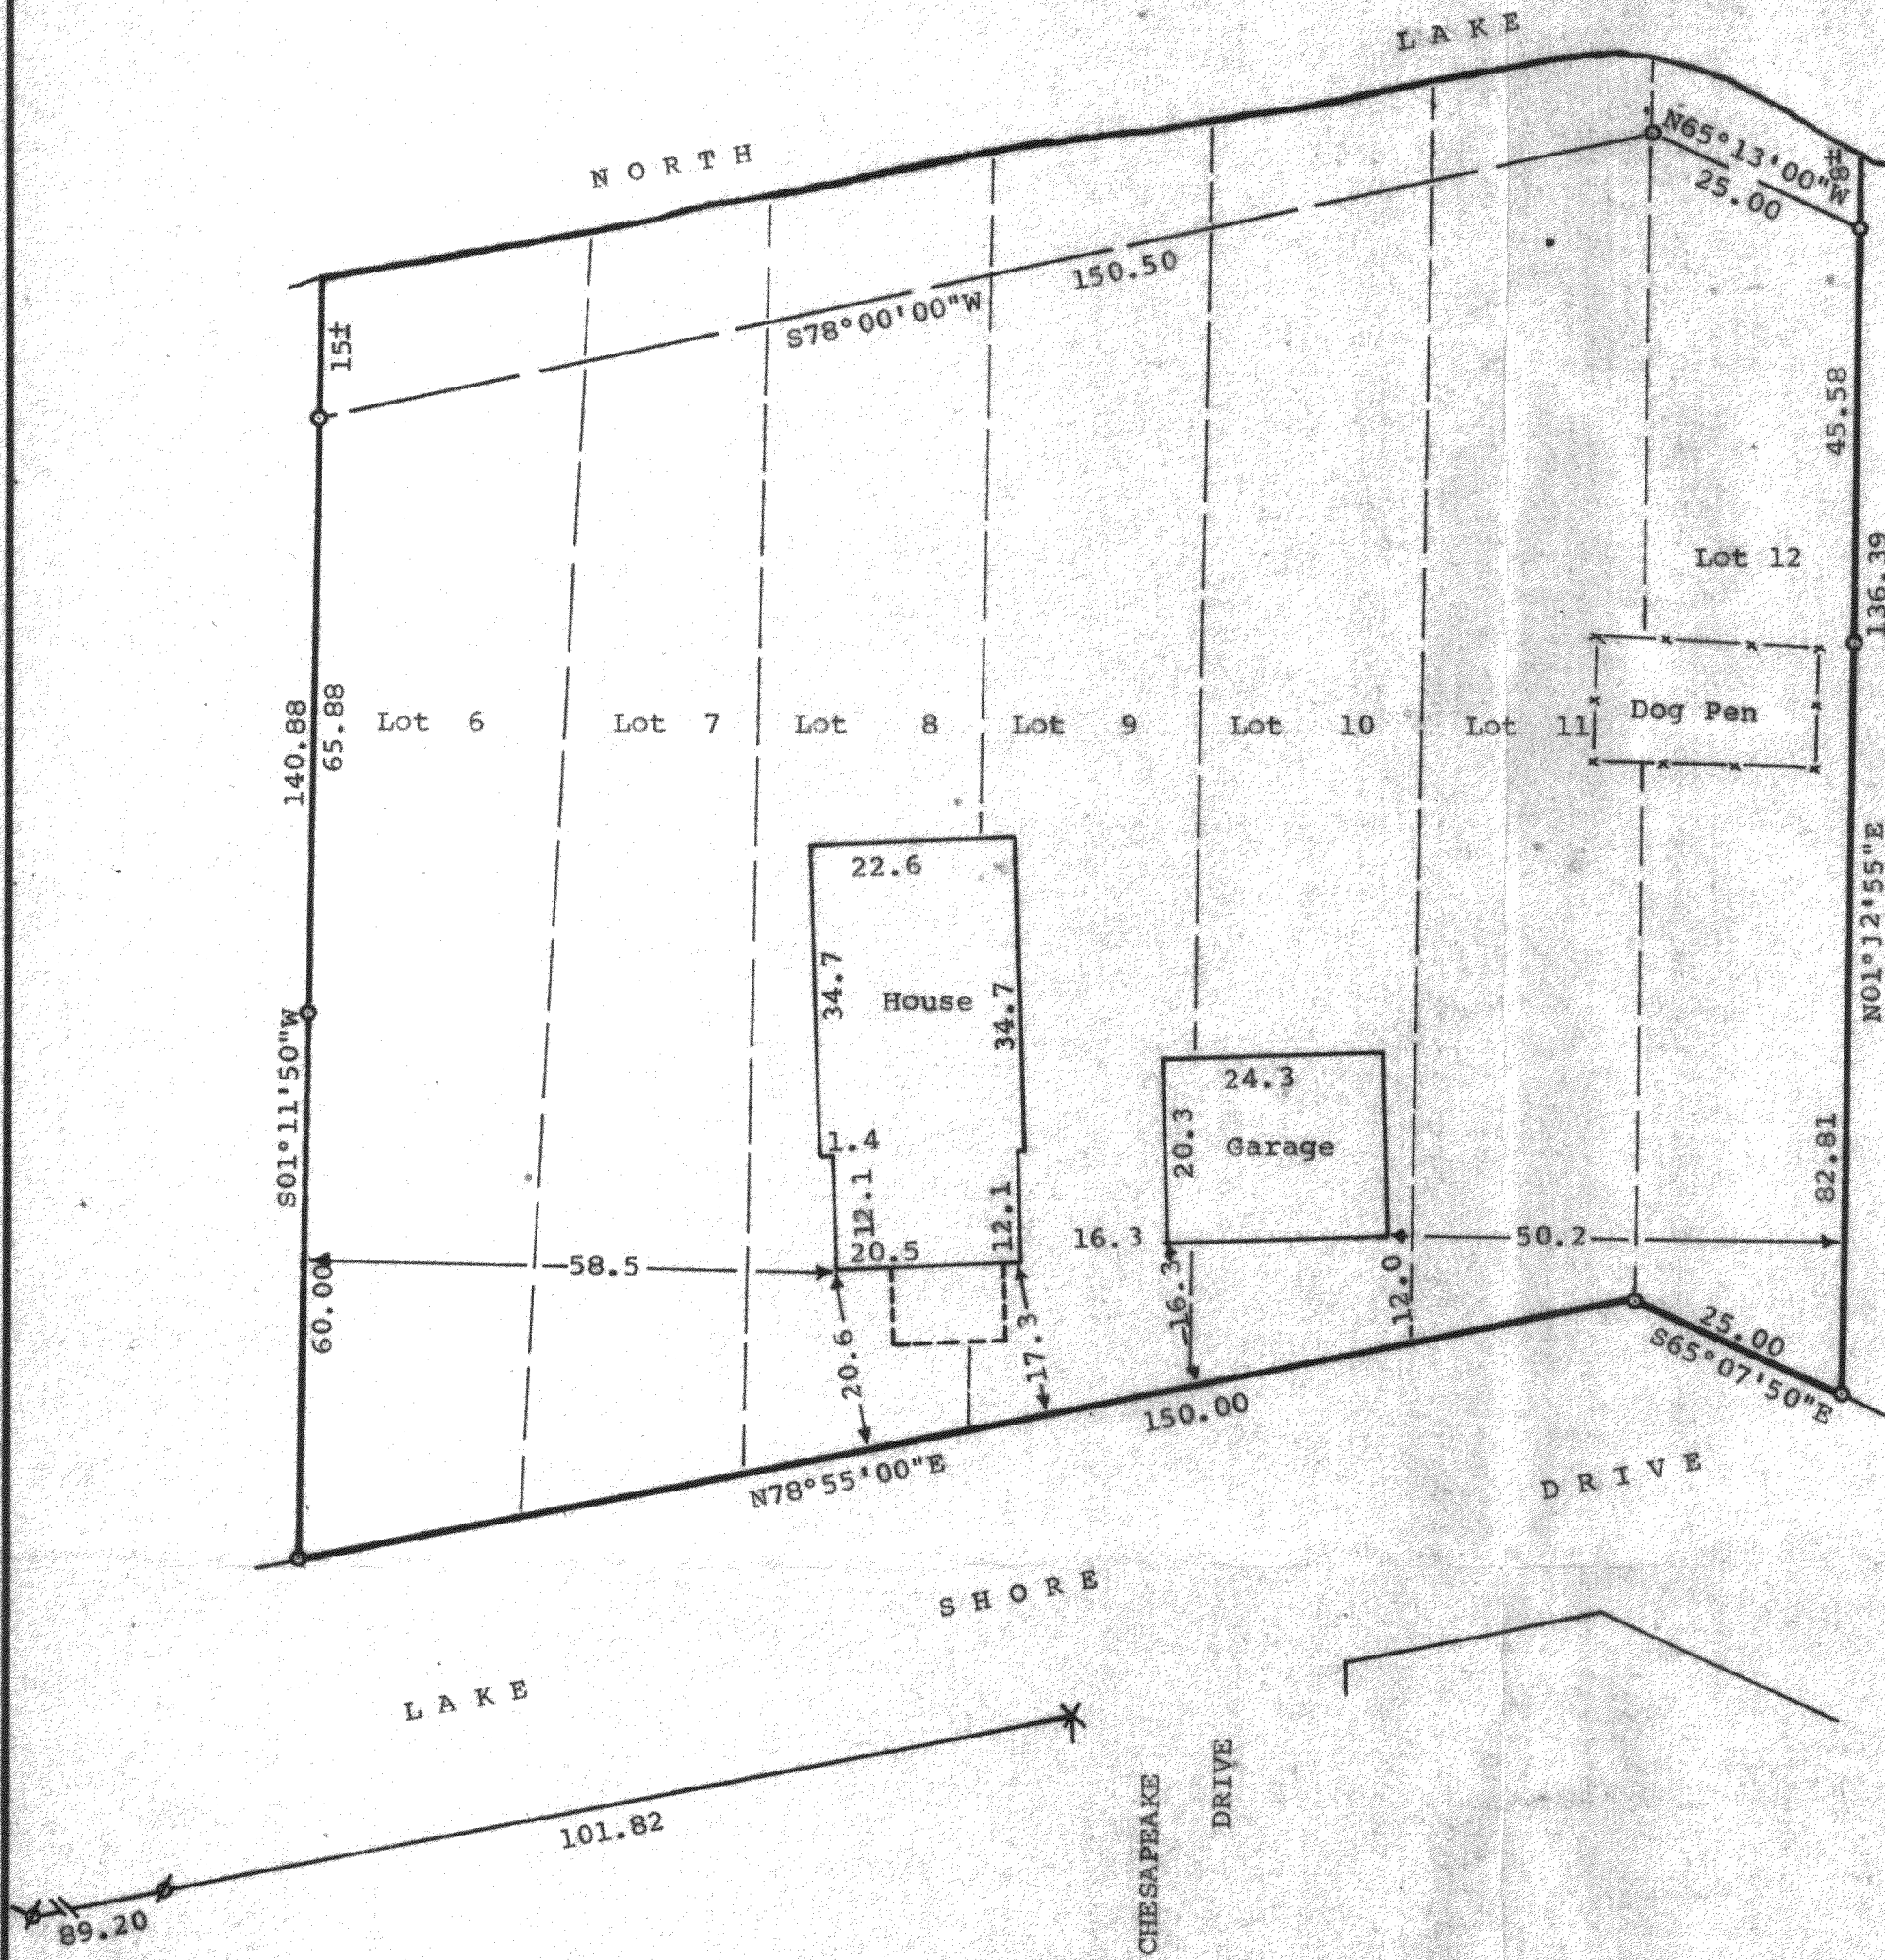

Scale - 1" = 20'
 Ø = Iron Pipe Found - 3/4" Dia.
 X = Spike Found
 ○ = Iron Pipe Set - 1" Dia.

Survey Ordered By:
 Thomas Johnson
 307 E. Washington St.
 Delavan, Wisconsin 53115

Bearings referenced to the Northerly line
 of Lake Shore Drive along Lots 6-11 of
 Block "A". Assumed bearing is N78°55'00"E.


STATE OF WISCONSIN)
 COUNTY OF WALWORTH) SS

I, George T. Dunham, Surveyor, certify that I have surveyed the
 property described as follows,
 Lots 6, 7, 8, 9, 10, 11, and 12 in Block "A" of North Lake Beach Tract
 No 2, a subdivision located in Section 5, T3N, R16E, Walworth County,
 Wisconsin,

and that the above map is a true representation thereof and shows the
 size and location of the property, its exterior boundaries, the location
 of all visible structures and dimensions of all principal buildings
 thereon, boundary fences, apparent easements, roadways and visible
 encroachments, if any.

This survey is made for the use of the present owners of the property, and
 also those who purchase, mortgage, or guarantee the title thereto within
 one (1) year from date hereof.
 May 19, 1982.

George T. Dunham
 George T. Dunham, Surveyor

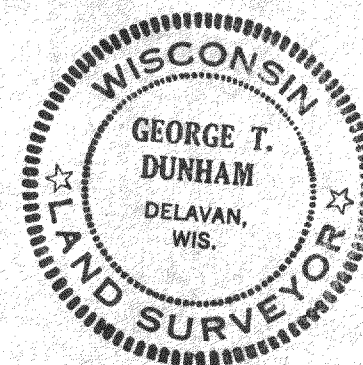

GNLB 2-140, 141, 142

Lots 6, 7, 8, 9, 10, 11 + 12 Blk "A" N. Lake Beach Tract II

316-302-D