

PLAT OF SURVEY

OF
LOTS 1-2-3-4 BLOCK 120, LAKE
WANDAWEGA SUBDIVISION, SECTION 1
T3N, R16E WALWORTH COUNTY
WISCONSIN

NOTE: AN AGREEMENT HAS BEEN MADE
BETWEEN EVELYN A. BOWES, OWNER, AND
DONOHUE TO EXCLUDE WORK AS DESCRIBED
UNDER CHAPTER A.E. 5.01 (5)(b) and (5)(c)

LEGEND

() Platted Dimensions


• Found Iron Pipe

SURVEYED FOR EVELYN A. BOWES

Evelyn A. Bowes (PVR)
EVELYN A. BOWES, OWNER



Scale 1"=40'

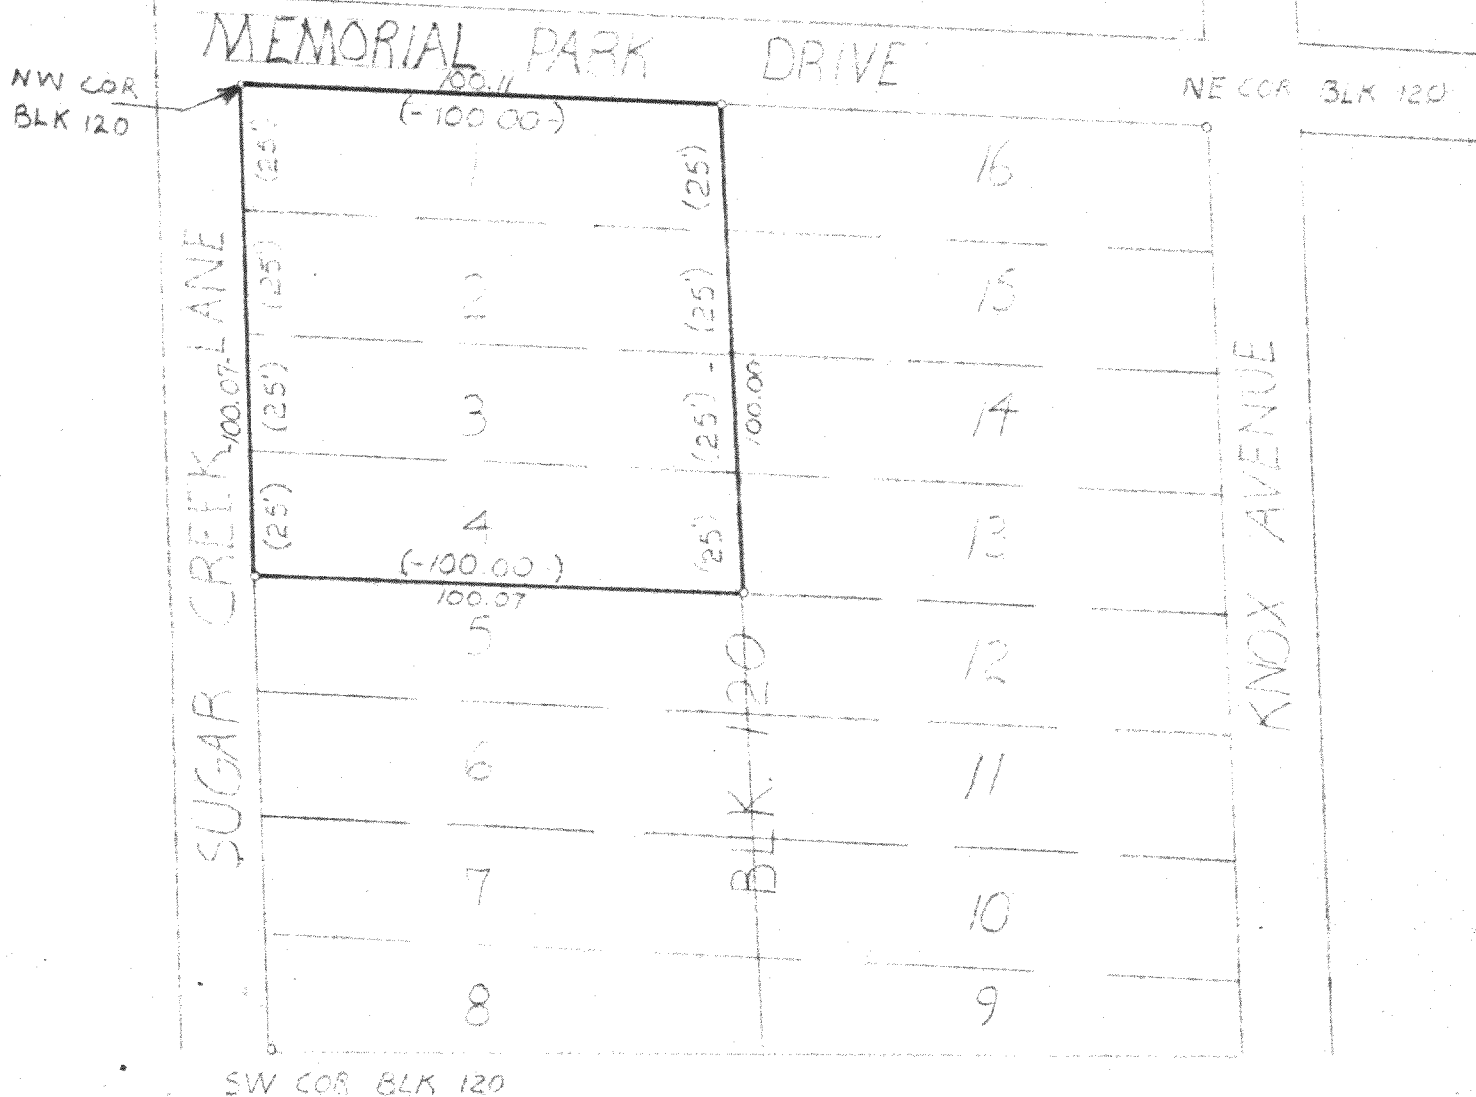


I Joseph S. Klarkowski, Registered Land Surveyor, do hereby certify
that the plat shown hereon is a true and accurate survey and a
true representation thereof and the exterior boundary lines and
and all divisions of said property have been surveyed under
my direction and to the best of my knowledge and belief.

This survey is made for the use of the present owners of the property,
and also those who purchase, mortgage, or guarantee the title thereto
within one year from date hereof.

DATED This 23 day of AUGUST 1982

Joseph S. Klarkowski
Joseph S. Klarkowski, RLS S. 1595

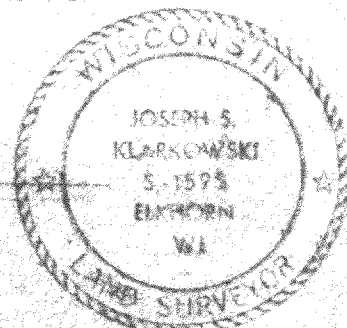

6LW-366
Drawn By Dean B. Hutz

Donohue
Engineers & Architects

316-309

PLAT OF SURVEY

OF
LOTS 1-2-3-4 BLOCK 120, LAKE
WANDAWEGA SUBDIVISION, SECTION 1
T3N, R16E WALWORTH COUNTY
WISCONSIN

NOTE: AN AGREEMENT HAS BEEN MADE
BETWEEN EVELYN A. BOWES, OWNER, AND
DONOHUE TO EXCLUDE WORK AS DESCRIBED
UNDER CHAPTER A.E. 5.01 (5)(b) and (5)(c)

LEGEND

() Platted Dimensions


• Found Iron Spike

SURVEYED FOR EVELYN A. BOWES

Evelyn A. Bowes (PVR)
EVELYN A. BOWES, OWNER



Scale 1"=40'

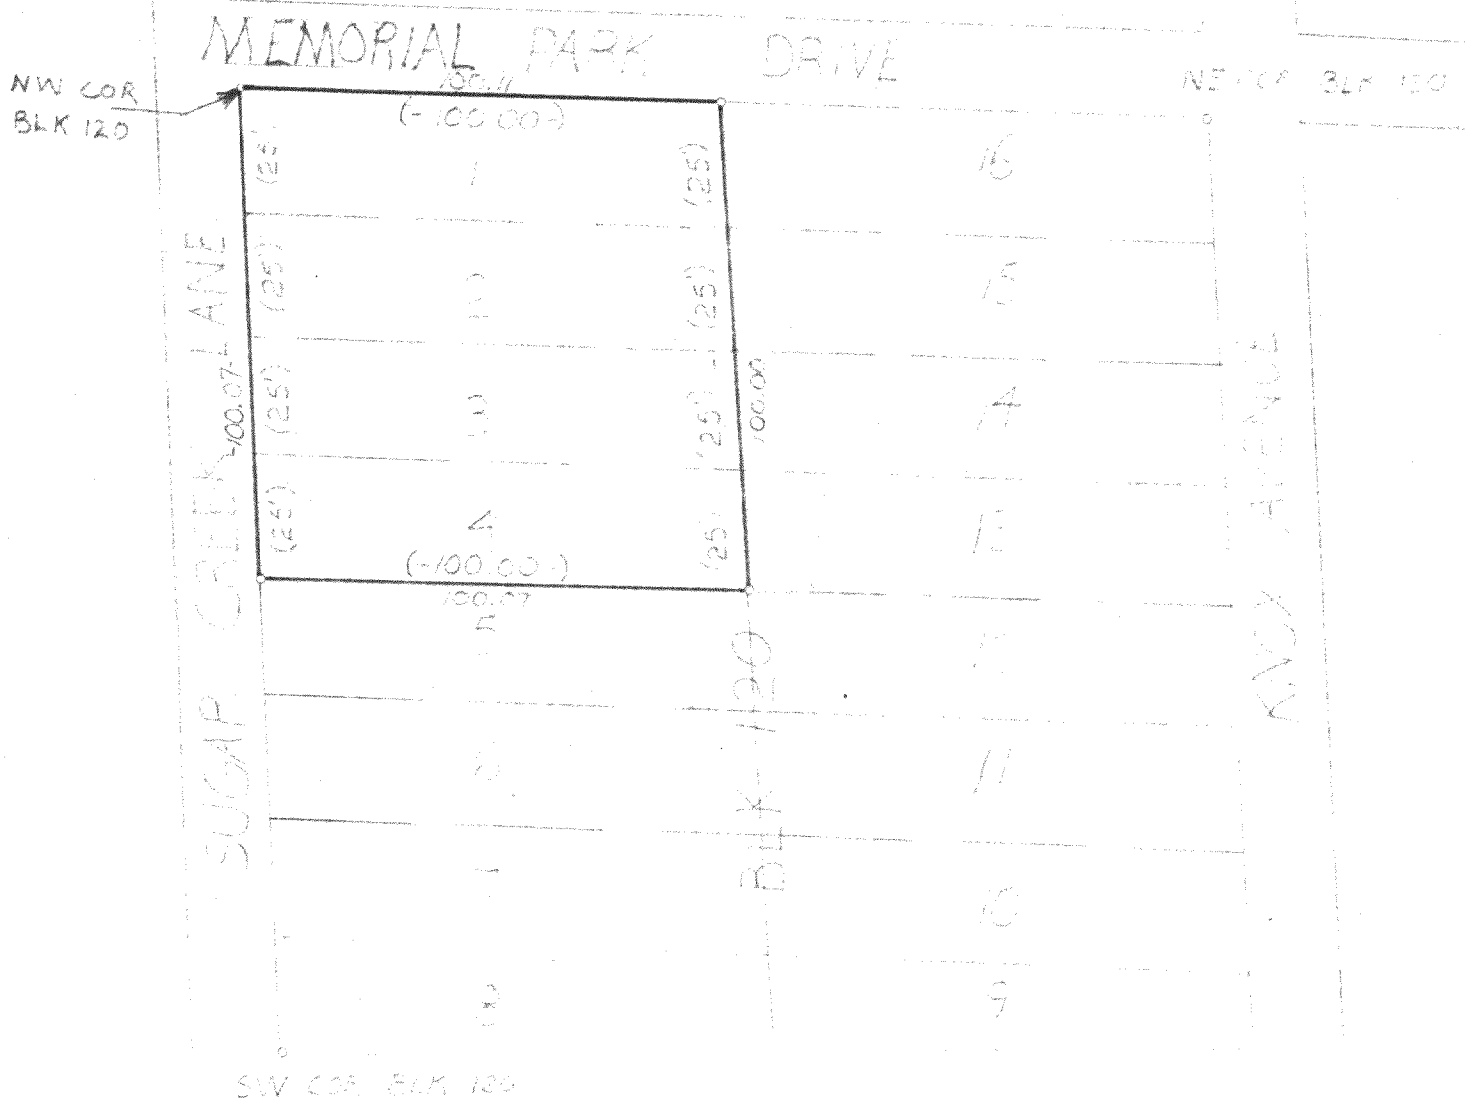


I, Joseph S. Klarkowski, Registered Land Surveyor, do hereby certify that the plat shown hereon is a true and accurate survey and a true representation thereof and the plat and boundary lines and all divisions of said property have been surveyed under my direction and to the best of my knowledge and belief.

This survey is made for the use of the present owners of the property and also those who purchase, mortgage, or guarantee the title thereto within one year from date hereof.

DATED This 23 day of AUGUST, 1982

Joseph S. Klarkowski
Joseph S. Klarkowski, RLS S-1595

Donohue
Engineers & Architects

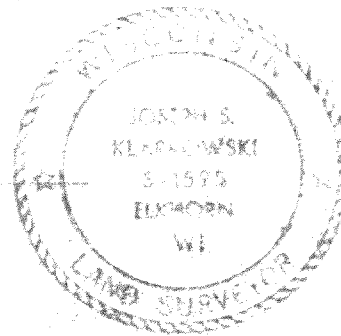

Drawn By Dean R. Hintz