


PLAT OF SURVEY OF
Lots 41-48, Block 57 Lake Wandawega,
Town of Sugar Creek, Walworth County,
Wisconsin

LEDGEND

- Ø - Iron pipe found
O - Iron pipe set

NOTE: The west line of Block 57 was assumed to bear N 0° 31' 01" W as shown in County Surveyors Misc. file 316-148.

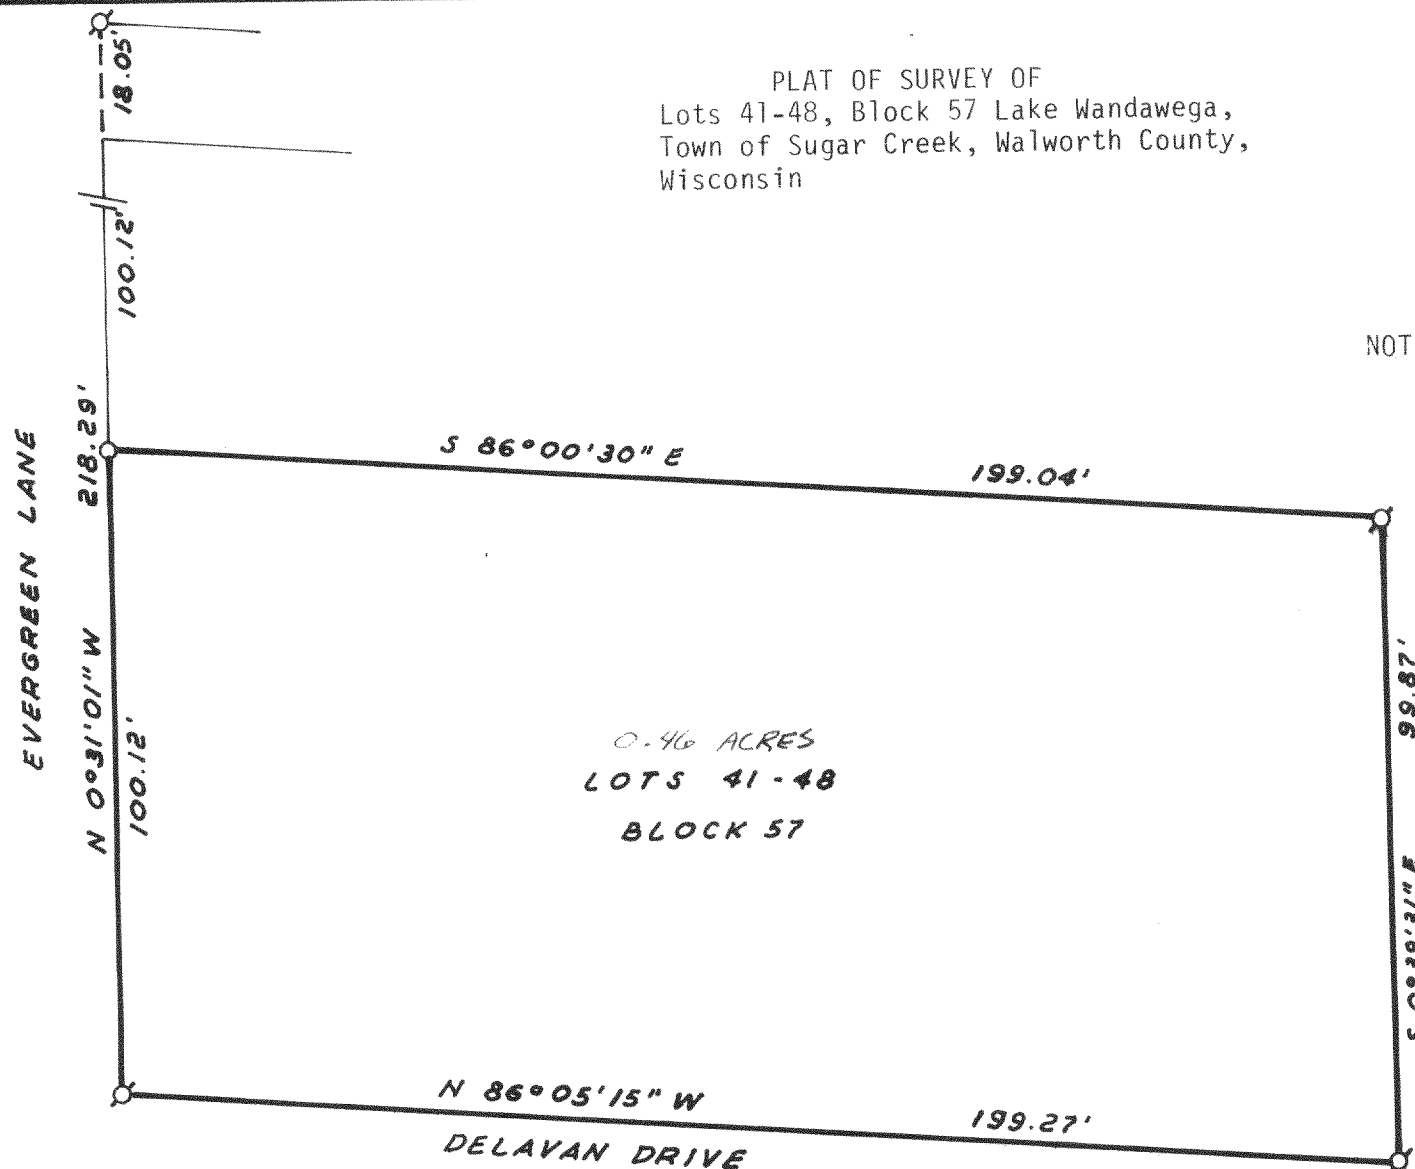

SCALE 1" = 30'

I hereby certify that I have surveyed the above described property and that this plat is a true and accurate representation thereof.

William R. Ohberg

William R. Ohberg
WI Registered Surveyor, S-1679

Dated This 31ST Day of JAN., 1984


Farris, Hansen & Associates, Inc.

Engineering, Surveying & Land Planning

P.O. BOX 487

715 W. WALWORTH STREET
ELKHORN, WISCONSIN 53121

PROJECT NO. 2197

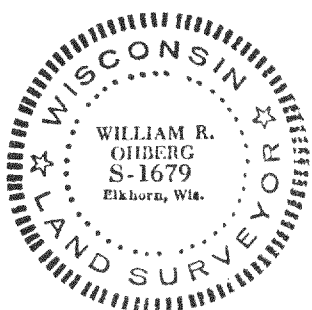

646-100

316-319