
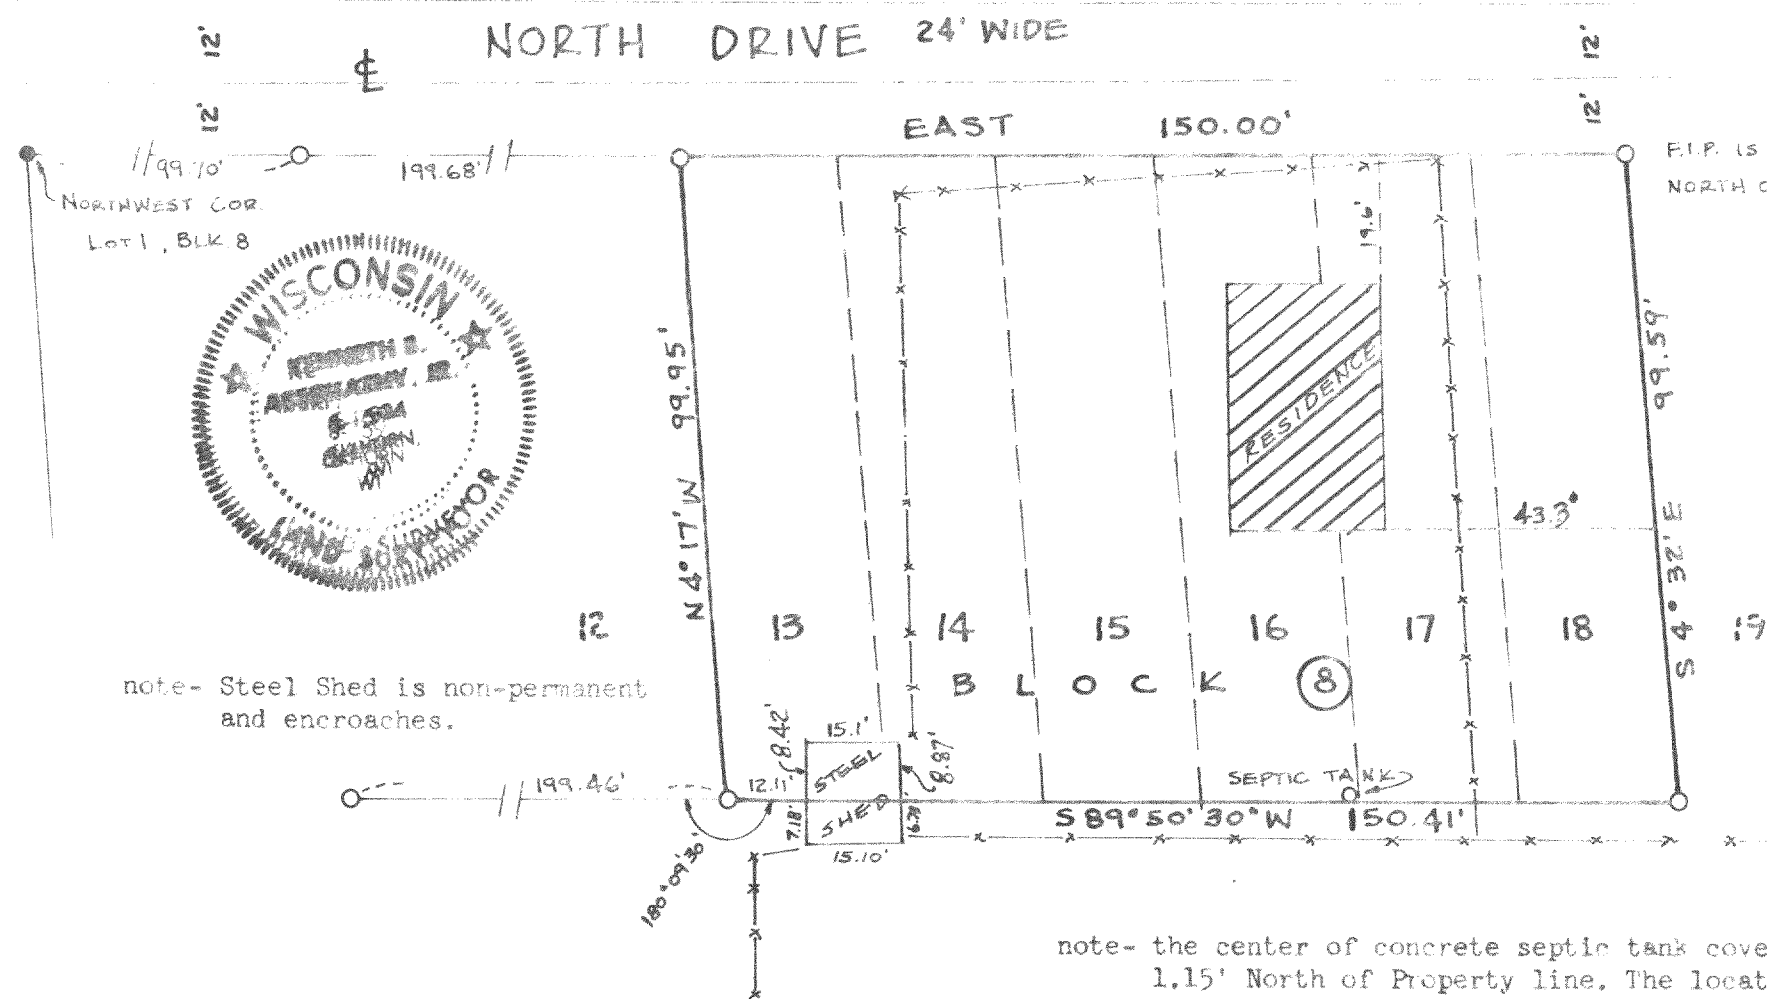


OWNERS- Robert H. and Christine E.
Miller
P.O. Box 608
Lake Geneva, Wis. 53147

PLAT OF SURVEY
LOTS 13-18 INCLUSIVE OF BLOCK 8 OF LAKE WANDAWEGA SUBDIVISION
LOCATED IN SECTION 2, TOWN 3 NORTH, RANGE 16 EAST, TOWN OF
SUGAR CREEK, WALWORTH COUNTY, WISCONSIN.

Note- Subdivision is recorded in Vol. 8 P. 25 of Plats
Cab. 1 Slide 98, Register of Deeds, Walworth Cnty.

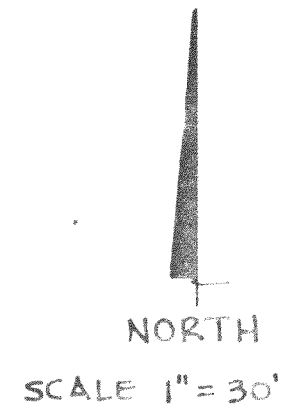

note- Steel Shed is non-permanent
and encroaches.

note- the center of concrete septic tank cover is
1.15' North of Property line. The location of the field
was not determined.

LEGEND

- - 3/4" dia. iron rod found
- - 1 1/2" dia. iron pipe found
- x---x---x--- Existing Fence

I hereby certify that, I have surveyed
the above described property, that the
plat shown hereon is an accurate survey,
a true representation thereof, correctly
shows the exterior boundaries and the cor-
rect measurements thereof, and correctly
shows the improvements thereon, to the best
of my professional knowledge and belief.

Kenneth B. Abernathy Jr.
Kenneth B. Abernathy Jr.
Wis. Reg. No. S-1594
7/21/84