

Farris, Hansen & Associates, Inc.


Engineering, Surveying & Land Planning
 P.O. BOX 487
 715 W. WALWORTH STREET
 ELKHORN, WISCONSIN 53121

PLAT OF SURVEY OF LOTS 1,2,3,4, & 25, BLOCK 45, FOURTH MAP OF INTERLAKEN,
 TOWN OF SUGAR CREEK, WALWORTH COUNTY, WISCONSIN

WORK ORDERED BY: CARL KITTINGER
 RT 4 BOX 244
 ELKHORN, WISC.

LEGEND

- Information of Record- ()
 Original 4" sq. conc. mon. with sq. iron bar center - □
 1" iron pipe set - ○

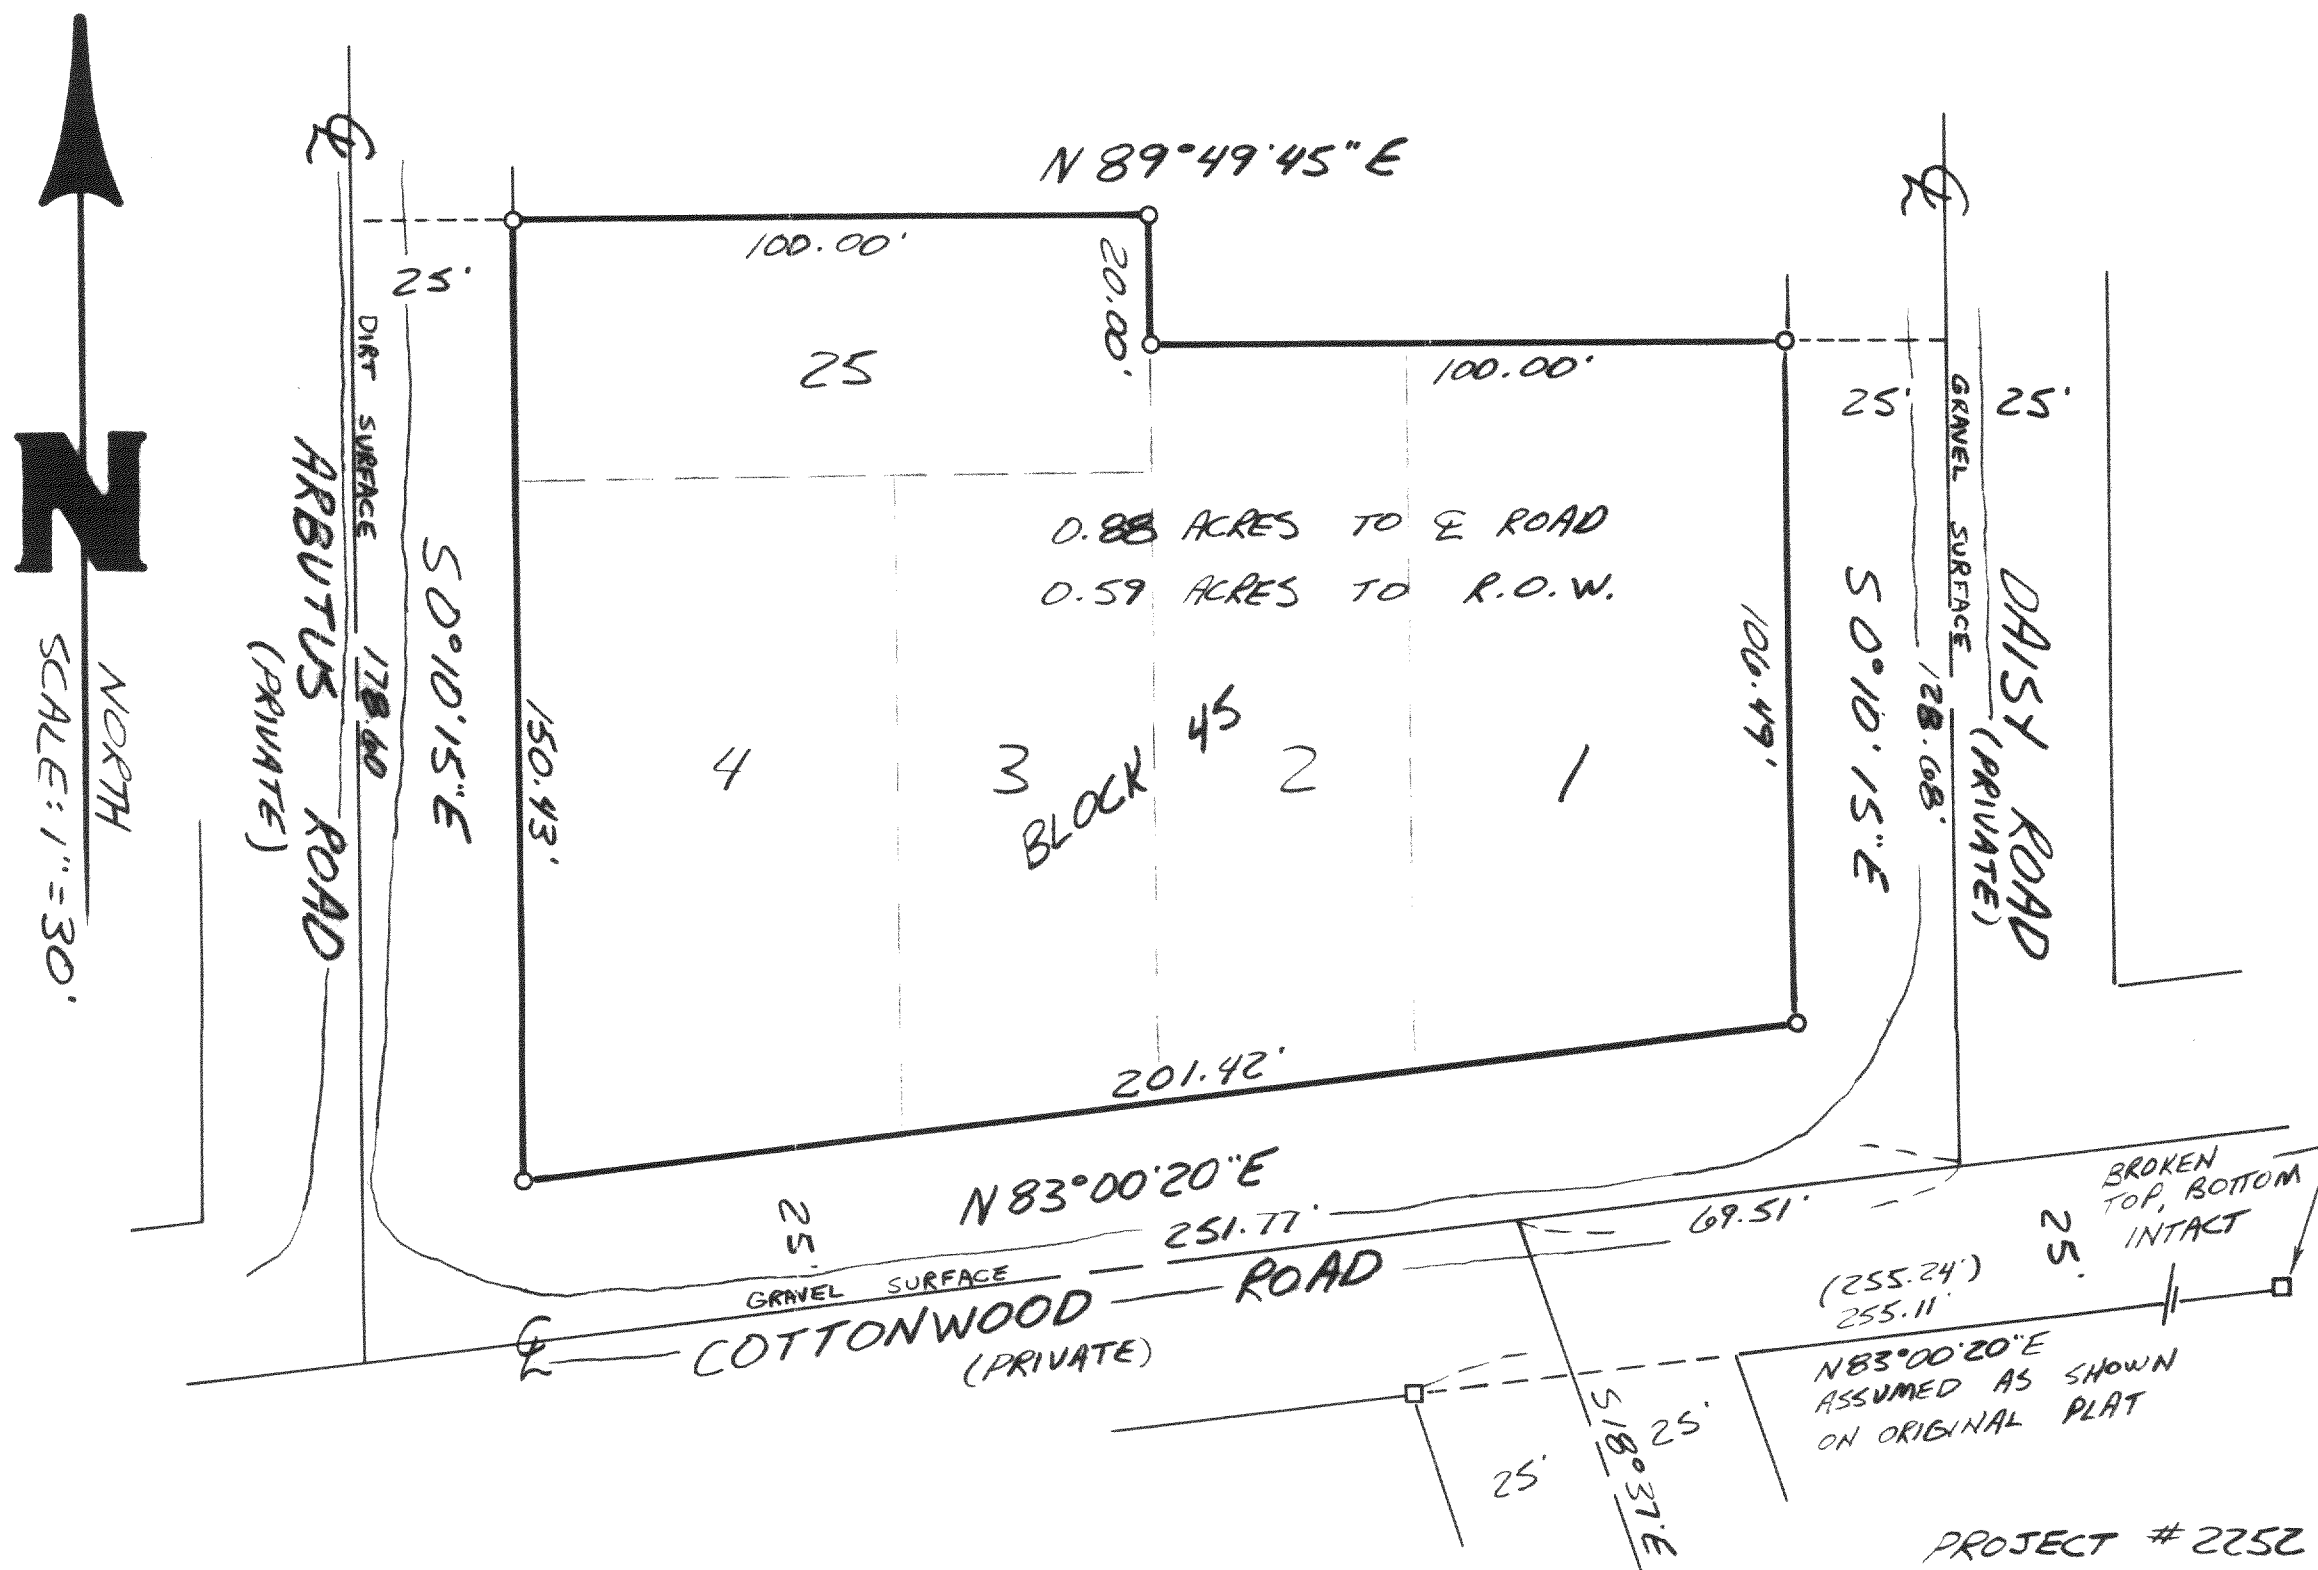

I hereby certify that I have surveyed the above described property and that this plat is a true & accurate representation thereof.

Robert A. Farris

Robert A. Farris, R.L.S.

Dated this 23 day of May, 1984

