


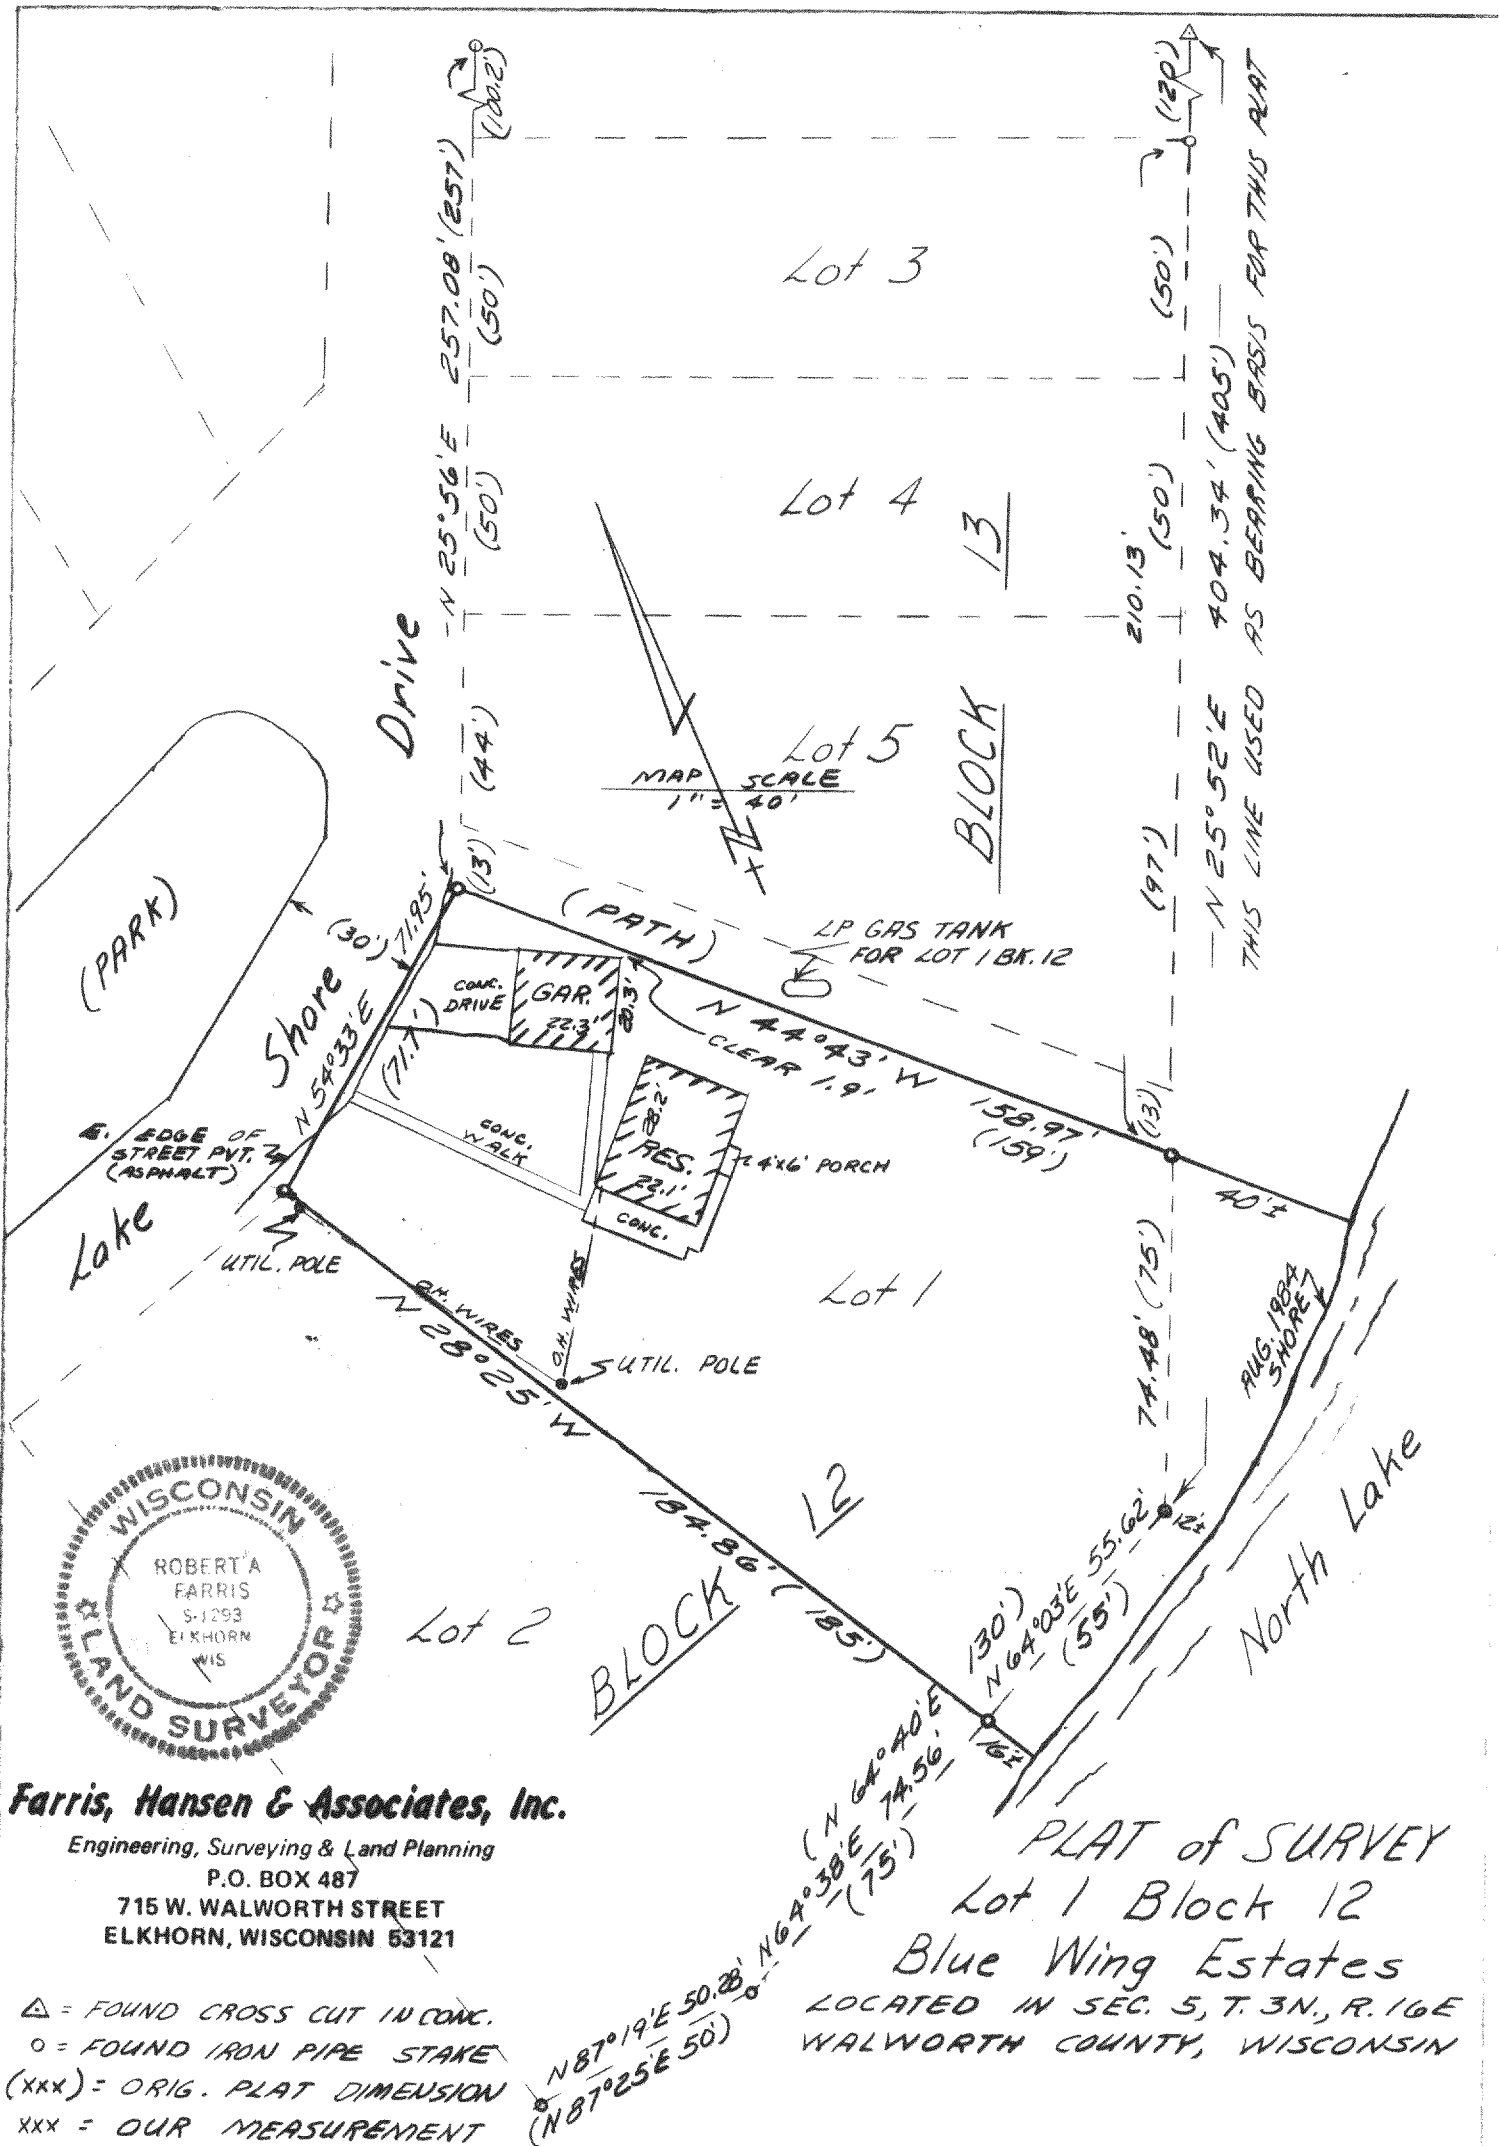

I hereby certify that at the direction of Jan Kodner the above described property has been surveyed under my direction and that the above map is a true representation thereof and shows the size and location of all buildings thereon, boundary fences, apparent easements, roadways and visible encroachments, if any.

This survey is made for the use of the present owners of the property, and also those who purchase, mortgage, or guarantee the title thereto within one (1) year from the date hereof.

Robert A. Farris
ROBERT A. FARRIS, PLS

DATED AUG 21, 1984

PROJ. #2297