


COOPER SURVEYING SERVICES

Rural - Residential - Commercial

Route 3, Box 255 :: Elkhorn, Wisconsin 53121

Phone (414) 723-6265

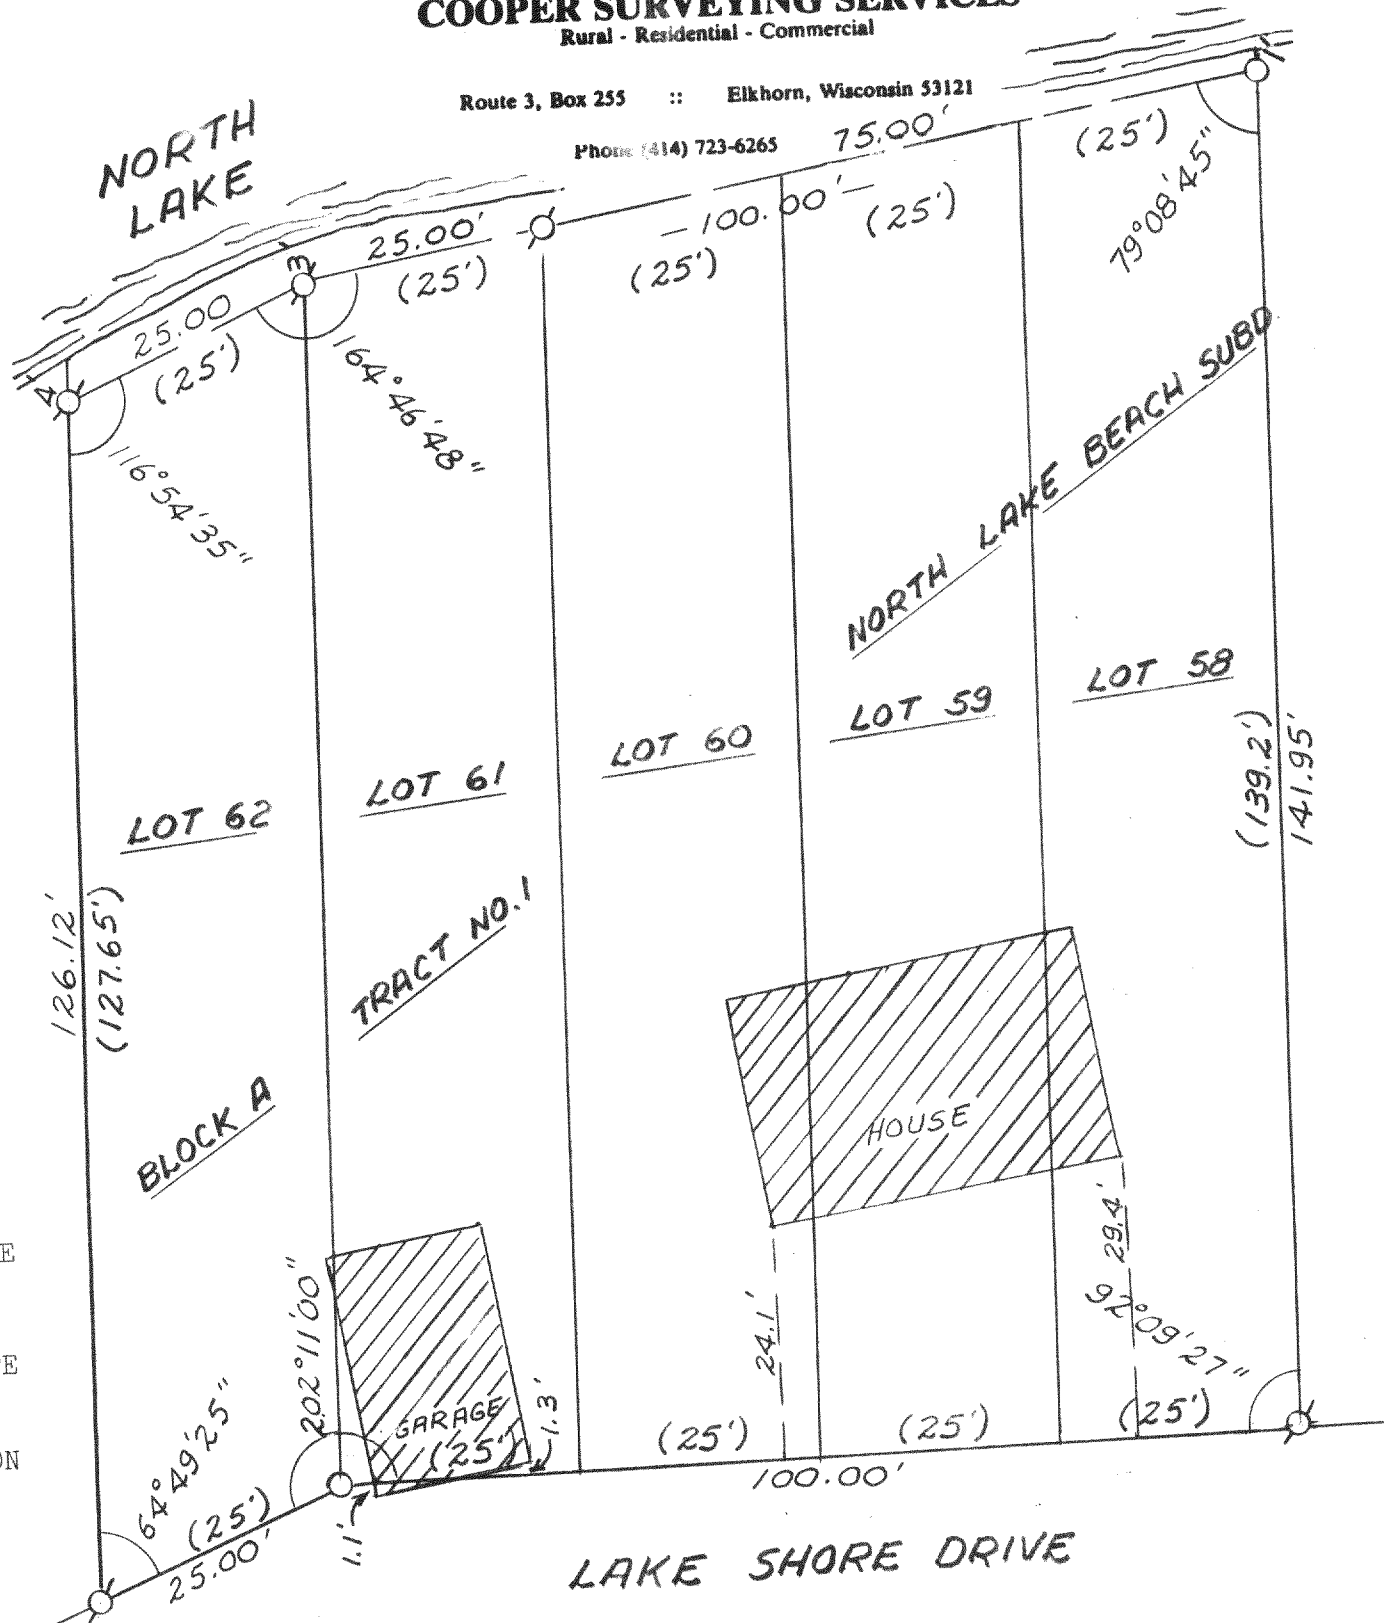

LEGEND

- Ø - IRON PIPE FOUND
- - 1" x 24" IRON PIPE SET
- () - RECORD DIMENSION

NOTE: THE WEST LINE OF LOT 62 IS ASSUMED TO BEAR "NORTH"




PLAT OF SURVEY OF
LOTS 58-62, BLOCK A, TRACT NO. 1 OF NORTH LAKE BEACH, TOWN 3 NORTH,
RANGE 16 EAST, TOWN OF SUGAR CREEK, WALWORTH COUNTY, WISCONSIN.

SURVEY ORDERED BY:

MODERN REALTY
ELKHORN, WIS.

I, DANIEL D. COOPER, REGISTERED SURVEYOR,
DO HEREBY CERTIFY THAT I HAVE SURVEYED THE
PROPERTY DESCRIBED HEREON AND THAT THE MAP
SHOWN HEREON IS A TRUE AND ACCURATE REPRESENTATION
THEREOF TO THE BEST OF MY PROFESSIONAL KNOWLEDGE AND BELIEF.

Daniel D. Cooper
DANIEL D. COOPER, RLS NO. S-1464
DATED THIS 15TH DAY OF JUNE, 1984.

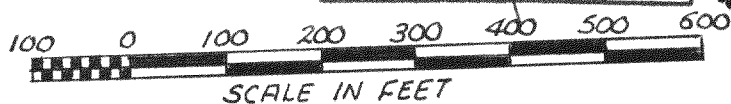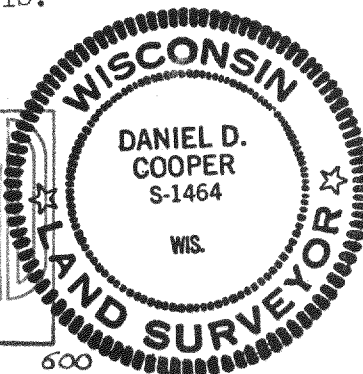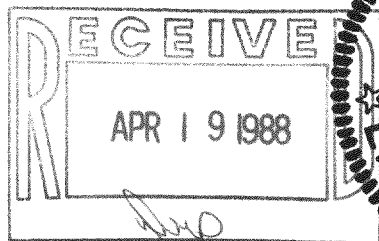

PROJ. NO. 1937