

FOUND IRON

LAKE SHORE DRIVE


FOUND IRONS

MONROE AVE

SUPERIOR AVE

BEACH TRACT 1


NORTH LAKE

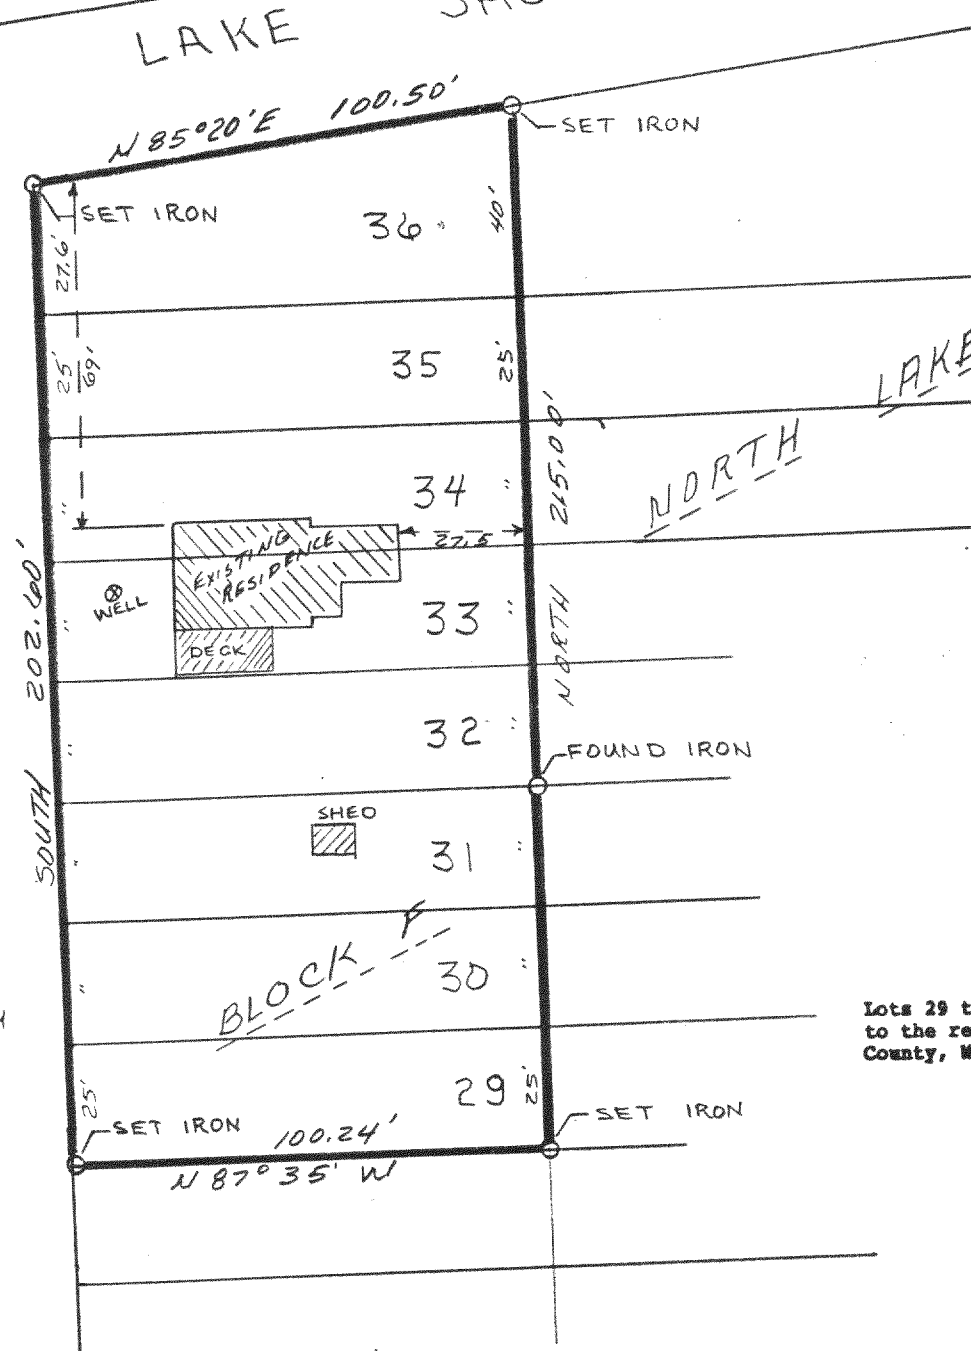

SURVEY ORDERED BY:
MODERN REALTY

BEARING REFERENCE: EASTERLY
LINE OF PARCE ASSUMED TO
BEAR NORTH-SOUTH

Lots 29 through 36 in Block F, North Lake Beach Tract 1, according
to the recorded plat thereof in Town 3 North, Range 16 East, Walworth
County, Wisconsin.

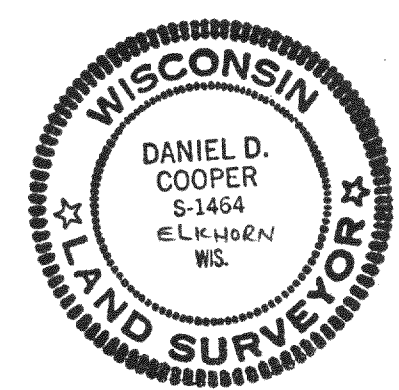


I, DANIEL D. COOPER, REGISTERED SURVEYOR, DO HEREBY CERTIFY THAT
I HAVE SURVEYED THE PROPERTY DESCRIBED HEREON AND THAT THE MAP
SHOWN HEREON IS A TRUE AND ACCURATE REPRESENTATION THEREOF TO THE
BEST OF MY PROFESSIONAL KNOWLEDGE AND BELIEF.

DATED THIS 11TH DAY OF Aug. 1984
DANIEL D. COOPER, RLS NO. S-1464



SCALE 1"=40'

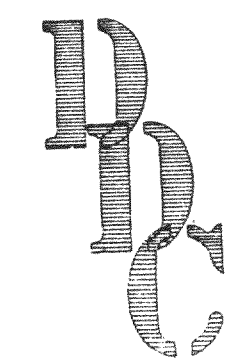

ROUTE 4, BOX 501 B
ELKHORN, WI 53121

PH 414-723-6265

SURVEYING • MODULAR HOMES

316-332