


COOPER SURVEYING SERVICES
Rural - Residential - Commercial

Route 3, Box 255 :: Elkhorn, Wisconsin 53121

Phone (414) 723-6265

PLAT OF SURVEY OF LOTS 38, 39, 40, 41 OF
BLOCK 69 OF LAKE WANDAWEGA SUBDIVISION,
BEING A SUBDIVISION LOCATED IN THE TOWN
OF SUGAR CREEK, WALWORTH COUNTY, WI. FOUND IRON-

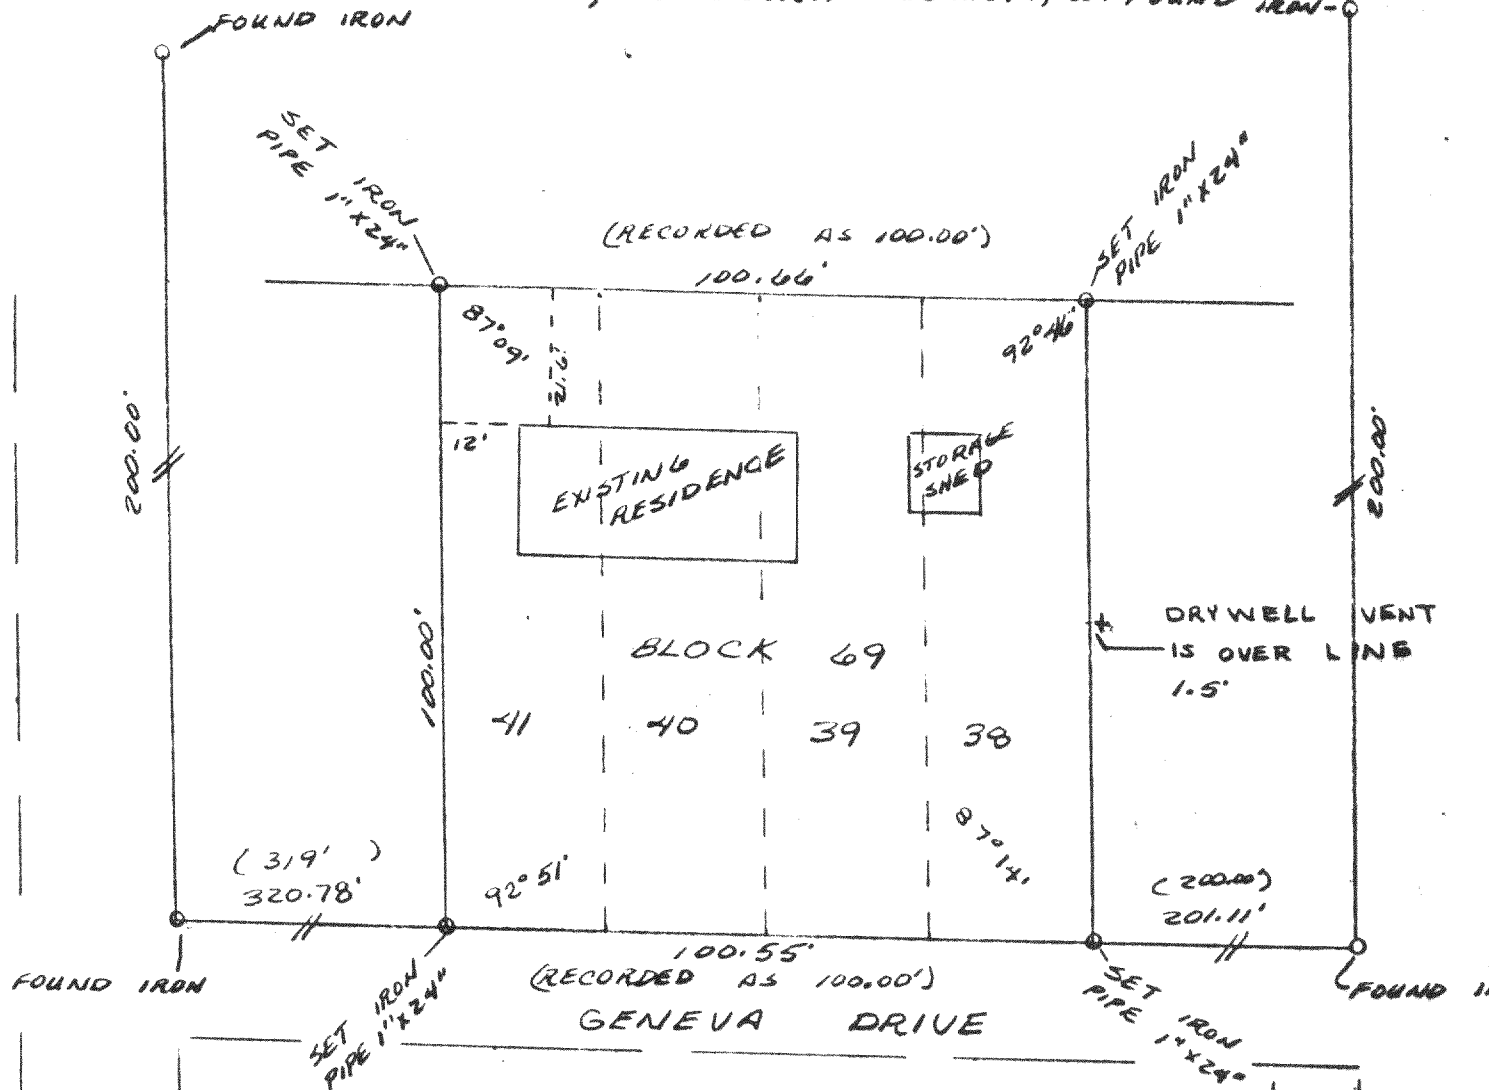


SURVEY ORDERED BY: BONNIE DEMIS

I HEREBY CERTIFY that I have surveyed
the above described property and that
the above map is a true representation
thereof and shows the size and location
of the property to the best of my
professional knowledge and belief.

Dated this 9 day of Aug, 1981

Daniel D Cooper

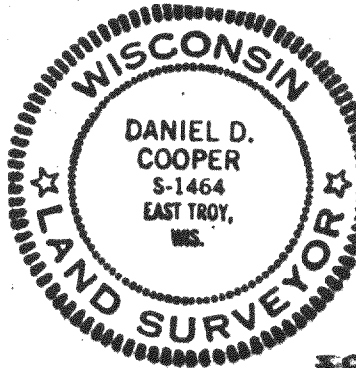

NORTH
SCALE 1"=30'

GLW-108

316-334
DRAWING NO.