


COOPER SURVEYING SERVICES

Rural - Residential - Commercial

Route 4 Box 508 B :: Elkhorn, Wisconsin 53121

Phone (414) 723-6265

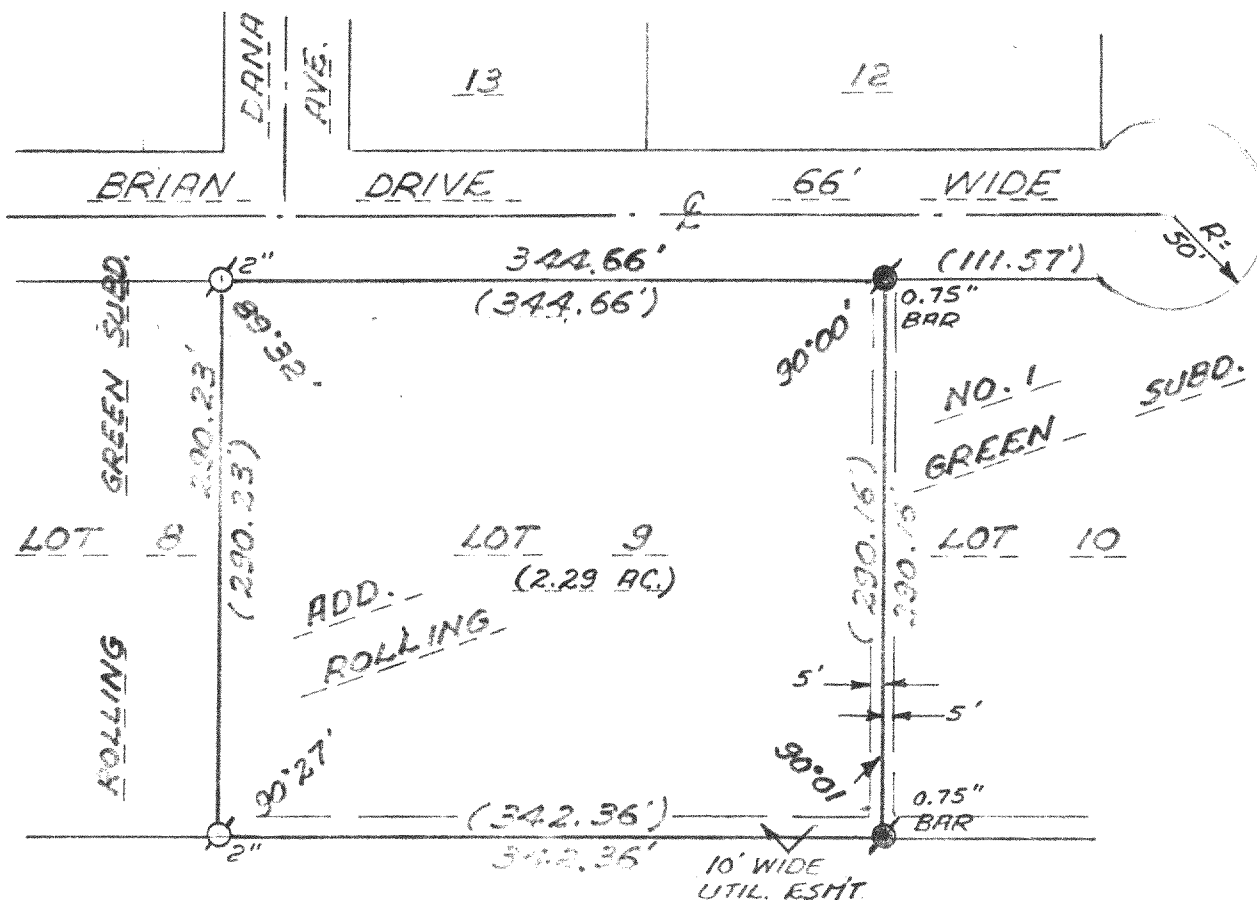

PLAT OF SURVEY OF

LOT 9 OF ROLLING GREEN SUBDIVISION ADDITION NO. 1
 LOCATED IN SECTION 34, TOWN 3 NORTH, RANGE 16 EAST, TOWN
 OF SUGAR CREEK, WALWORTH COUNTY, WISCONSIN.

OWNER: DONALD COOPER

LEGEND


- Ø-IRON PIPE FOUND
- IRON ROD SURVEY STAKE FOUND
- ()-RECORD DIMENSION

I, DANIEL D. COOPER, REGISTERED SURVEYOR,
 DO HEREBY CERTIFY THAT I HAVE SURVEYED
 THE PROPERTY DESCRIBED HEREON AND THAT THE
 MAP SHOWN HEREON IS A TRUE AND ACCURATE
 REPRESENTATION THEREOF TO THE BEST OF MY
 KNOWLEDGE AND BELIEF.

Daniel D. Cooper

DANIEL D. COOPER, RLS NO. 1464


DATED THIS 3rd DAY OF Aug, 1984.

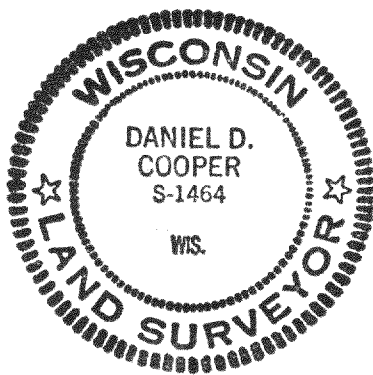

PROJ. NO. 1943

316-335

Rural - Residential - Commercial

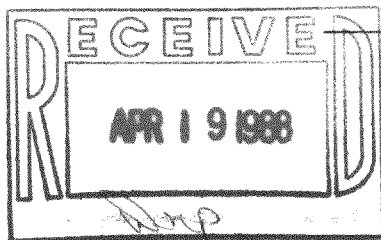Phone (414) 723-6265

LOT 9 OF ROLLING GREEN SUBDIVISION ADDITION NO. 1
LOCATED IN SECTION 34, TOWN 3 NORTH, RANGE 16 EAST, TOWN
OF SUGAR CREEK, WALWORTH COUNTY, WISCONSIN.


OWNER: DONALD COOPER

Ø-IRON PIPE FOUND
○- IRON ROD SURVEY
STAKE FOUND
()-RECORD DIMENSION

I, DANIEL D. COOPER, REGISTERED SURVEYOR,
DO HEREBY CERTIFY THAT I HAVE SURVEYED
THE PROPERTY DESCRIBED HEREON AND THAT THE
MAP SHOWN HEREON IS A TRUE AND ACCURATE
REPRESENTATION THEREOF TO THE BEST OF MY
KNOWLEDGE AND BELIEF.

Daniel D. Cooper
DANIEL D. COOPER, RLS NO. 1464

DATED THIS 3rd DAY OF Aug, 1984.

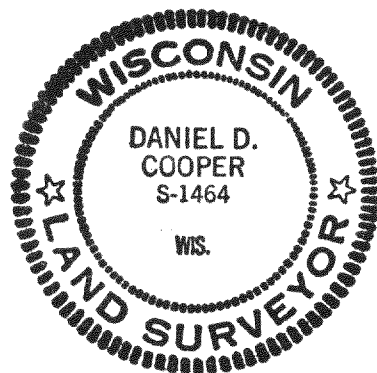

PROJ. NO. 1943