

PLAT OF SURVEY OF

LOTS 24, 25, 26, 27 & 28 OF BLOCK 2, NORTH LAKE BEACH,
TRACK #3, LOCATED IN THE SE $\frac{1}{4}$ OF SECTION 5, AND
THE NE $\frac{1}{4}$ OF SECTION 8, T3N, R16E, WALWORTH COUNTY,
WISCONSIN.


OWNER: John J. Nelson
R.R. 2 Box 172B
Elkhorn, Wis. 53121

SURVEYOR'S CERTIFICATE:

I, Kenneth B. Abernathy Jr., hereby certify that I have surveyed the above described property and that the plat shown hereon is an accurate survey and a true representation thereof and correctly shows the exterior boundary lines and all divisions of said property to the best of my professional knowledge and belief.

Dated- December 14, 1984

Kenneth B. Abernathy Jr.
Kenneth B. Abernathy Jr.
Wis. Reg. Land Surveyor
S- 1594

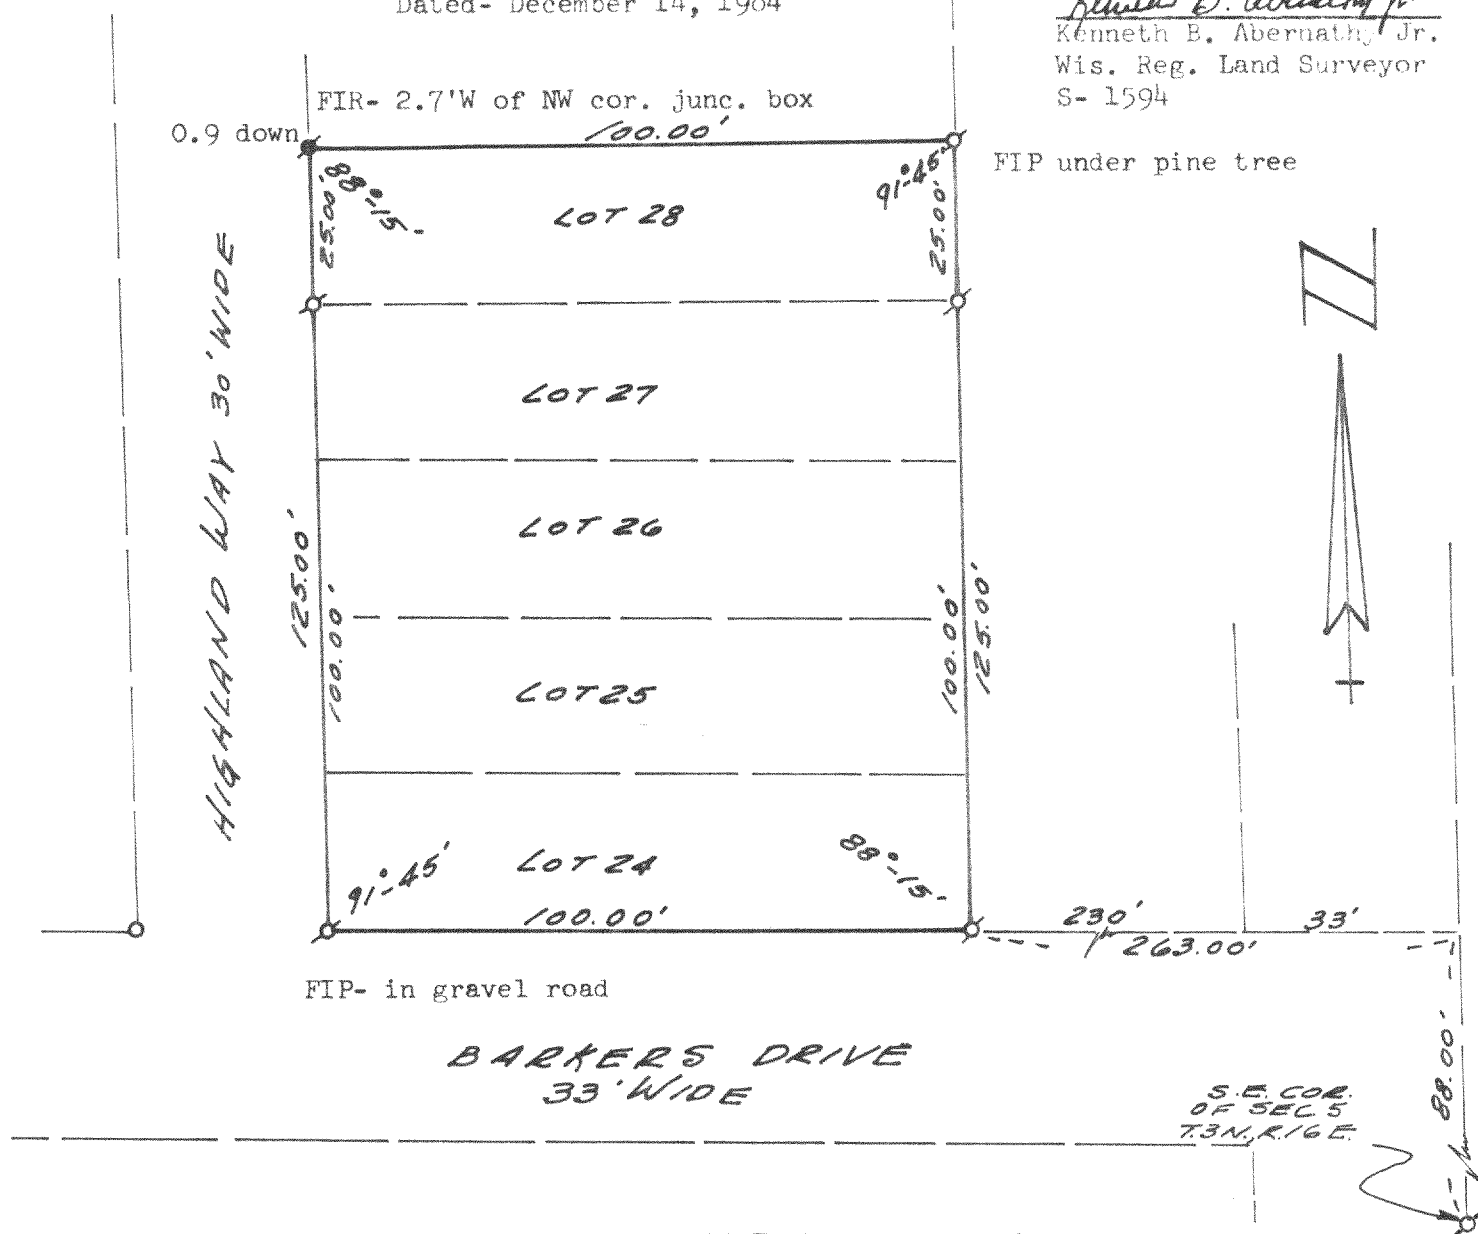

ABERNATHY and ASSOCIATES
LAND SURVEYORS


Rt. 3 Box 273, Elkhorn, Wis. 53121
723-4260

LEGEND

Ø- 1 $\frac{1}{2}$ " dia. iron pipe found

⦿- 3/4" " " rod found

Note: Existing Residence not located at owners request.

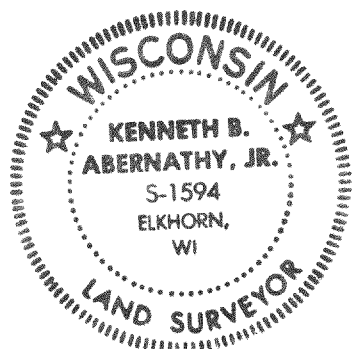

GNL133-350

316-337

Job No. 1984.1203