
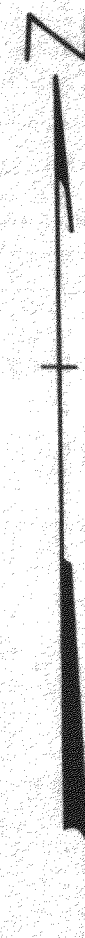
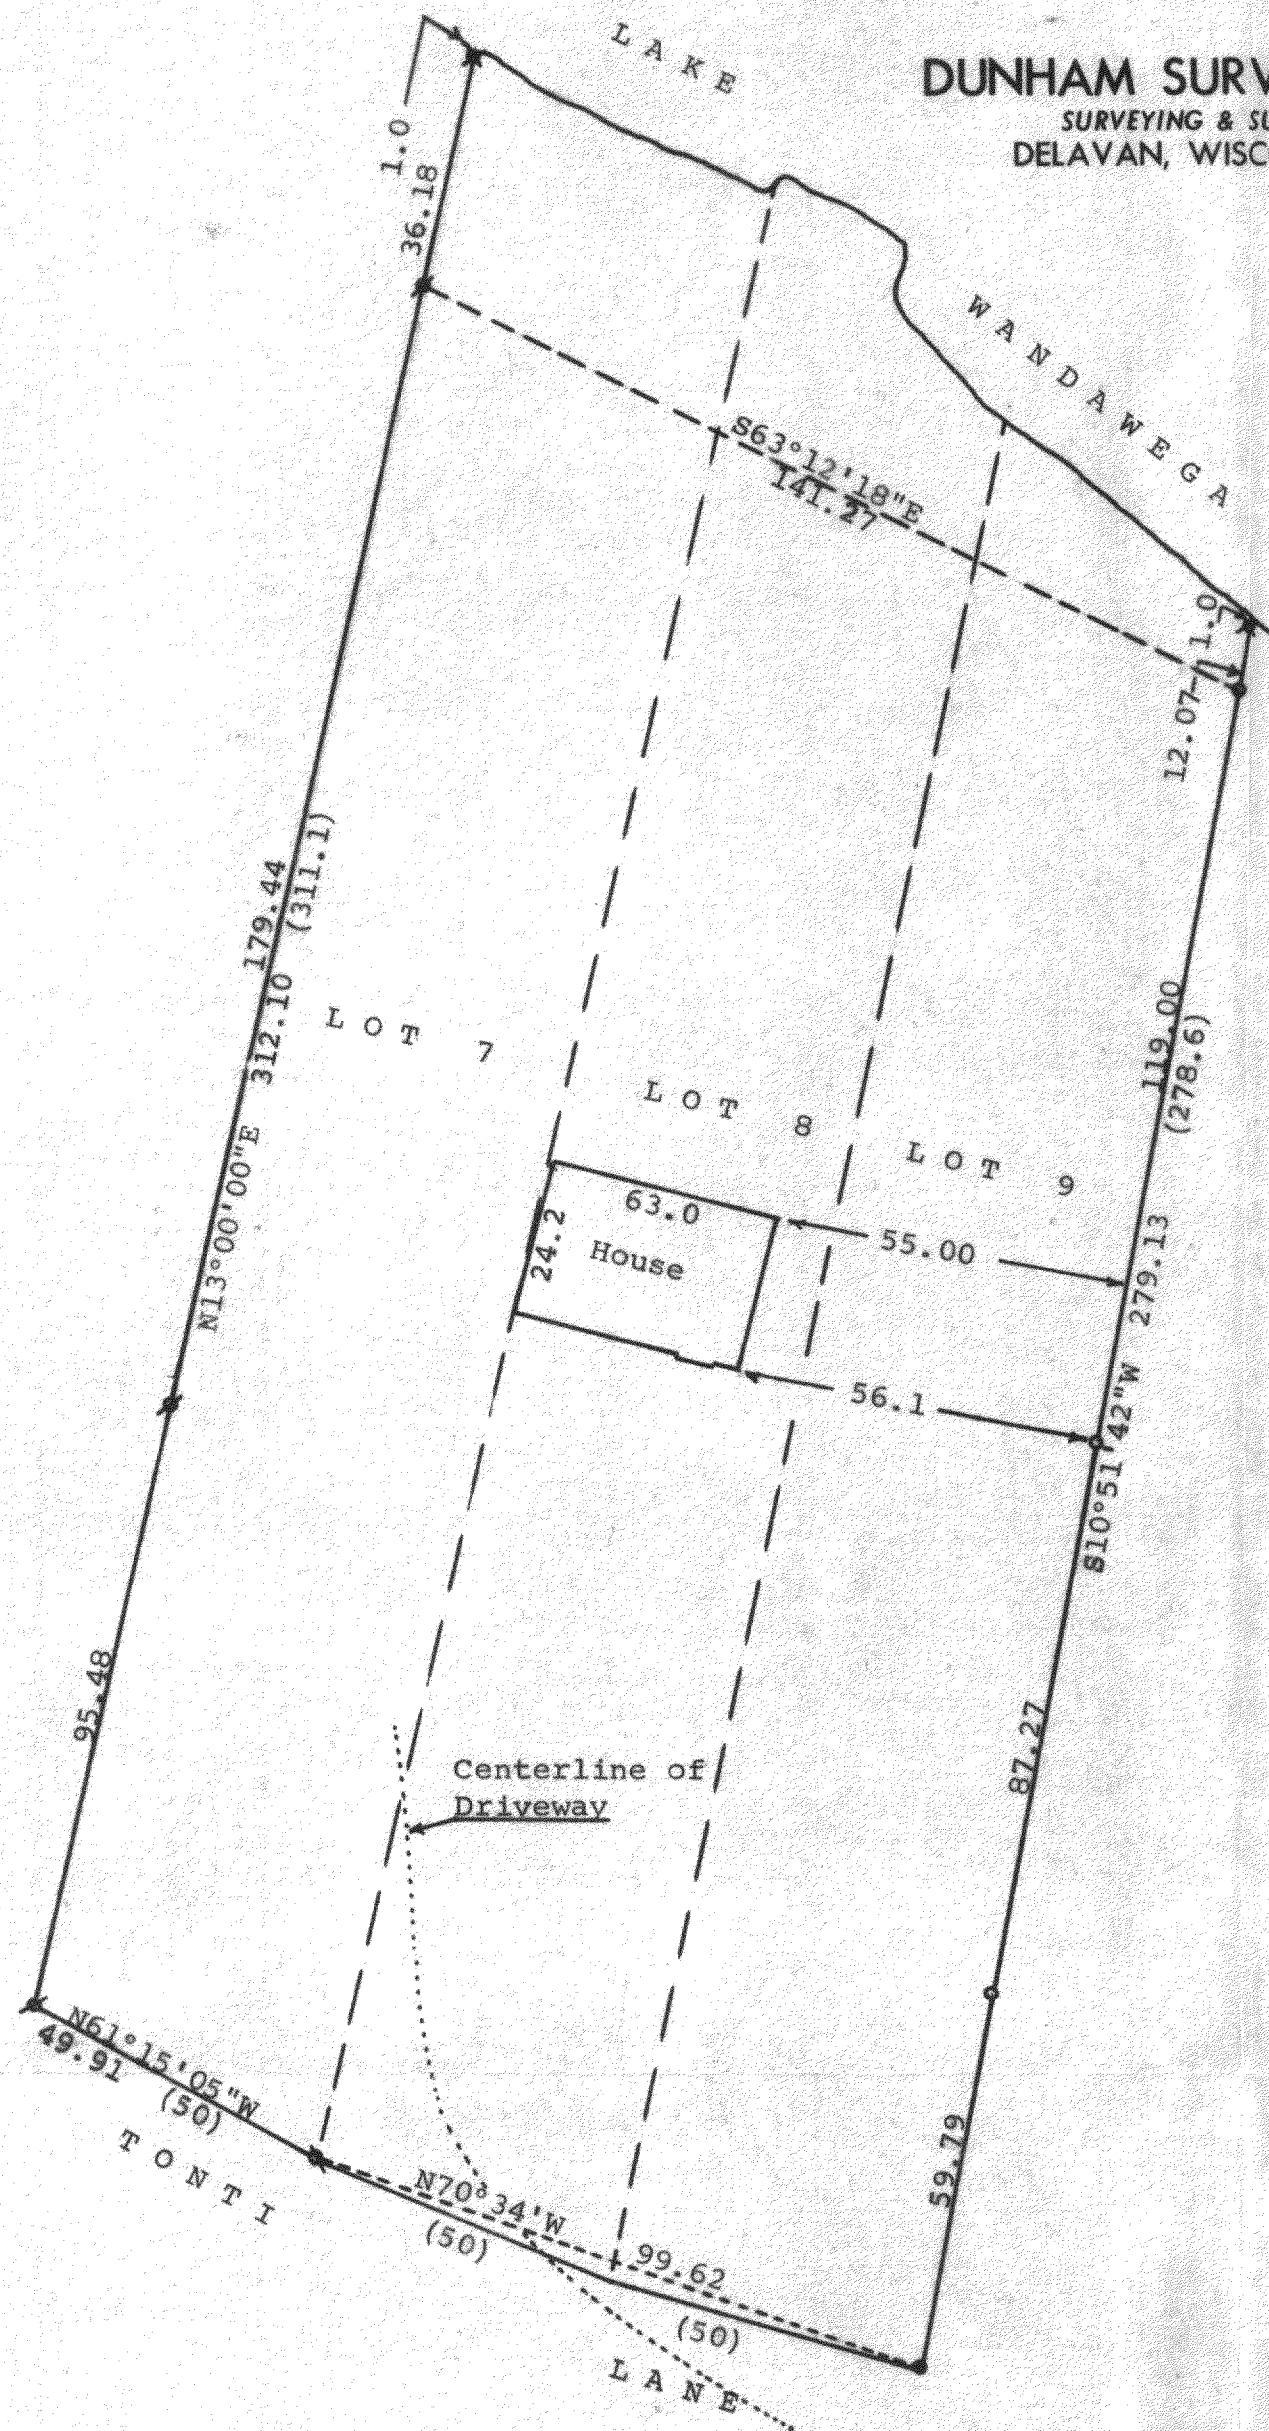


DUNHAM SURVEYING, S.C.
SURVEYING & SUBDIVIDING
DELAVER, WISCONSIN 53115

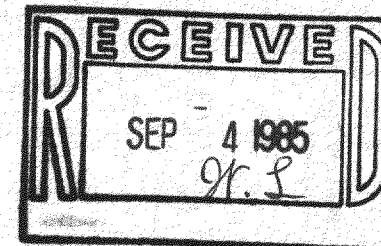

Scale - 1" = 30'

- ⊕ = 1" Iron Pipe Found
- ⊗ = 2" Tall 3/4" Iron Pipe Found
- ⊞ = 3/4" Iron Pipe in concrete found
- = concrete monument found
- = 3/4" X 24" iron pipe set
- ⊞ = Posey Pin found and 3/4" X 24" iron pipe set
- = fence line
- (0.00) = recorded distance

Bearings referenced to the westerly line of Lot 7 with the assumed bearing of N13°00'00"E

Survey ordered by: The Rauland Agency
607 East Walworth Avenue
Delavan, WI 53115

STATE OF WISCONSIN)
COUNTY OF WALWORTH)

I, George T. Dunham, Surveyor, certify that I have surveyed the property described as follows:

Lots 7, 8, and 9 in Block 1 of Lake Wandawega Highlands, a subdivision located in Section 11, T 3 N, R 16 E, Walworth County, Wisconsin,

and that the above map is a true representation thereof and shows the size and location of the property, its exterior boundaries, the location of all visible structures and dimensions of all principal buildings thereon, boundary fences, apparent easements, roadways and visible encroachments, if any, and that I have surveyed the property hereon described according to the official records to the best of my knowledge and belief.

April 25, 1985

George T. Dunham
George T. Dunham, Surveyor

