

PLAT OF SURVEY OF

CERTIFIED SURVEY MAP No. 119 LOCATED
IN THE NW 1/4 SECTION 12 T3N, R16E, TOWN
OF SUGAR CREEK, WALWORTH COUNTY, WISCONSIN

JENSEN SURVEYING & MAPPING S.C.


P.O. BOX 322

45 S. WISCONSIN ST.

ELKHORN, WISC

53121

PHONE (414) 723-3434

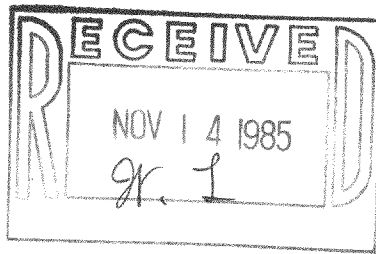

LEGEND



O ~ IRON PIPE FOUND
Ø ~ 1" DIA. IRON PIPE
SET

SURVEYED FOR ~

THE RAULAND AGENCY INC.
118 KENDUSHA STREET
P.O. BOX 159
WALWORTH, WISC. 53184

BEARINGS REFERENCED TO C.T.H. "A" AND LAKE
WANDAWEGA HIGHLANDS 1ST ADDITION

SCALE ~ 1" = 50'

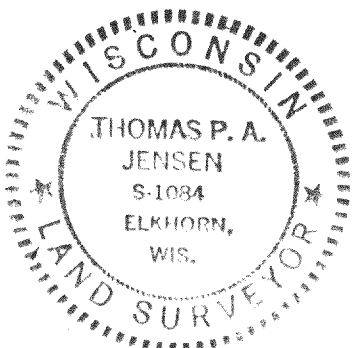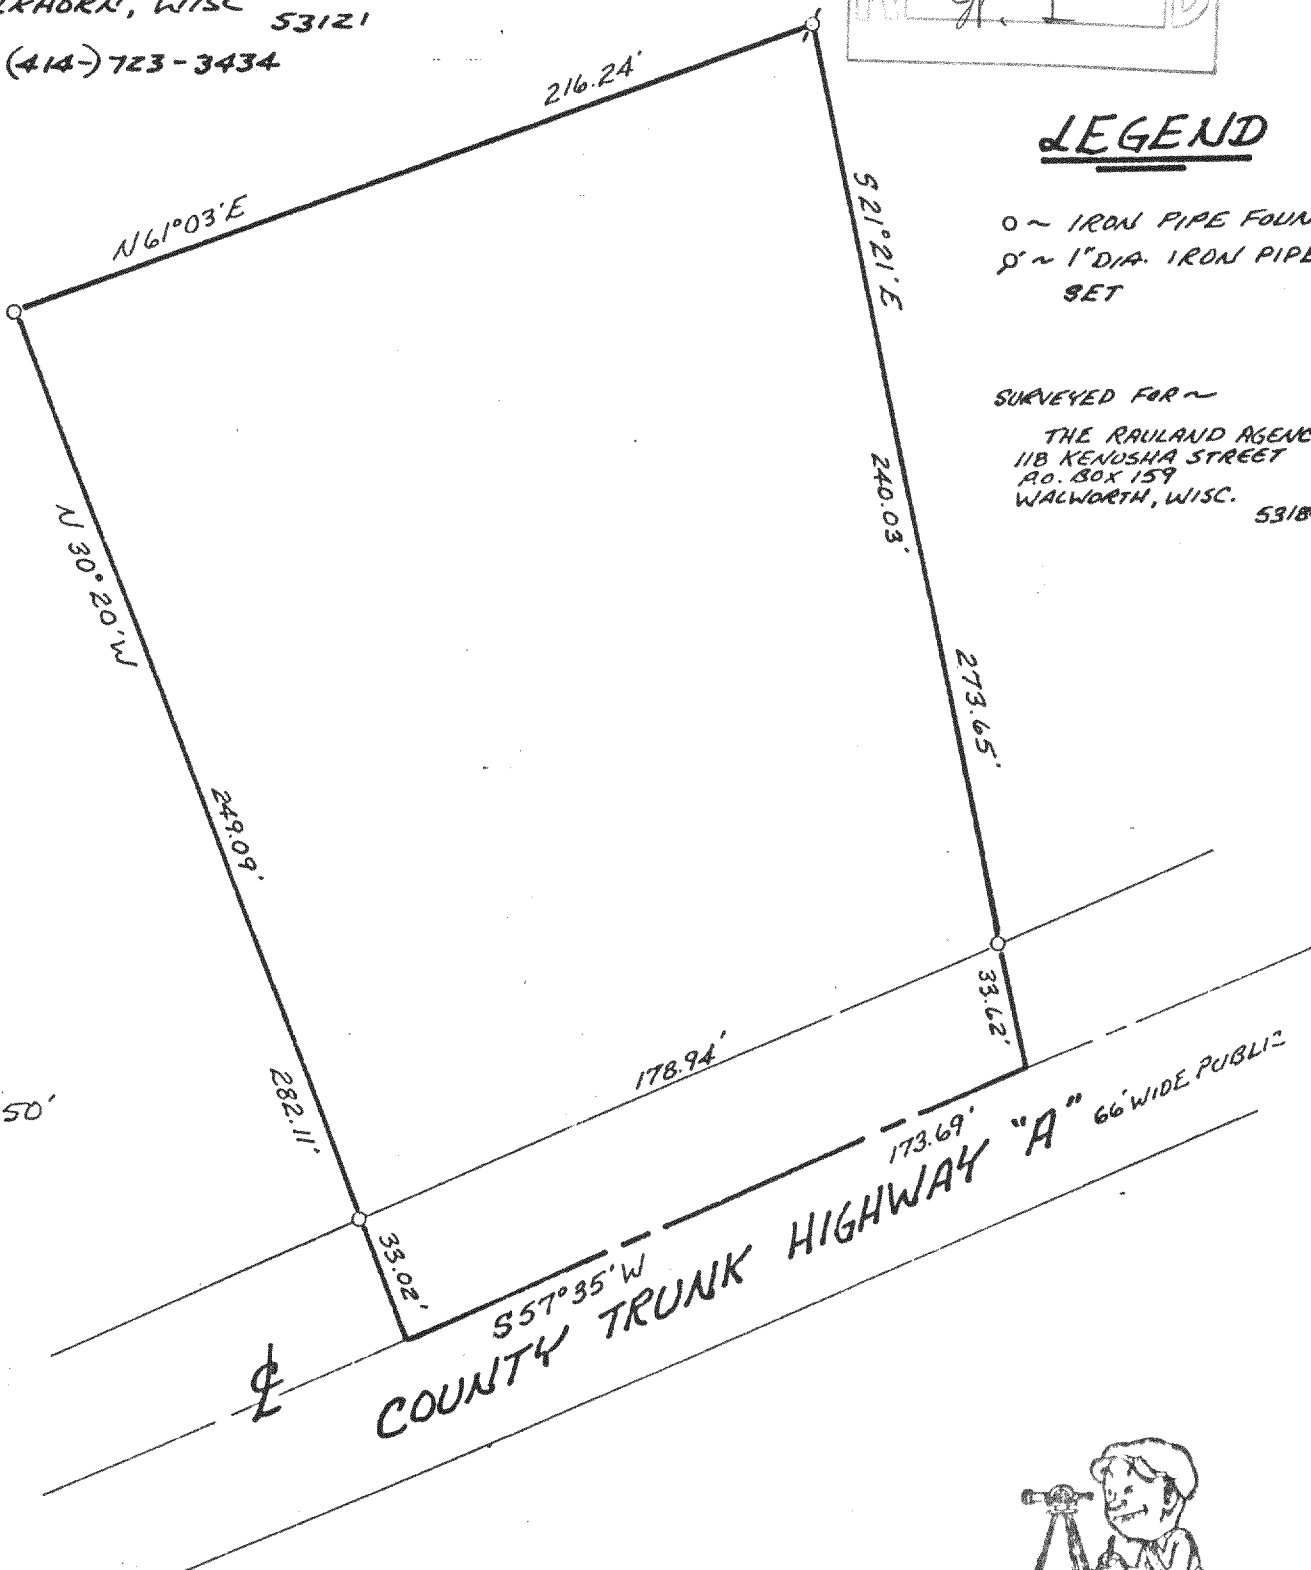

I THOMAS P.A. JENSEN, WISC. REGISTERED LAND
SURVEYOR, DO HEREBY CERTIFY THAT THIS SURVEY WAS
PERFORMED BY ME, OR UNDER MY DIRECTION, IN FULL
COMPLIANCE WITH THE OWNERS/AGENT'S INSTRUCTIONS AND
CHAPTER A-E 5 OF THE WIS. ADMIN. CODE "MINIMUM
STANDARDS FOR PROPERTY SURVEYS"; AND THAT THIS
MAP IS AN ACCURATE REPRESENTATION THEREOF TO THE
BEST OF MY KNOWLEDGE AND BELIEF.

Thomas P.A. Jensen
THOMAS P.A. JENSEN S-1084

DATE ~ APRIL 15, 85

1985.021