
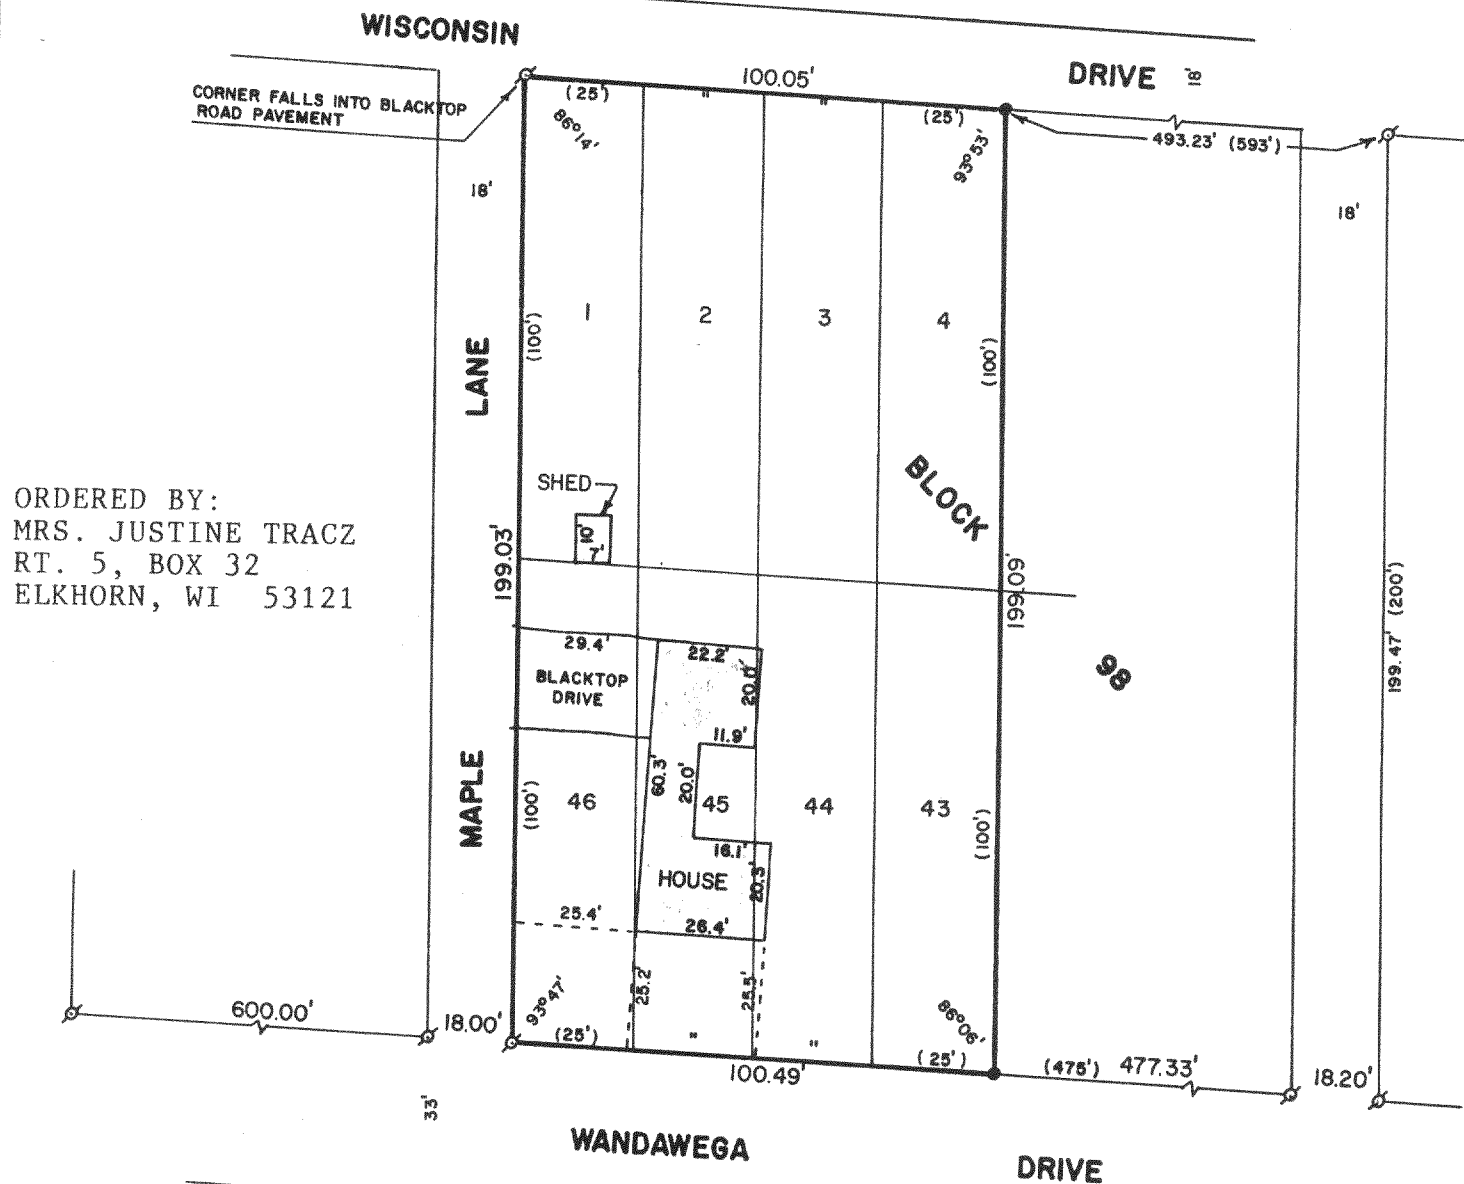


ABELL
SURVEYING & MAPPING
DELAVER, WISCONSIN 53115
414-728-6737

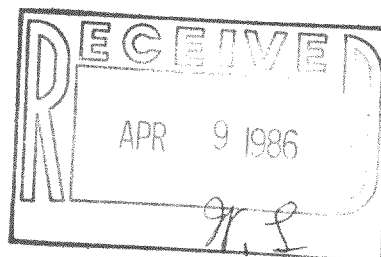

ORDERED BY:
MRS. JUSTINE TRACZ
RT. 5, BOX 32
ELKHORN, WI 53121


PLAT OF SURVEY OF

LOTS 1-4 AND 43-46, BLOCK 98 OF LAKE WANDAWEGA
SUBDIVISION, TOWN 3 NORTH, RANGE 16 EAST,
WALWORTH COUNTY, WISCONSIN.



SCALE - 1"=40'

- LEGEND
- ⊗ - IRON PIPE FOUND
 - - IRON ROD SET
 - () - RECORDED AS

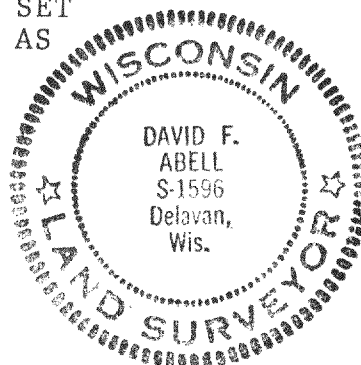

I, DAVID F. ABELL, DO HEREBY CERTIFY
THAT I HAVE SURVEYED THE PROPERTY
HEREON DESCRIBED ACCORDING TO THE
OFFICIAL RECORDS, AND THAT THE PLAT
HEREON IS A CORRECT REPRESENTATION
OF THE LOT LINES TO THE BEST OF MY
KNOWLEDGE AND BELIEF.

David F. Abell

DAVID F. ABELL
WISCONSIN REGISTERED LAND SURVEYOR, S-1596

DATE *April 4, 1986*
JOB NUMBER - 0486002

316-351A