


PLAT OF SURVEY

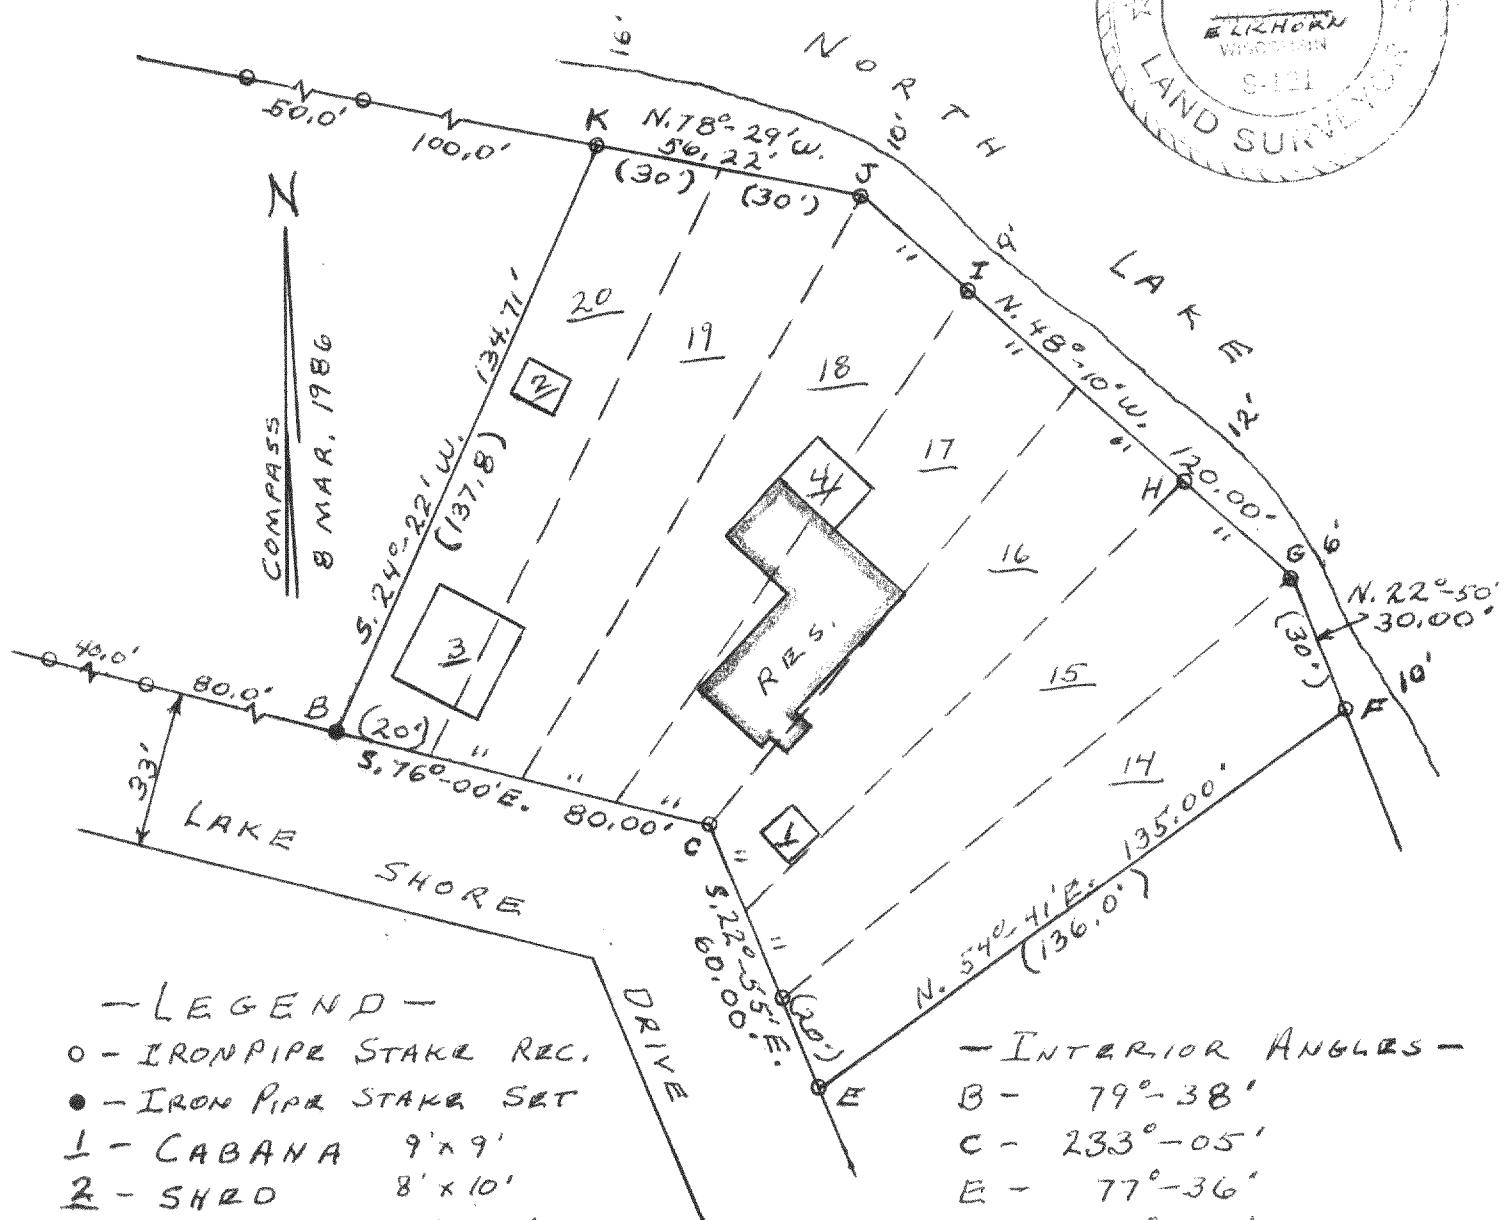

- LEGEND -
- - IRON PIPE STAKE REC.
 - - IRON PIPE STAKE SET
 - 1 - CABANA 9' x 9'
 - 2 - SHED 8' x 10'
 - 3 - GARAGE 20' x 22'
 - 4 - PATIO 12' x 16'
 - () - RECORDED DISTANCE
 - SCALE 1" = 40'

- INTERIOR ANGLES -
- B - 79°-38'
 - C - 233°-05'
 - E - 77°-36'
 - F - 102°-29'
 - G - 154°-40'
 - J - 149°-41'
 - K - 102°-51'

I, JAMES M. JENSEN, OWNER, DO HEREBY CERTIFY THAT I HAVE SURVEYED LOTS 14 THROUGH 20, BLOCK A, NORTH LAKE BEACH, TRACT 1, LOCATED IN SECTION 5, TOWN 3 NORTH, RANGE 16 EAST, WALWORTH COUNTY, WISCONSIN AND THAT THE ABOVE PLAT IS A TRUE REPRESENTATION OF THAT SURVEY.

James M. Jensen 10 Mar. 1986
JAMES M. JENSEN DATE
REGISTERED WISCONSIN LAND SURVEYOR No. 5-121