



DUNHAM SURVEYING, S.C.
SURVEYING & SUBDIVIDING
DELAVER, WISCONSIN 53115

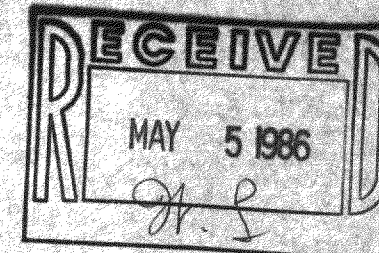

P R D D O C K

D R I V E

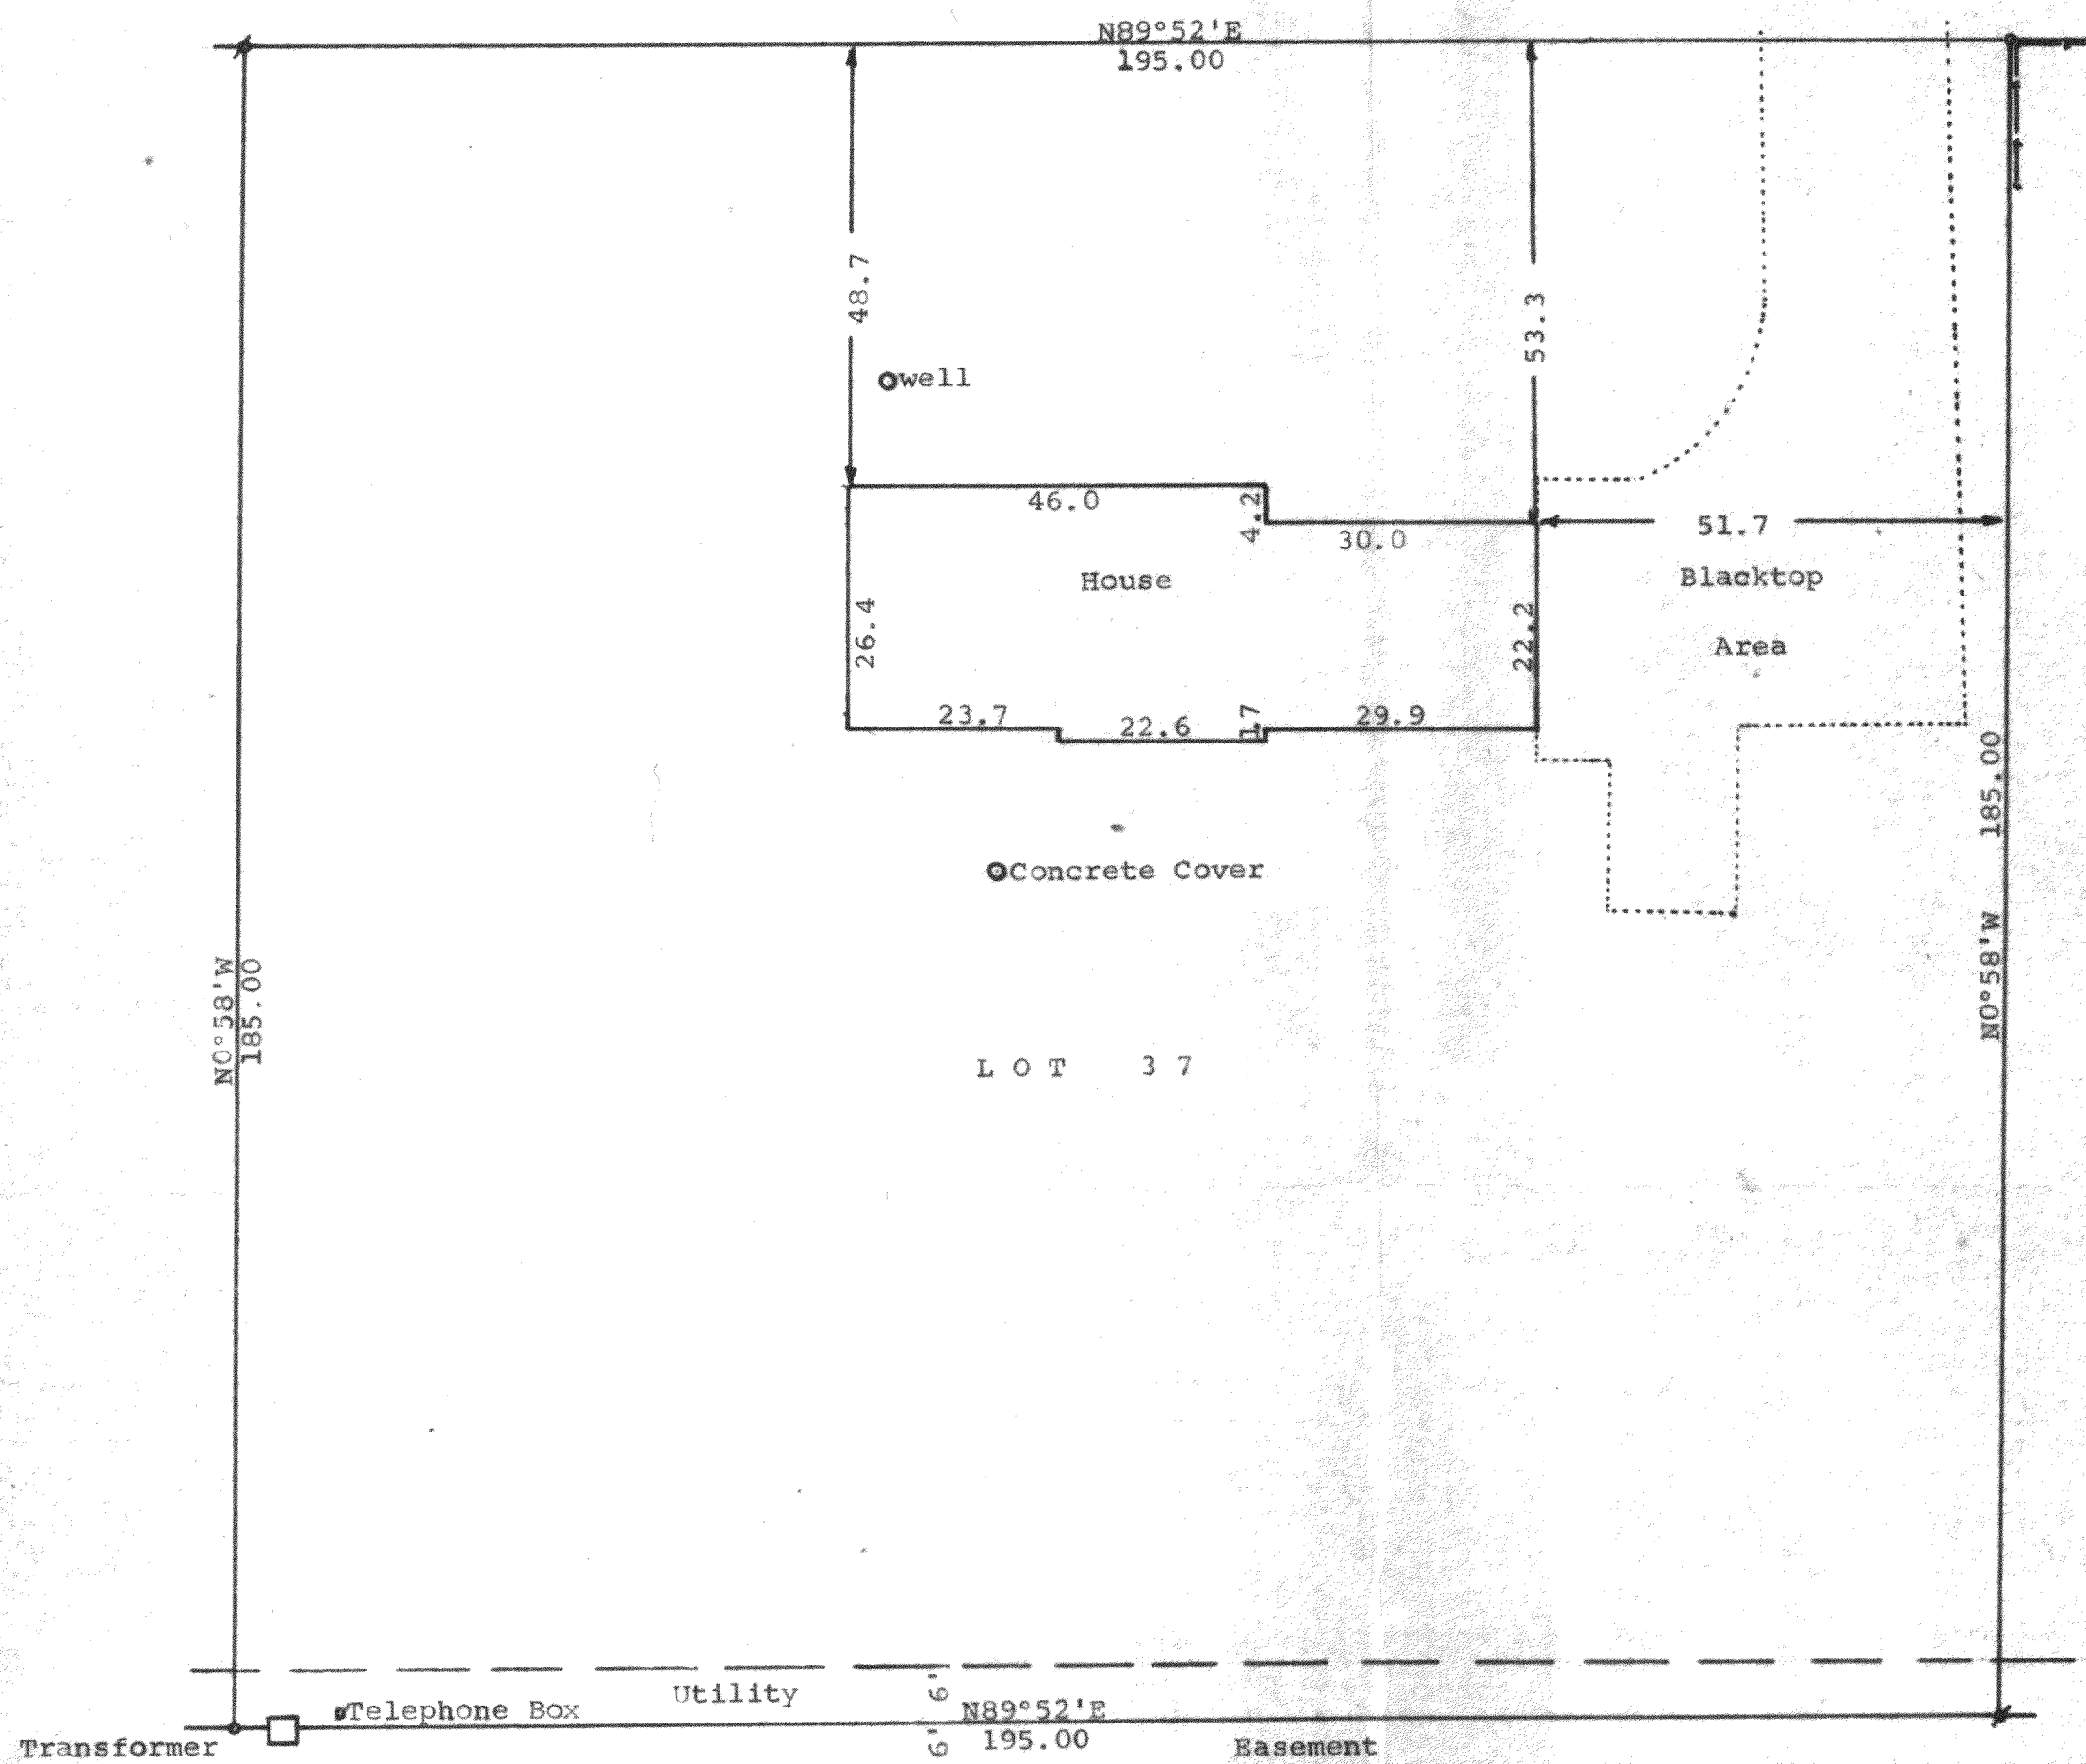

Scale - 1" = 20'
● = 3/4" Iron Pipe Found
⦿ = 3/4" Iron Pipe Found bent,
reset at correct corner
--- = fence line
Bearings are those on the recorded
plat
Survey ordered by:
Carmin Realtors
537 Laurel Heights
Delaver, WI 53115

STATE OF WISCONSIN)
COUNTY OF WALWORTH)

I, George T. Dunham, Surveyor, certify that I have surveyed the
property described as follows:

Lot 37, Charl-Mar Subdivision located in the Northwest 1/4 of the
Northeast 1/4 of Section 1, T 3 N, R 16 E, Walworth County, Wis-
consin,

and that the map shown above is a true representation thereof and shows the
size and location of the property, its exterior boundaries, the location of
all visible structures and dimensions of all principal buildings thereon,
boundary fences, apparent easements, roadways and visible encroachments, if
any, and that I have surveyed the property hereon described according to the
official records to the best of my knowledge and belief.

April 8, 1986

George T. Dunham
George T. Dunham, Surveyor

